
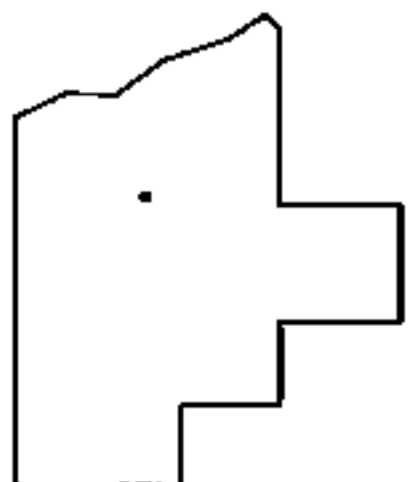
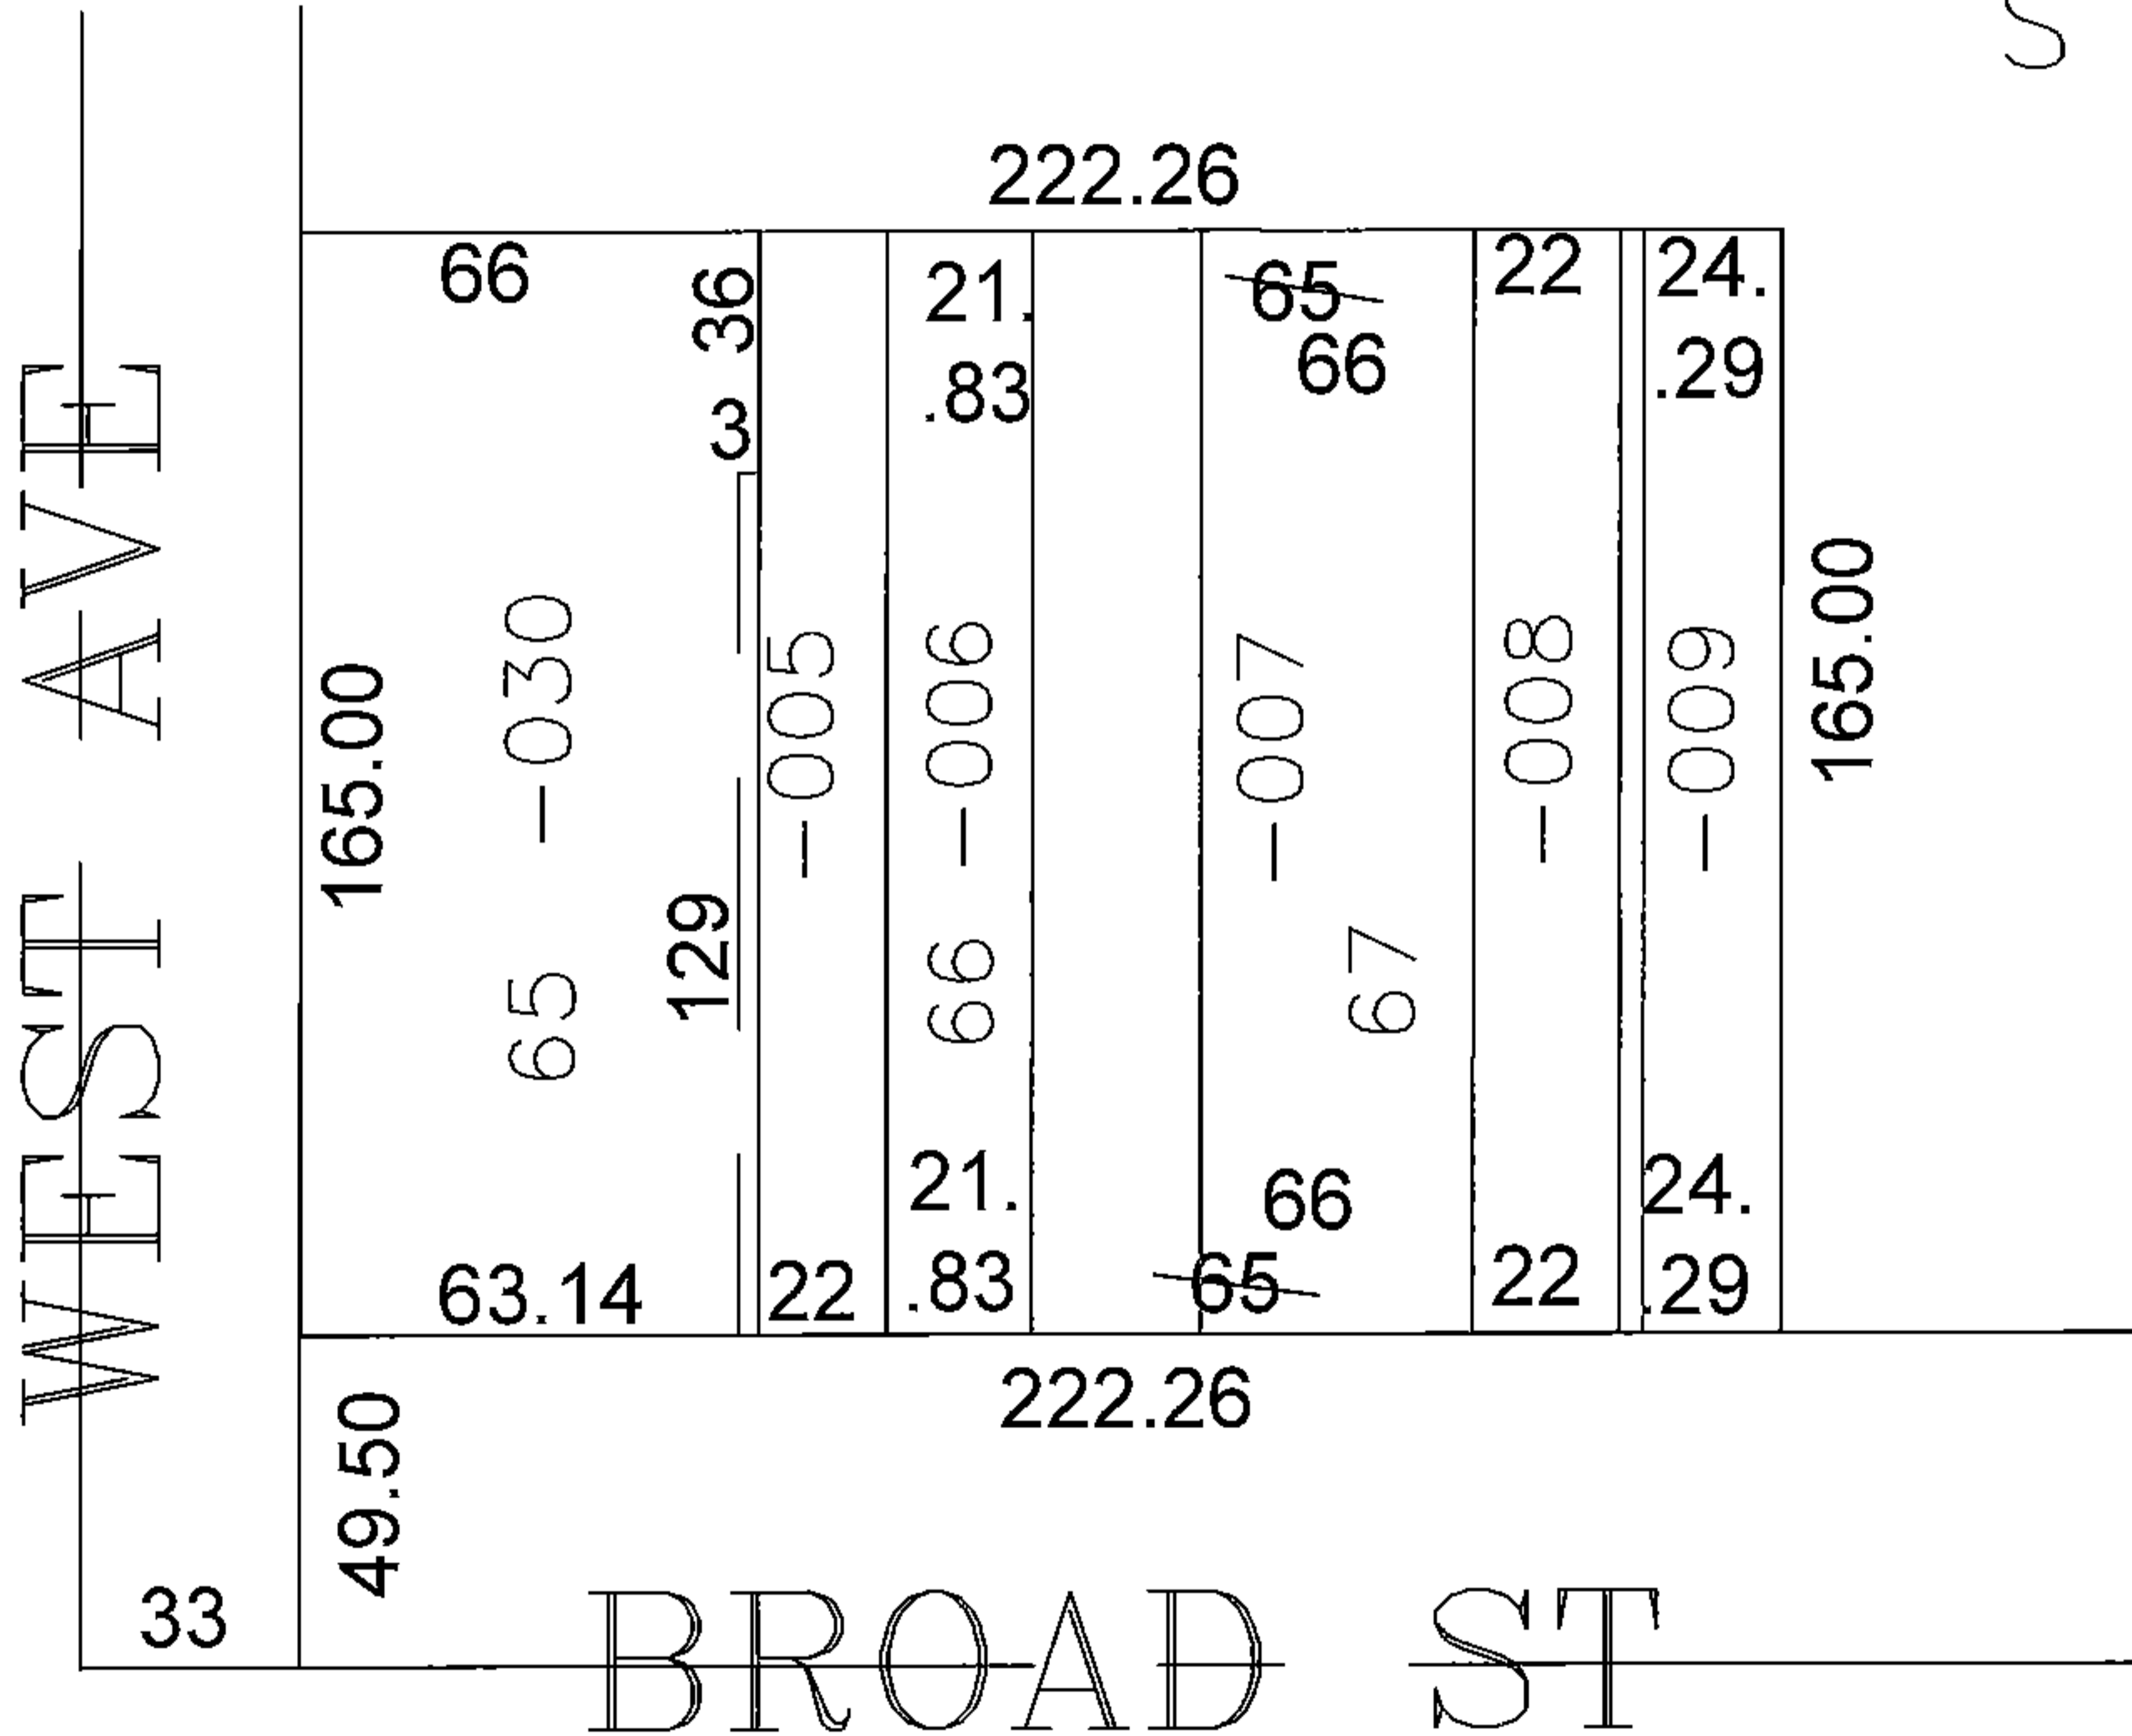


PARENT PARCEL: 06-26-075-000-030, -005 THRU -009

CHILD PARCEL: SAME

STARTING POINT: CENTERLINE OF WEST AVE & BROAD ST

14-03303

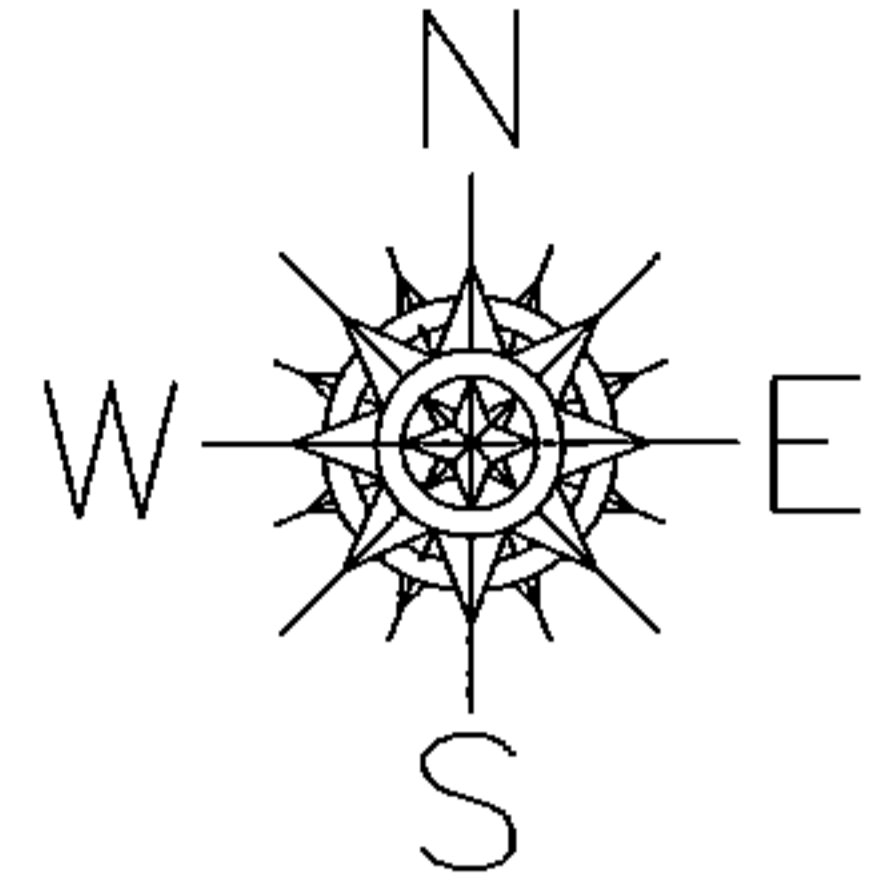

SPLITS/DEEDS PROCESSED

LORAIN COUNTY TAX MAP DEPARTMENT  
226 MIDDLE AVE. ELYRIA, OHIO

SURVEYED BY: MICHAEL ACKERMAN

CLOSURE: 0.00 : 10,000

MAP PAGE(S): 6-119

APPROVED BY: JAH DATE: 11/5/2014

SCALE: 1"= 50' PRIOR INST.: 19910122449