
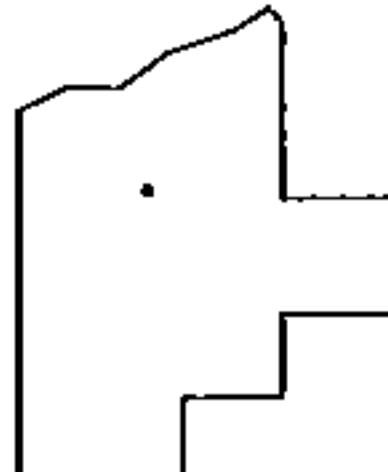
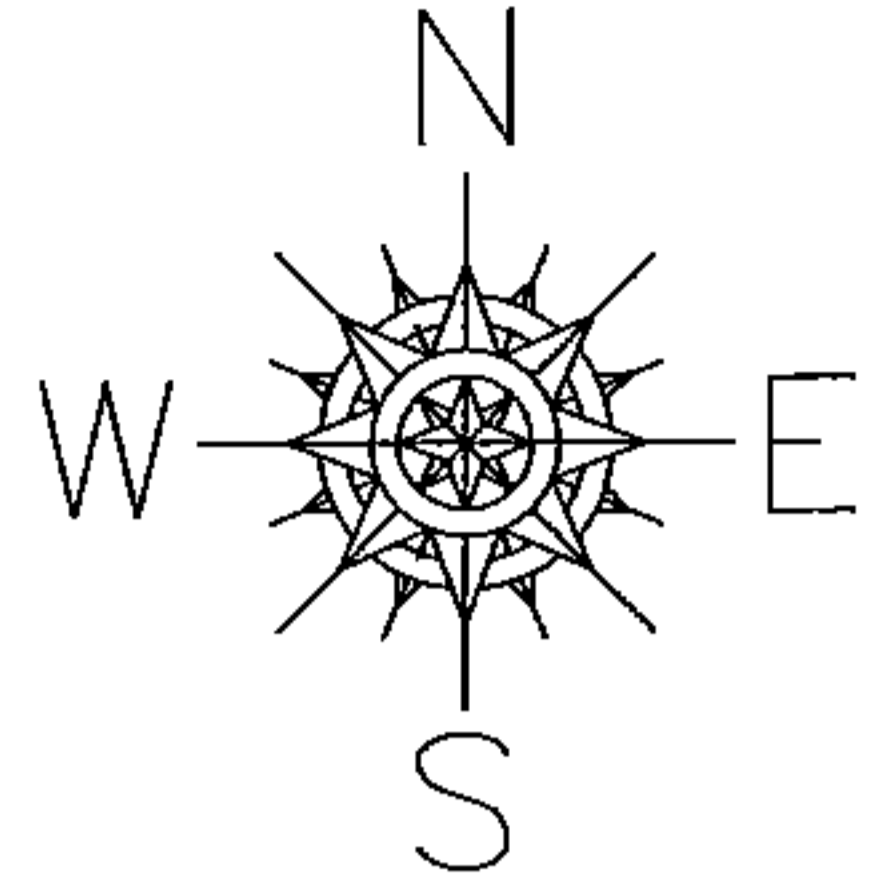


PARENT PARCEL: 08-12-019-000-015 08-12-002-000-015

CHILD PARCEL: SAME

STARTING POINT: CENTERLINE OF ST RT 511 & BAUMHART RD

14-03304

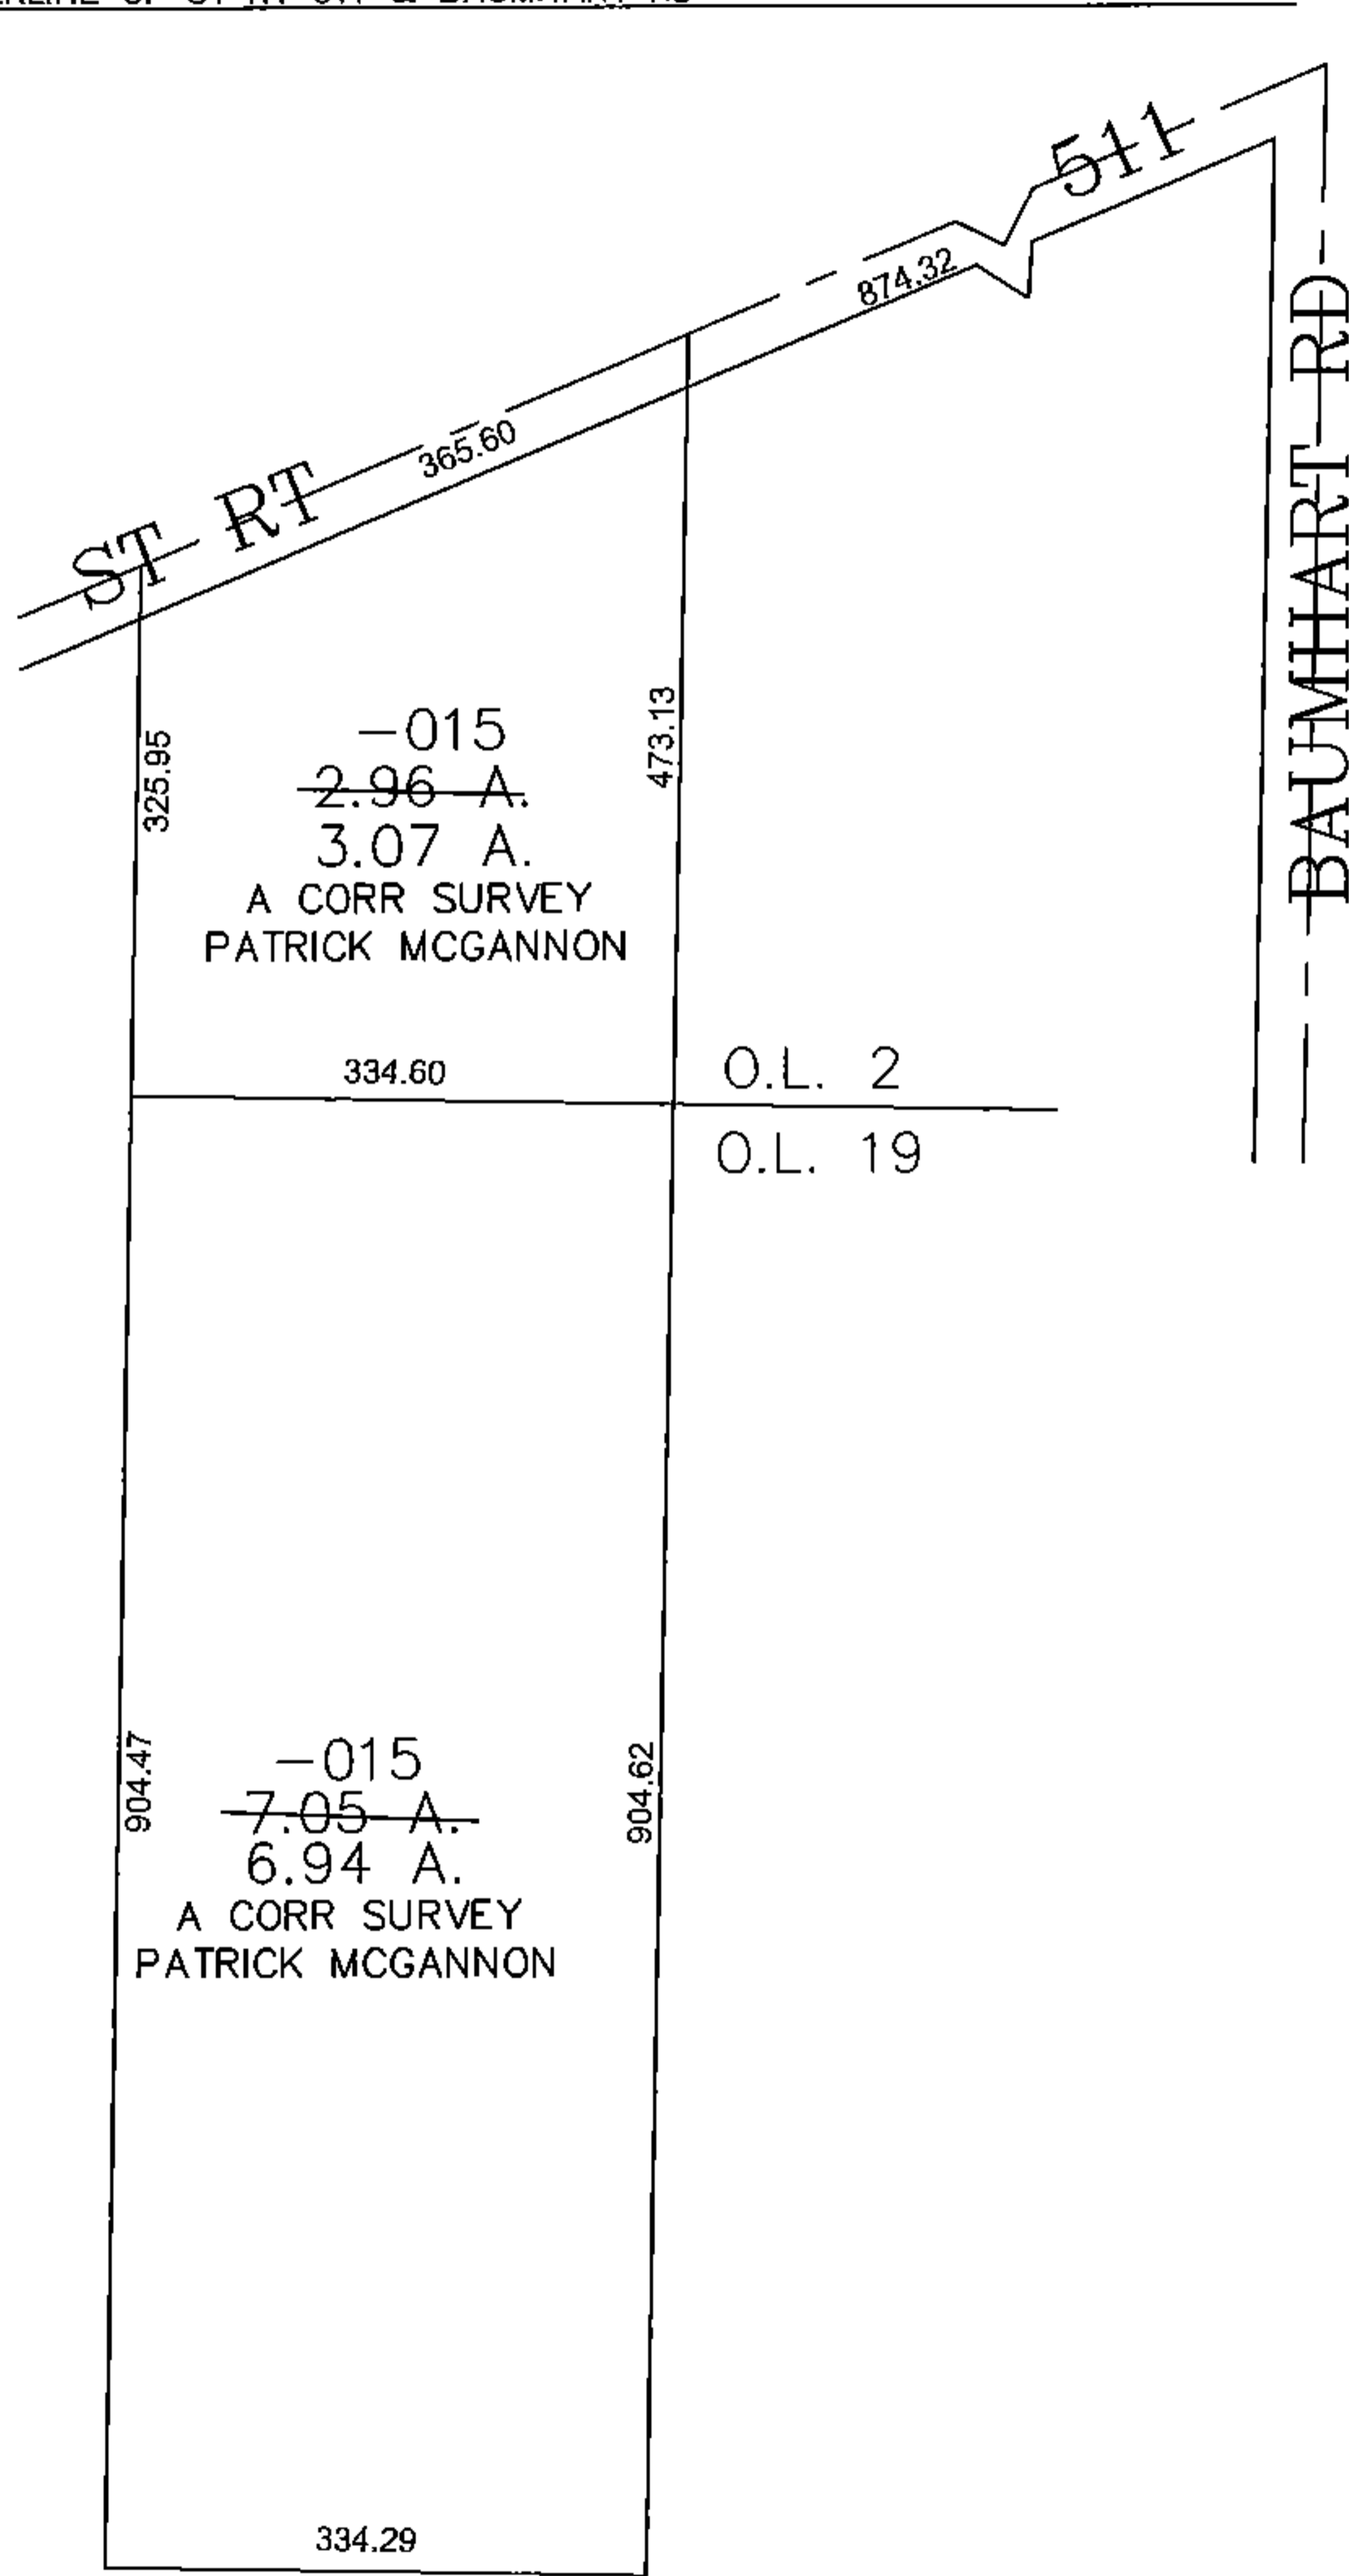

SPLITS/DEEDS PROCESSED

LORAIN COUNTY TAX MAP DEPARTMENT
 226 MIDDLE AVE. ELYRIA, OHIO

SURVEYED BY: PATRICK MCGANNON
 CLOSURE: 0.00 : 10.000
 MAP PAGE(S): 8-H
 APPROVED BY: JAH DATE: 11/7/2014
 SCALE: 1" = 200' PRIOR INSTRUMENT: 20130453867