
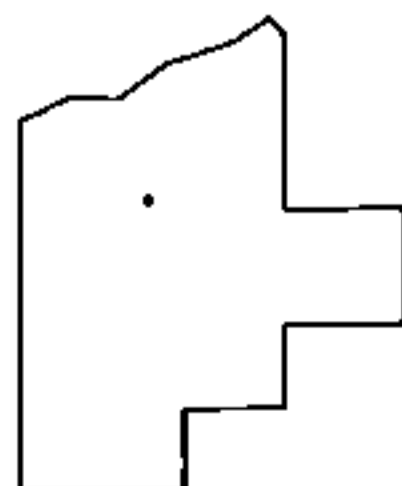
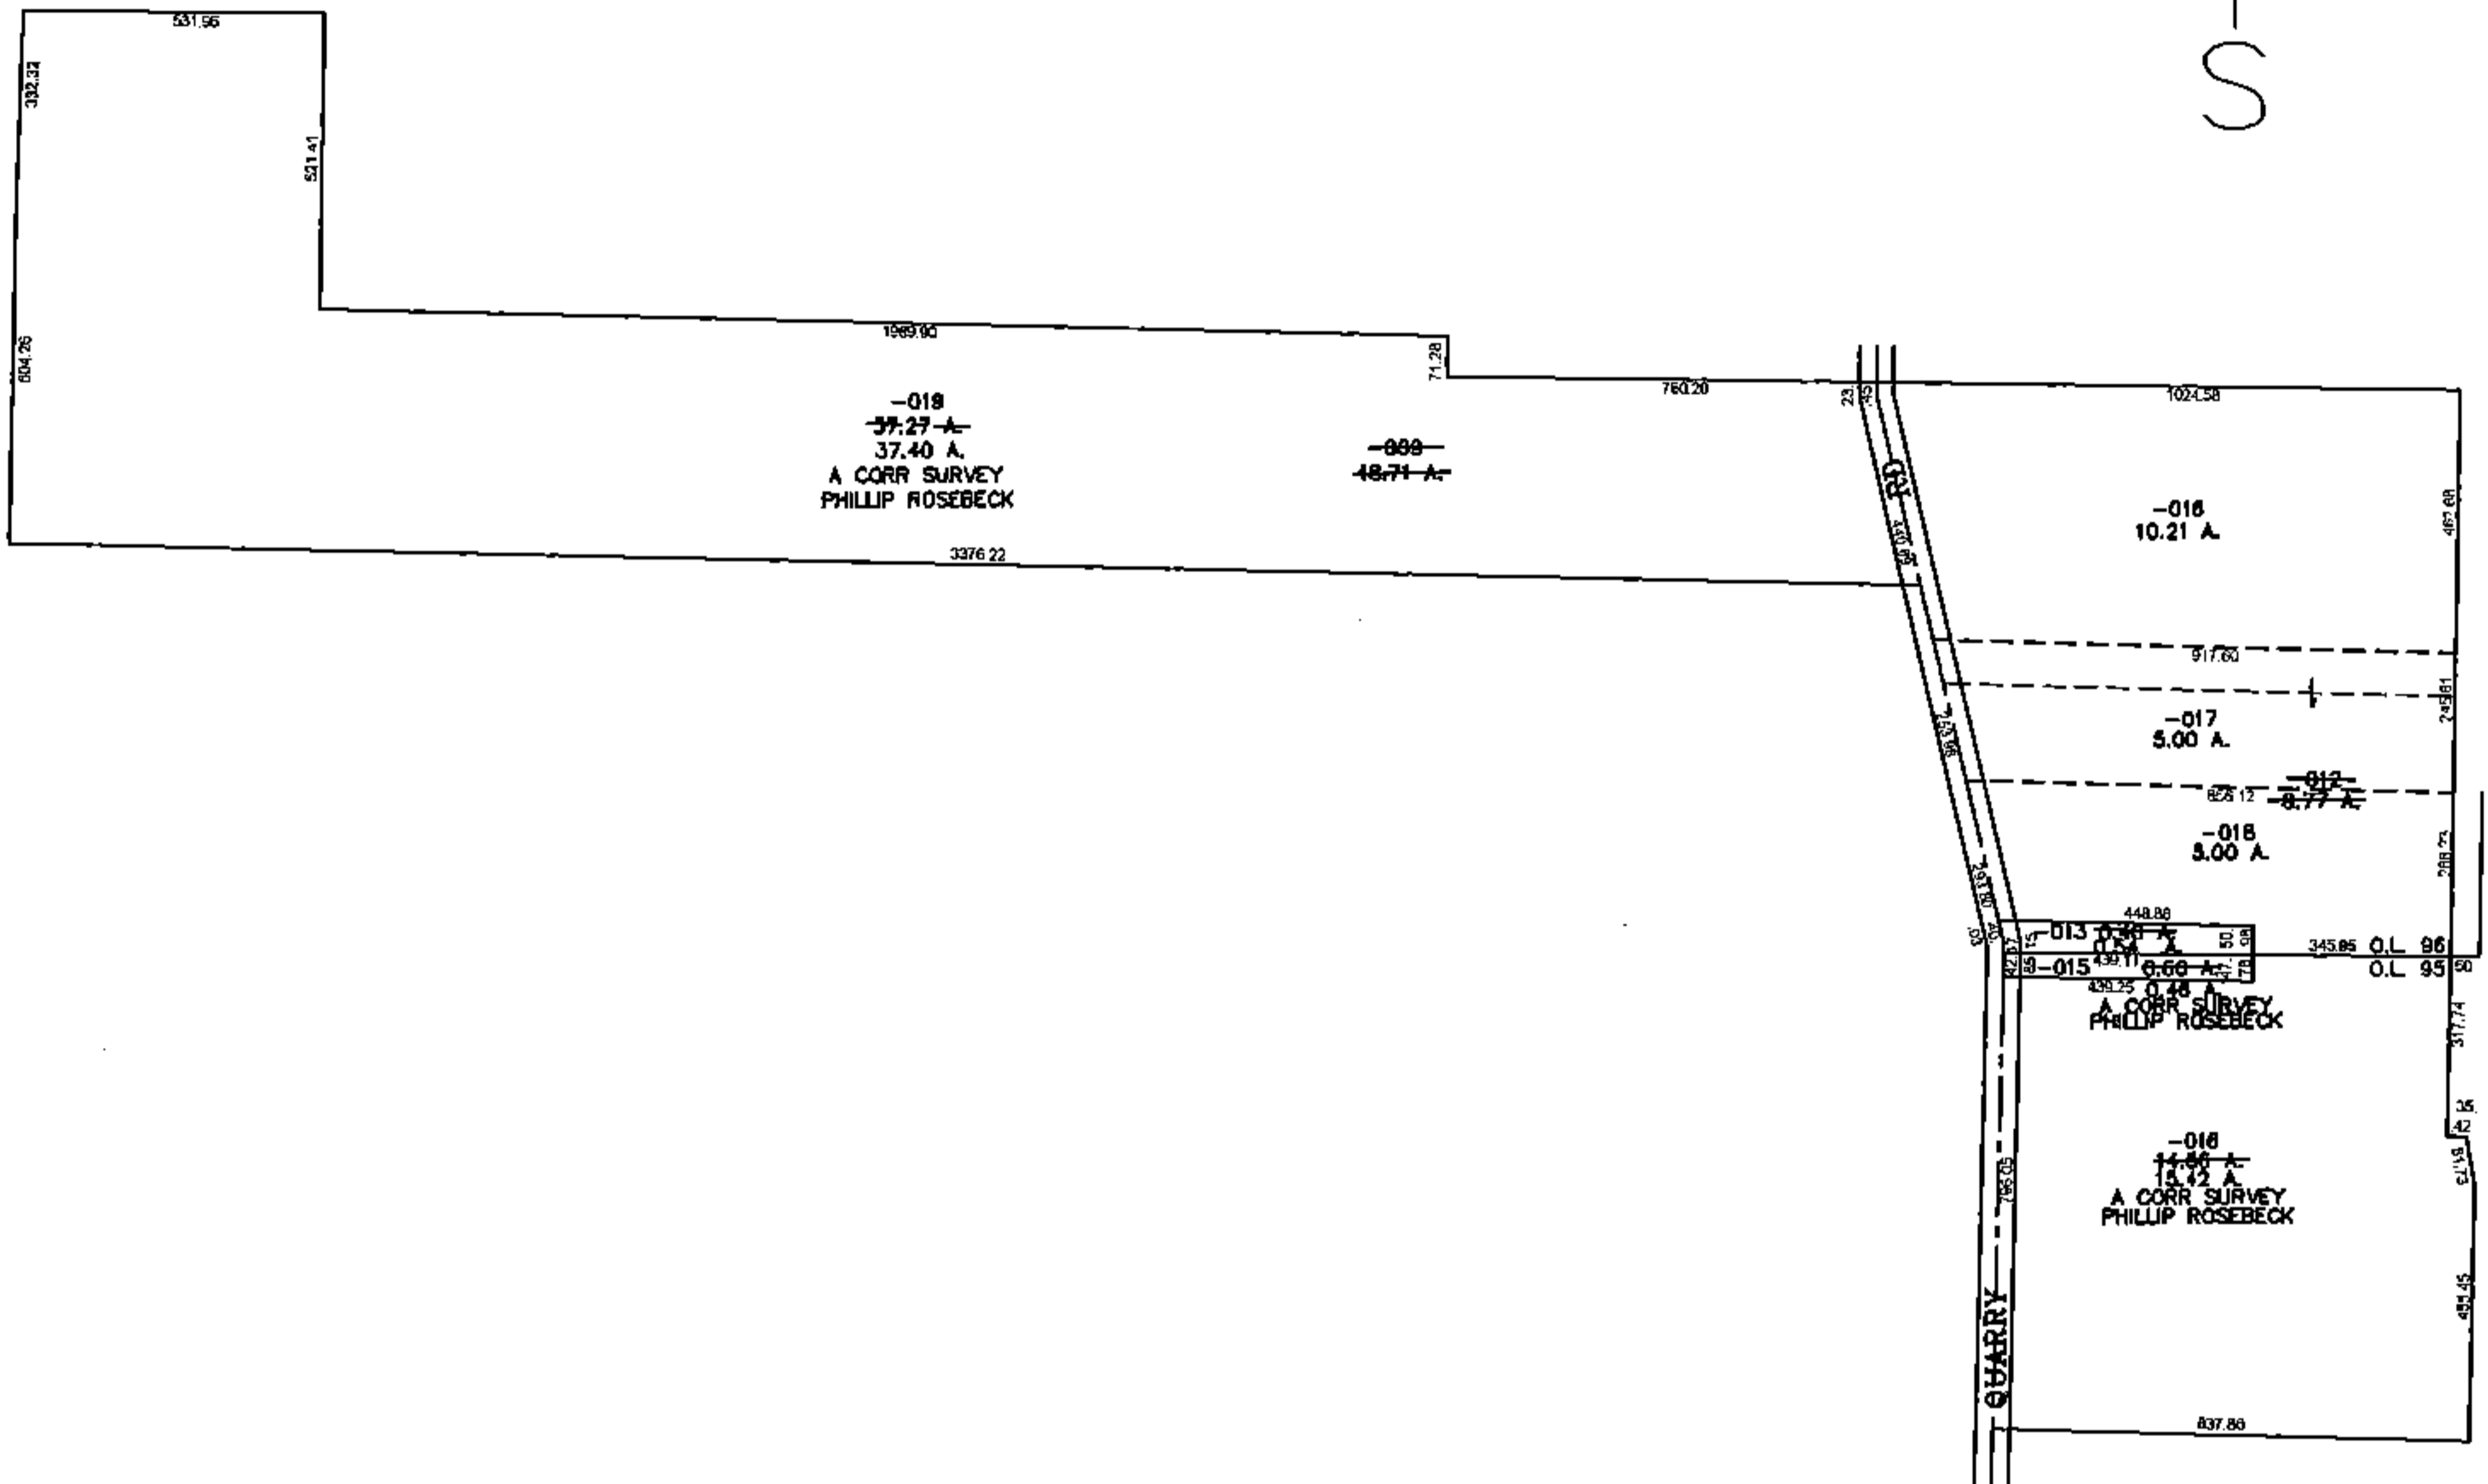


PARENT PARCEL: 05-00-096-000-009, -012 05-00-095-000-016, -015
CHILD PARCEL: 05-00-096-000-016 THRU -019
STARTING POINT: SOUTHEASTERLY CORNER OF O.L. 96

14-03305

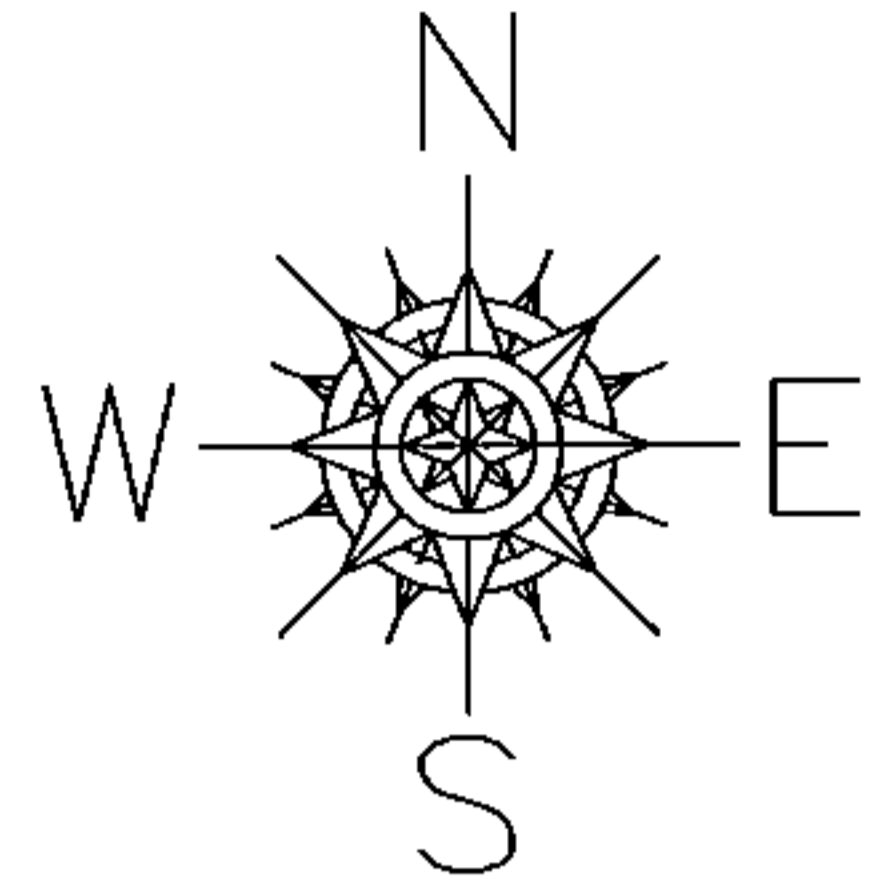

SPLITS/DEEDS PROCESSED

LORAIN COUNTY TAX MAP DEPARTMENT
226 MIDDLE AVE. ELYRIA, OHIO

SURVEYED BY: PHILLIP ROSEBECK
CLOSURE: 0.00 : 10.000
MAP PAGE(S): 5-A
APPROVED BY: JAH DATE: 11/7/2014
SCALE: 1" = 600 PRIOR INSTRUMENT: 20130452616