
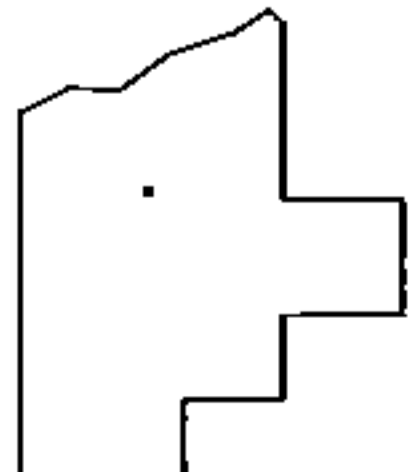
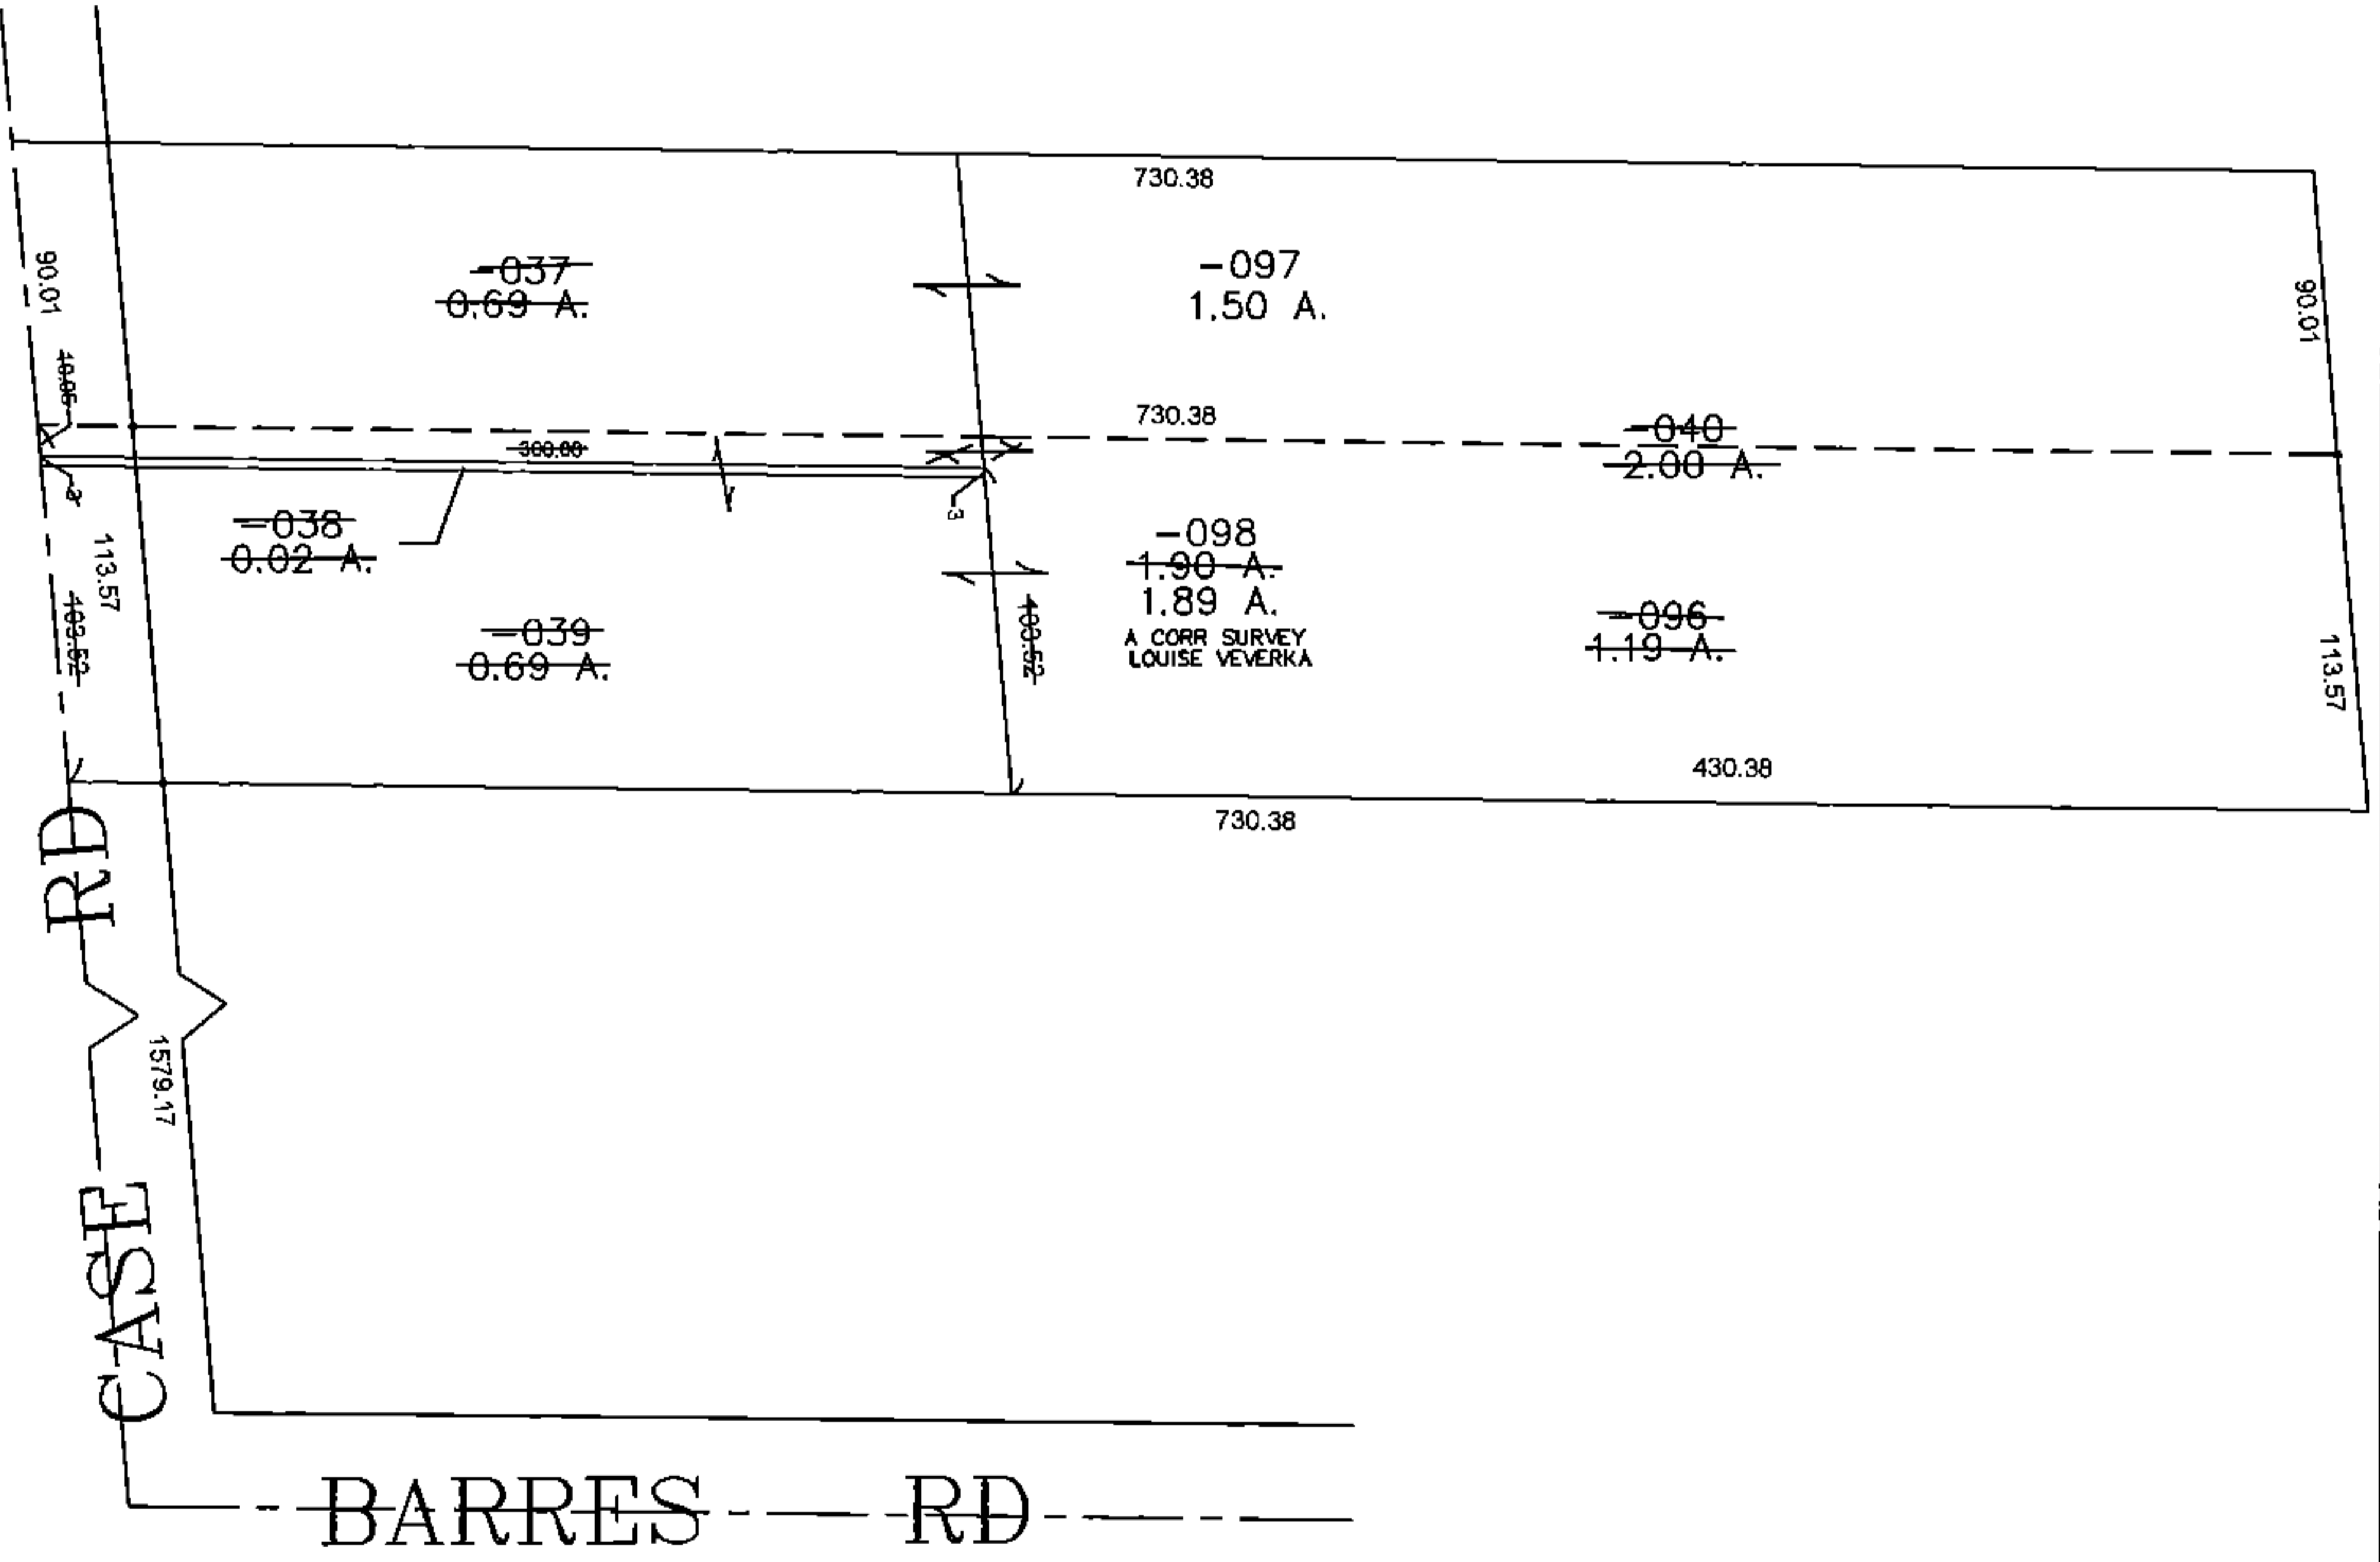


PARENT PARCEL: 07-00-043-103-038, -040, -039, -037

CHILD PARCEL: 07-00-043-103-096 THRU -099

STARTING POINT: CENTERLINE OF CASE RD & BARRES RD.

14-03306

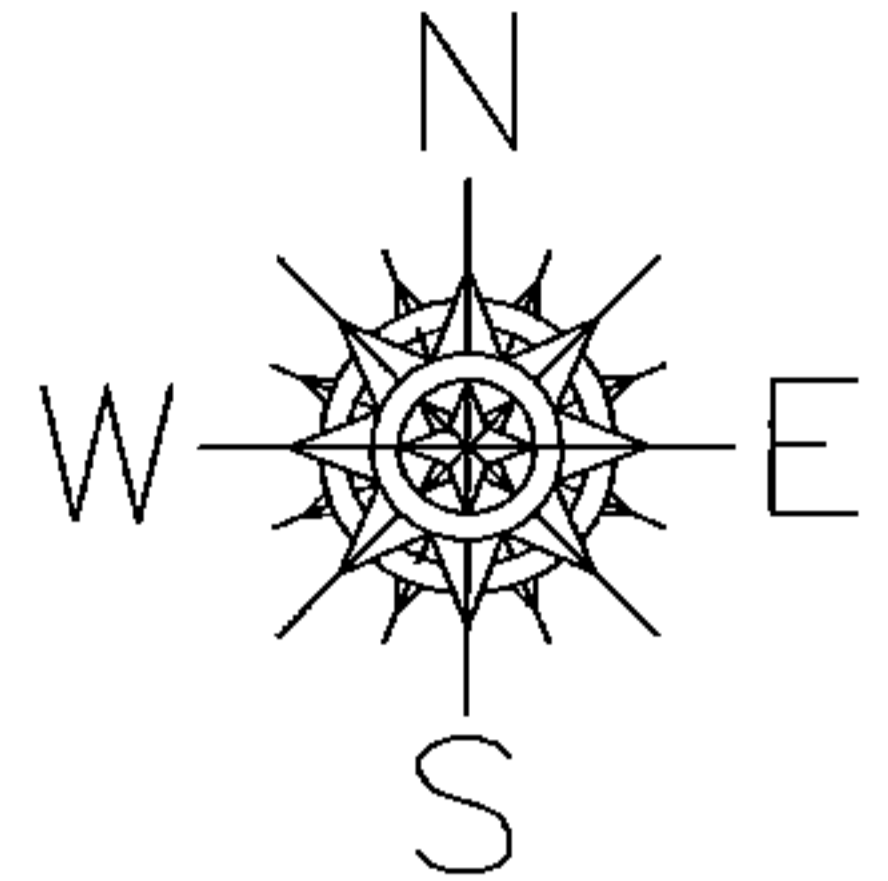

**SPLITS/DEEDS PROCESSED**  
LORAIN COUNTY TAX MAP DEPARTMENT  
226 MIDDLE AVE. ELYRIA, OHIO

SURVEYED BY: LOUISE VEVERKA  
CLOSURE: 0.00 : 10.000  
MAP PAGE(S): 07-00-043-C  
APPROVED BY: TJS DATE: 11/7/2014  
SCALE: 1" = 100 PRIOR INSTRUMENT: 20140500926