

PARENT PARCEL: 07-00-008-117-037

CHILD PARCEL: XX-XX-XXX-XXX-XXX

STARTING POINT: P.K. NAIL, CL OF CENTER RIDGE RD. & CL OF LEAR NAGLE RD.

15-03308-A




ACREAGE CORRECTION

07-00-008-117-037

~~3.83~~ A.

4.20 A.

CORR. PER SURV.
M. YEAGER

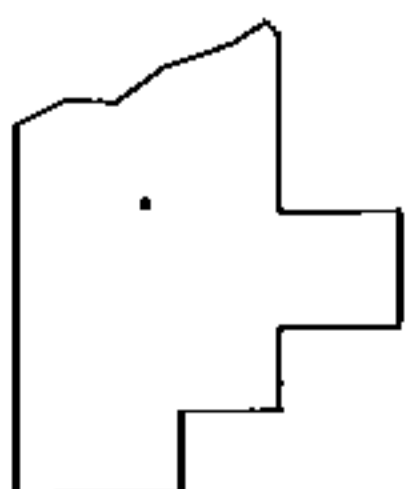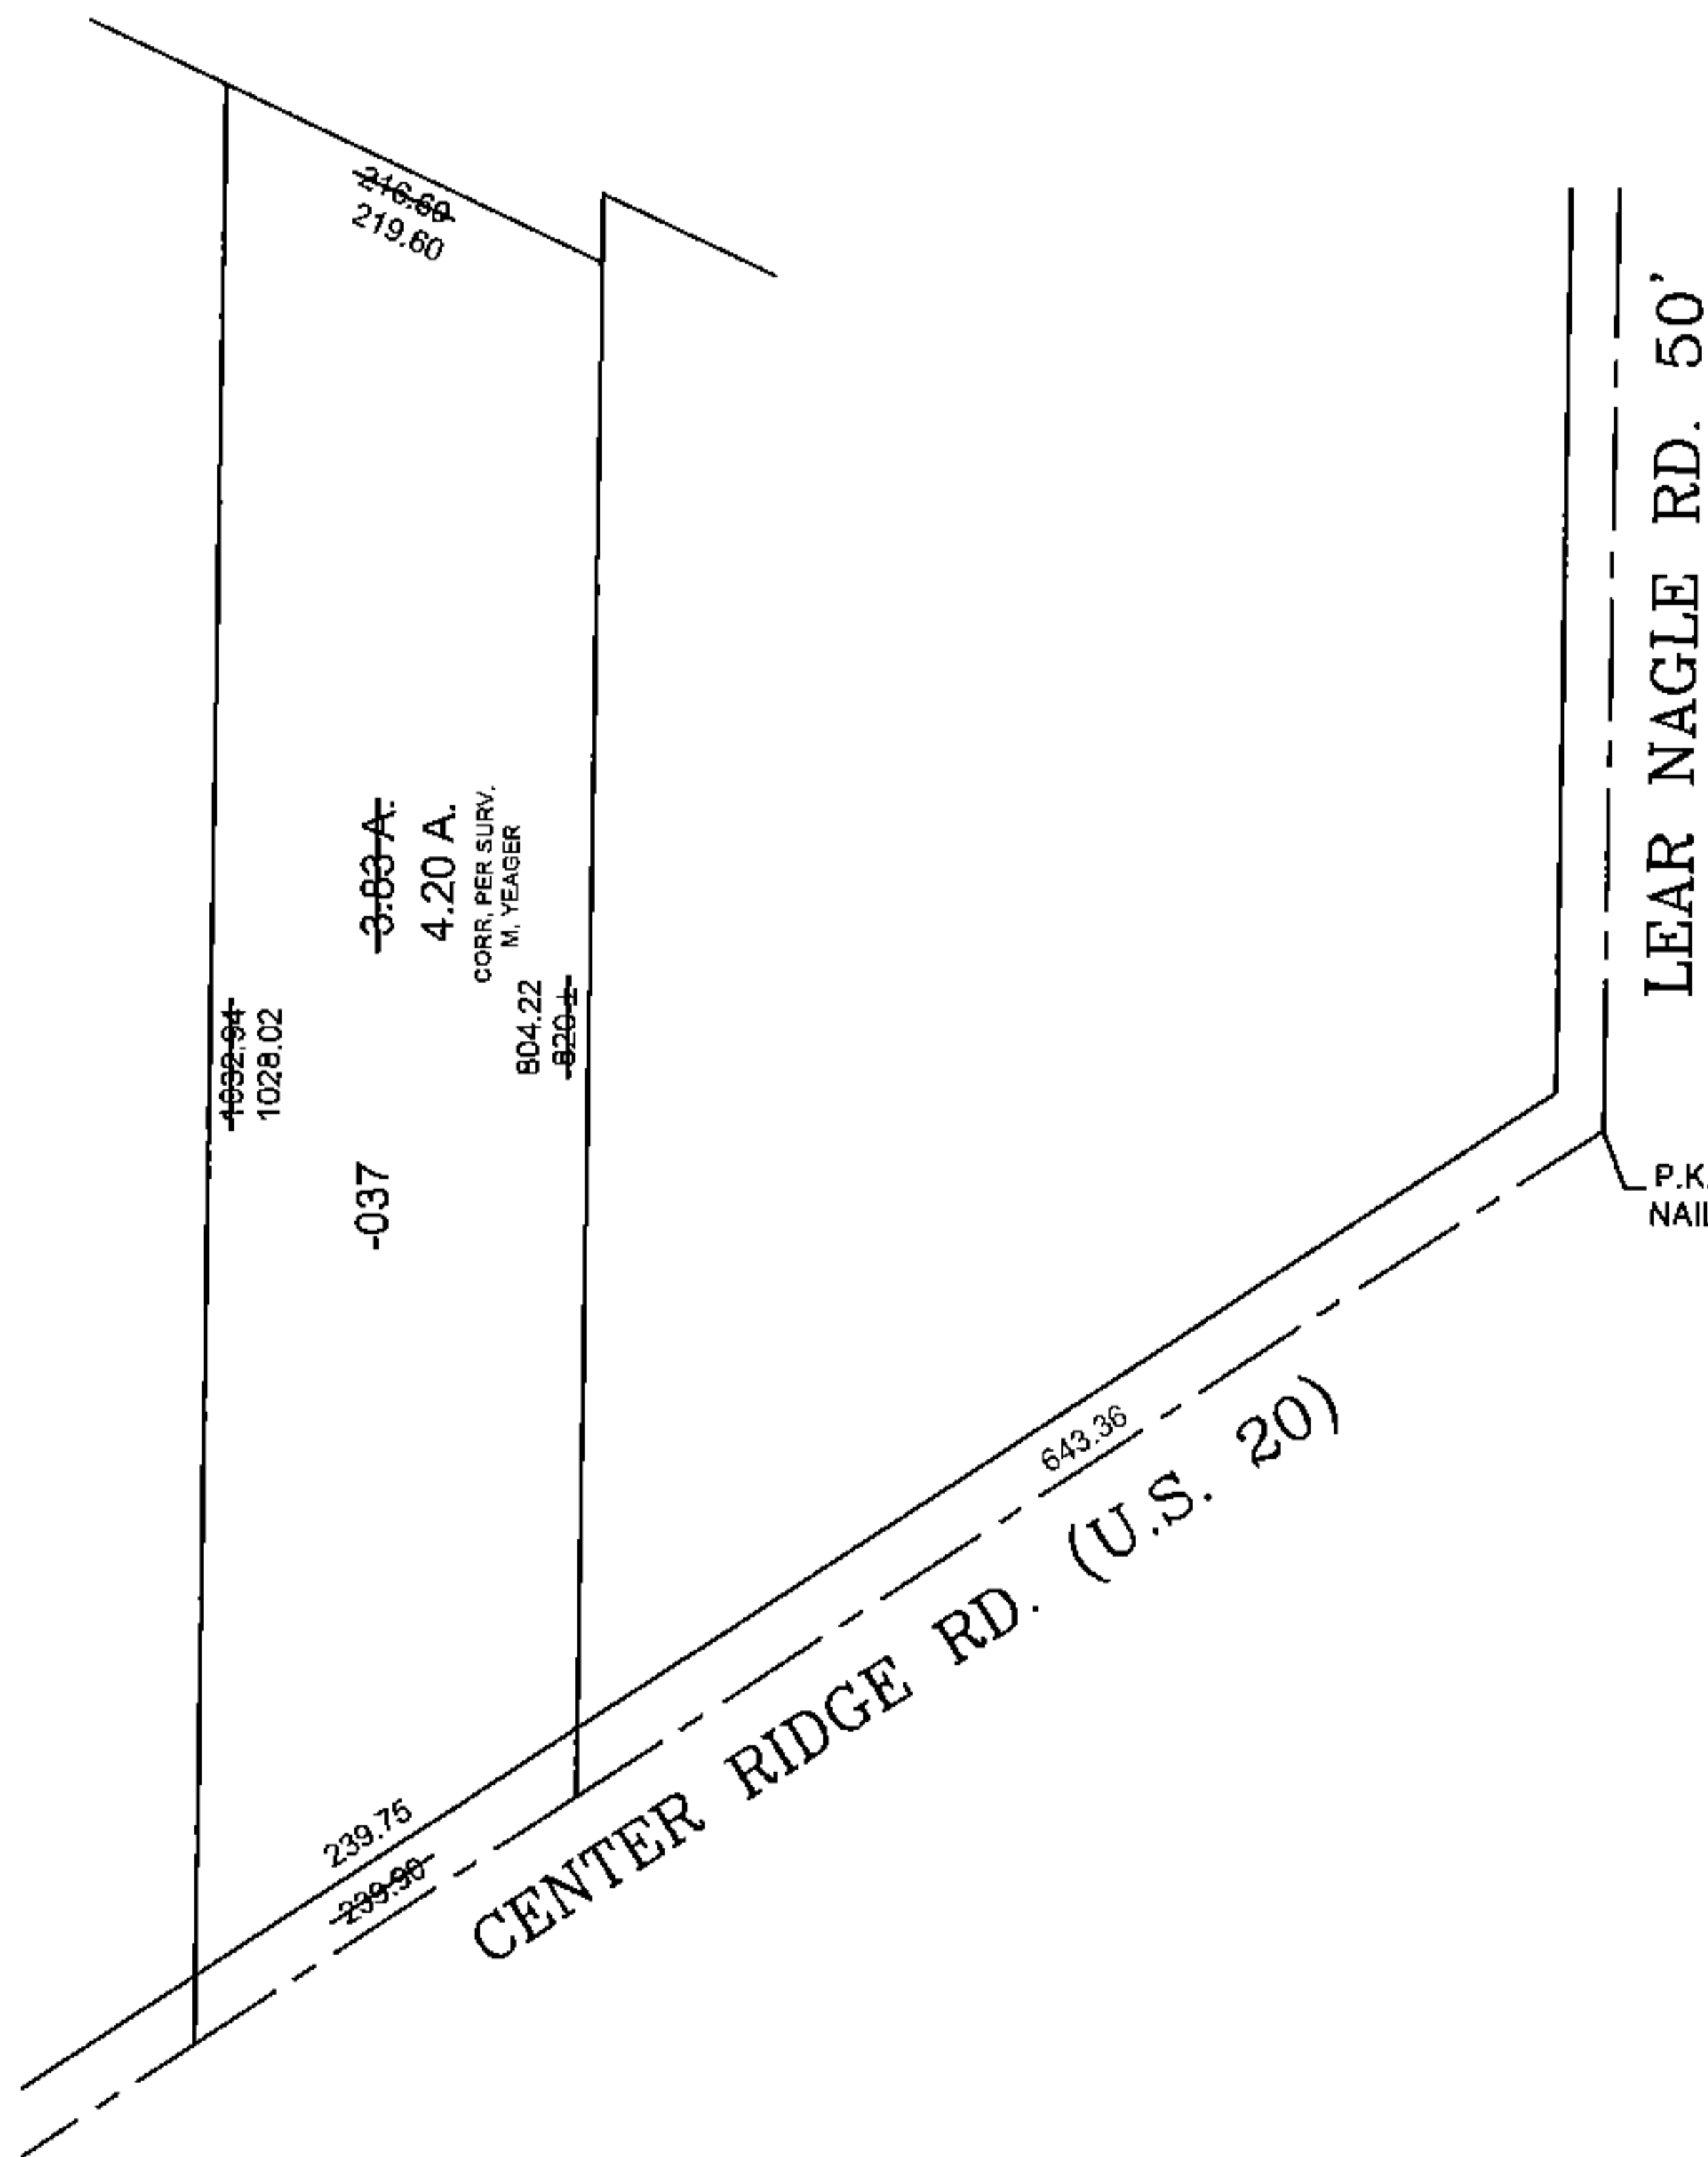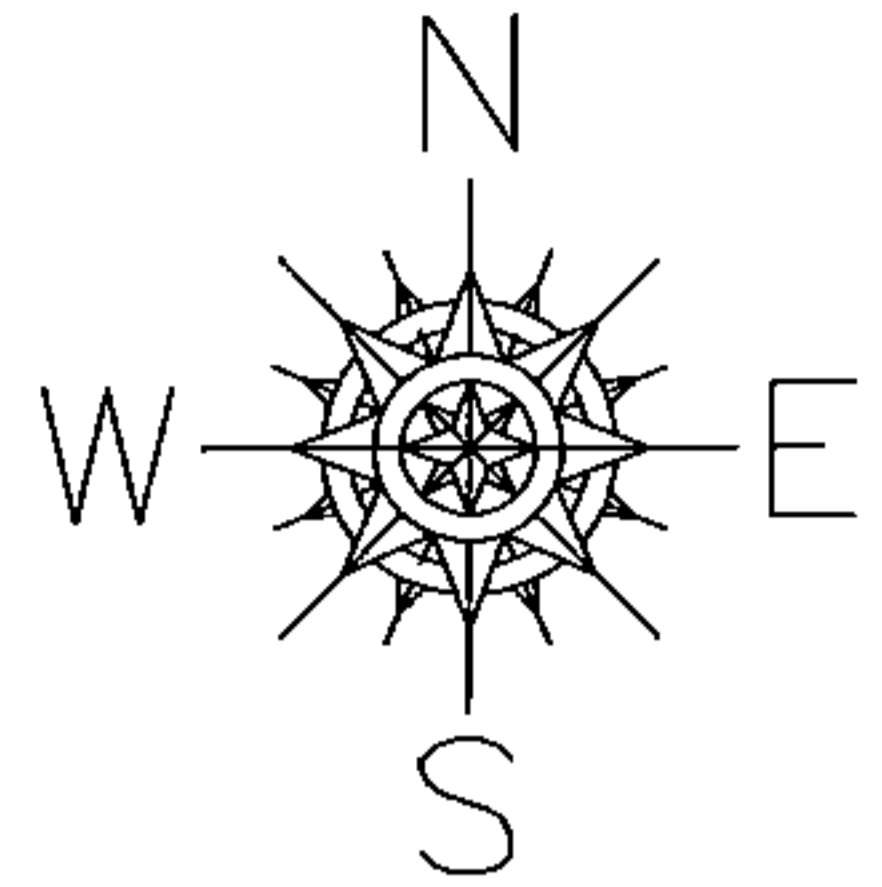

SPLITS/DEEDS PROCESSED

LORAIN COUNTY TAX MAP DEPARTMENT
226 MIDDLE AVE. ELYRIA, OHIO

SURVEYED BY: MARK A. YEAGER

CLOSURE: 0.01 : 10,000

MAP PAGE(S): 07-00-008

APPROVED BY: TJS DATE: 9/30/15

SCALE: 1" = 200 PRIOR INSTRUMENT: 20020814700