


PARENT PARCEL: 06-23-001-103-014, -015



CHILD PARCEL: _____

STARTING POINT: INTERSECTION OF EAST LINE OF O.L.1 AND C/L OF DELLEFIELD RD.

15-03309-A

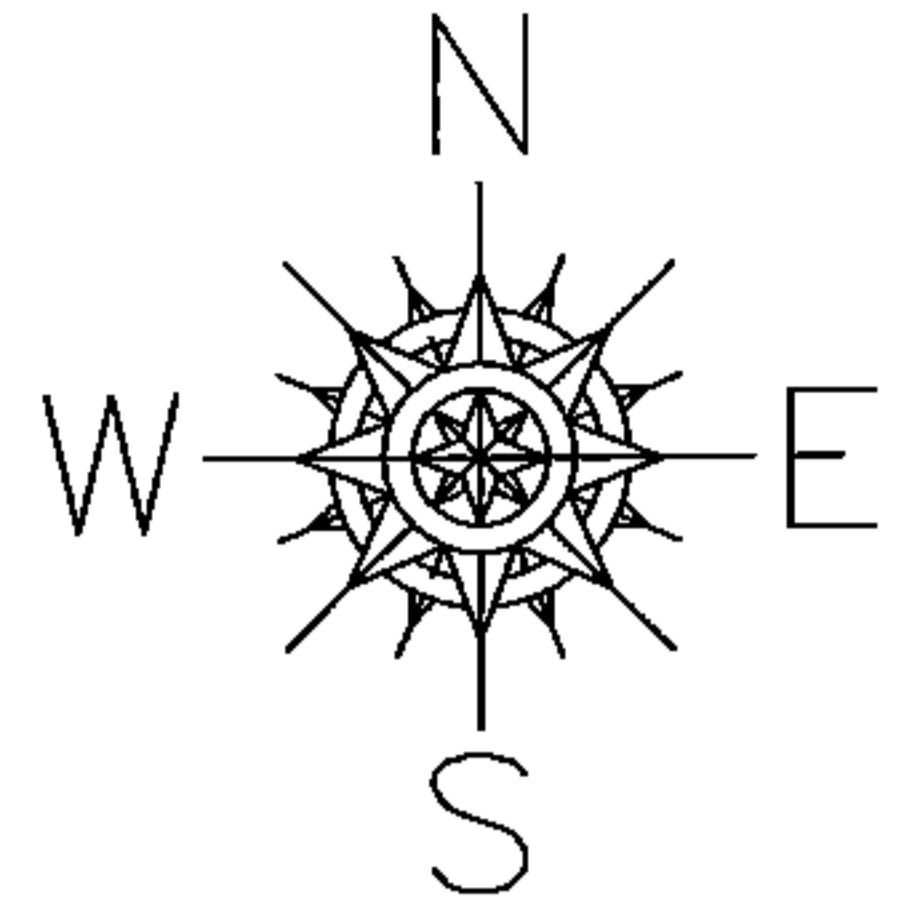

DELLEFIELD RD.

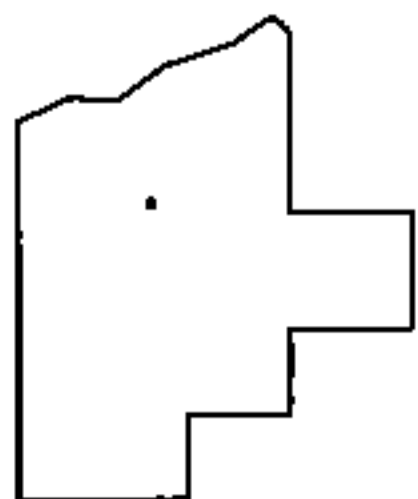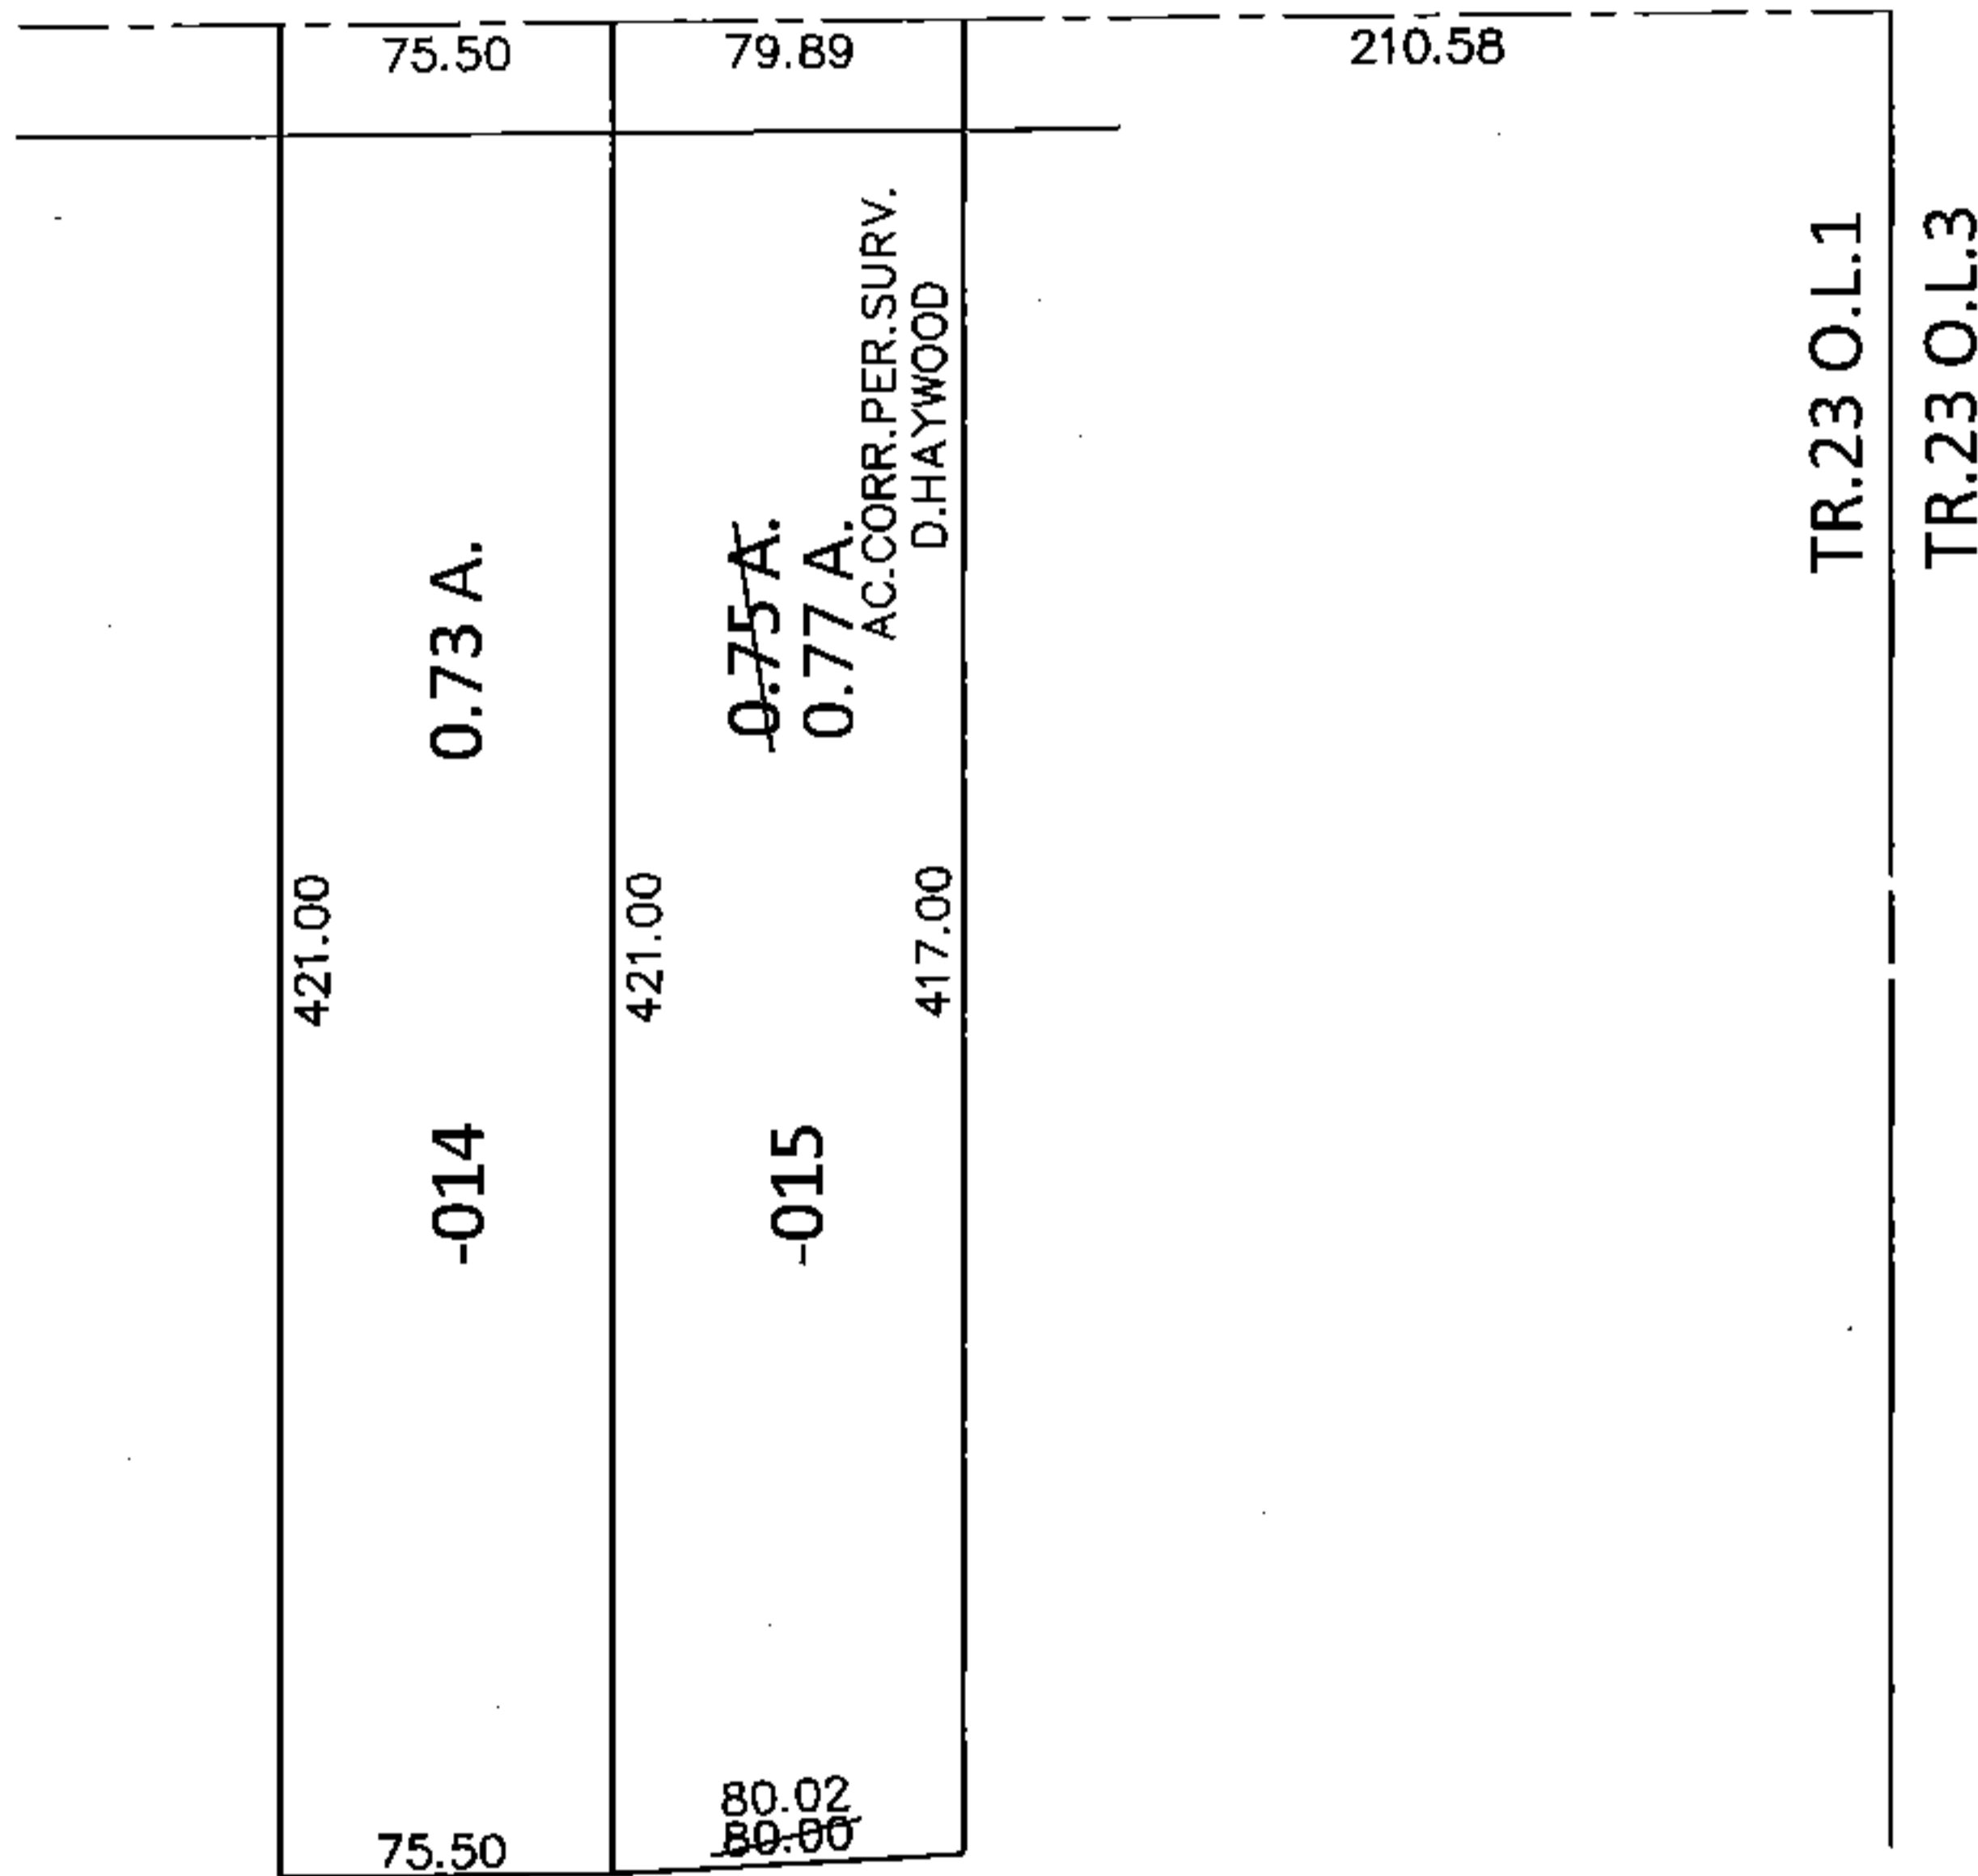

SPLITS/DEEDS PROCESSED

LORAIN COUNTY TAX MAP DEPARTMENT
226 MIDDLE AVE. ELYRIA, OHIO

SURVEYED BY: DALE R. HAYWOOD

CLOSURE: .00:10,000

MAP PAGE(S): 6-20

APPROVED BY: RRM DATE: 9-30-15

SCALE: 1"=100 PRIOR INST.: 20010748608