
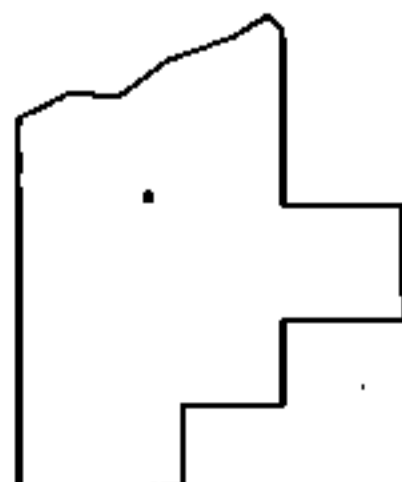
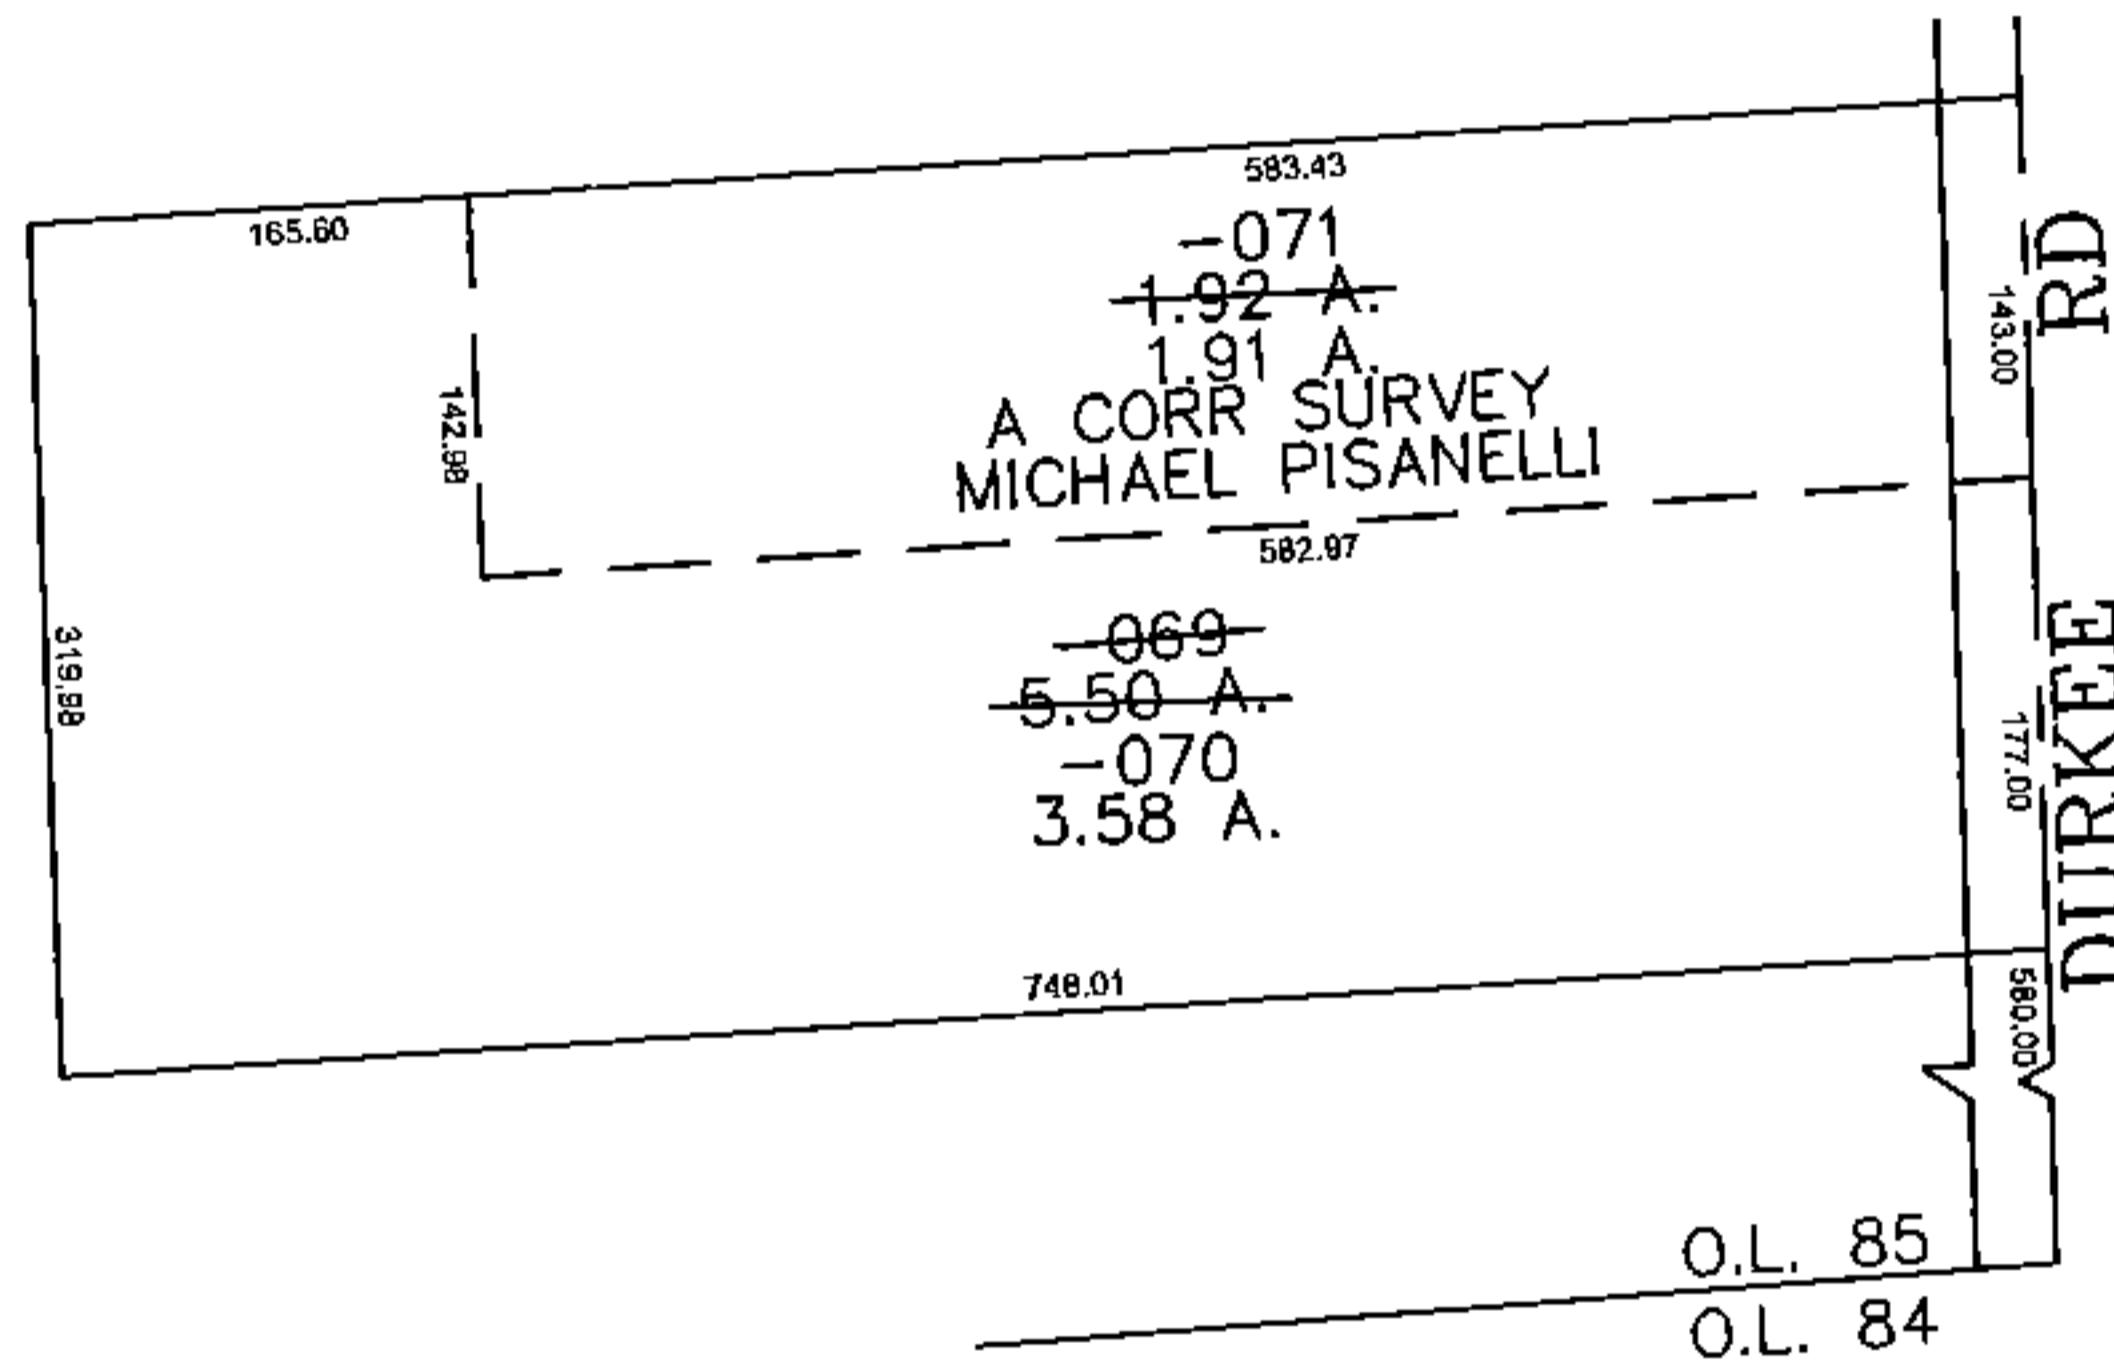


PARENT PARCEL: 11-00-085-000-069

CHILD PARCEL: 11-00-085-000-070, -071

STARTING POINT: CENTERLINE OF DURKEE RD & O.L. 85

14-03310

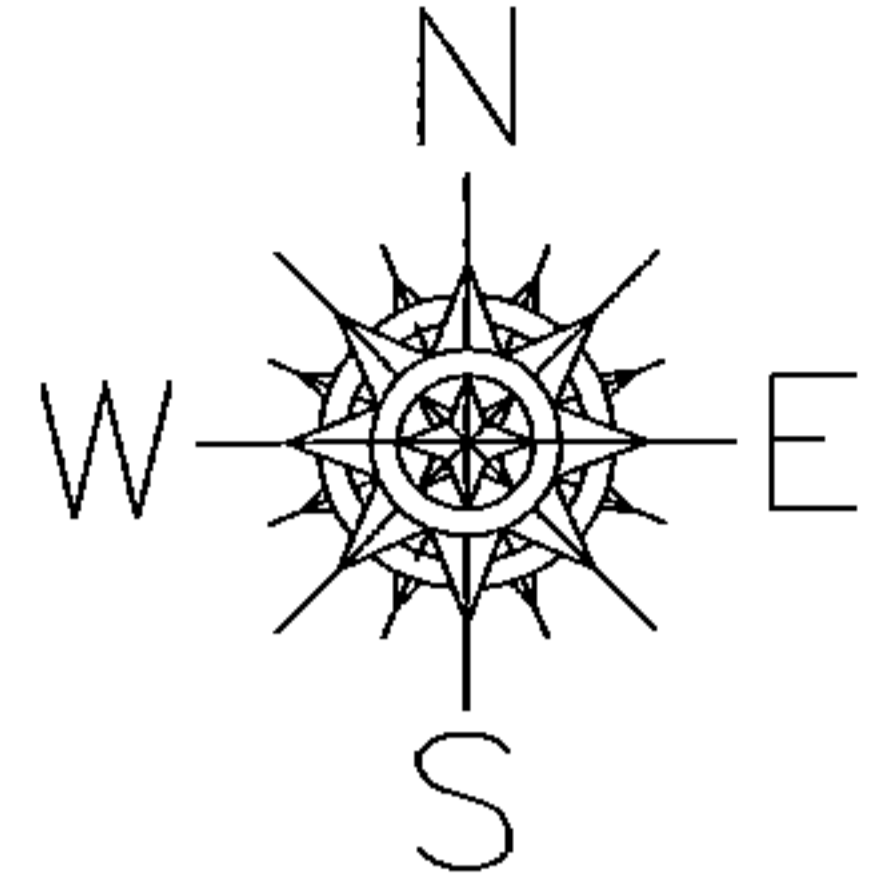

SPLITS/DEEDS PROCESSED
LORAIN COUNTY TAX MAP DEPARTMENT
226 MIDDLE AVE. ELYRIA, OHIO

SURVEYED BY: MICHAEL PISANELLI
CLOSURE: 0.00 : 10.000
MAP PAGE(S): 11-E NORTH
APPROVED BY: JAH DATE: 11/12/2014
SCALE: 1" = 200 PRIOR INSTRUMENT: 2005070147