
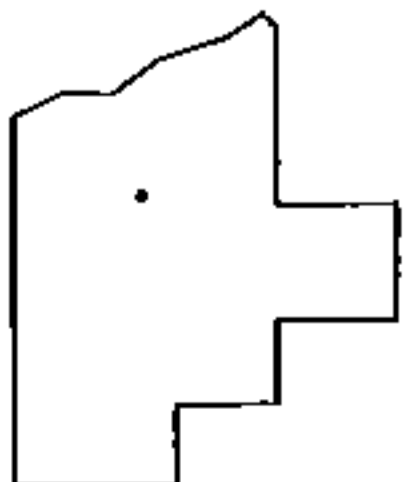
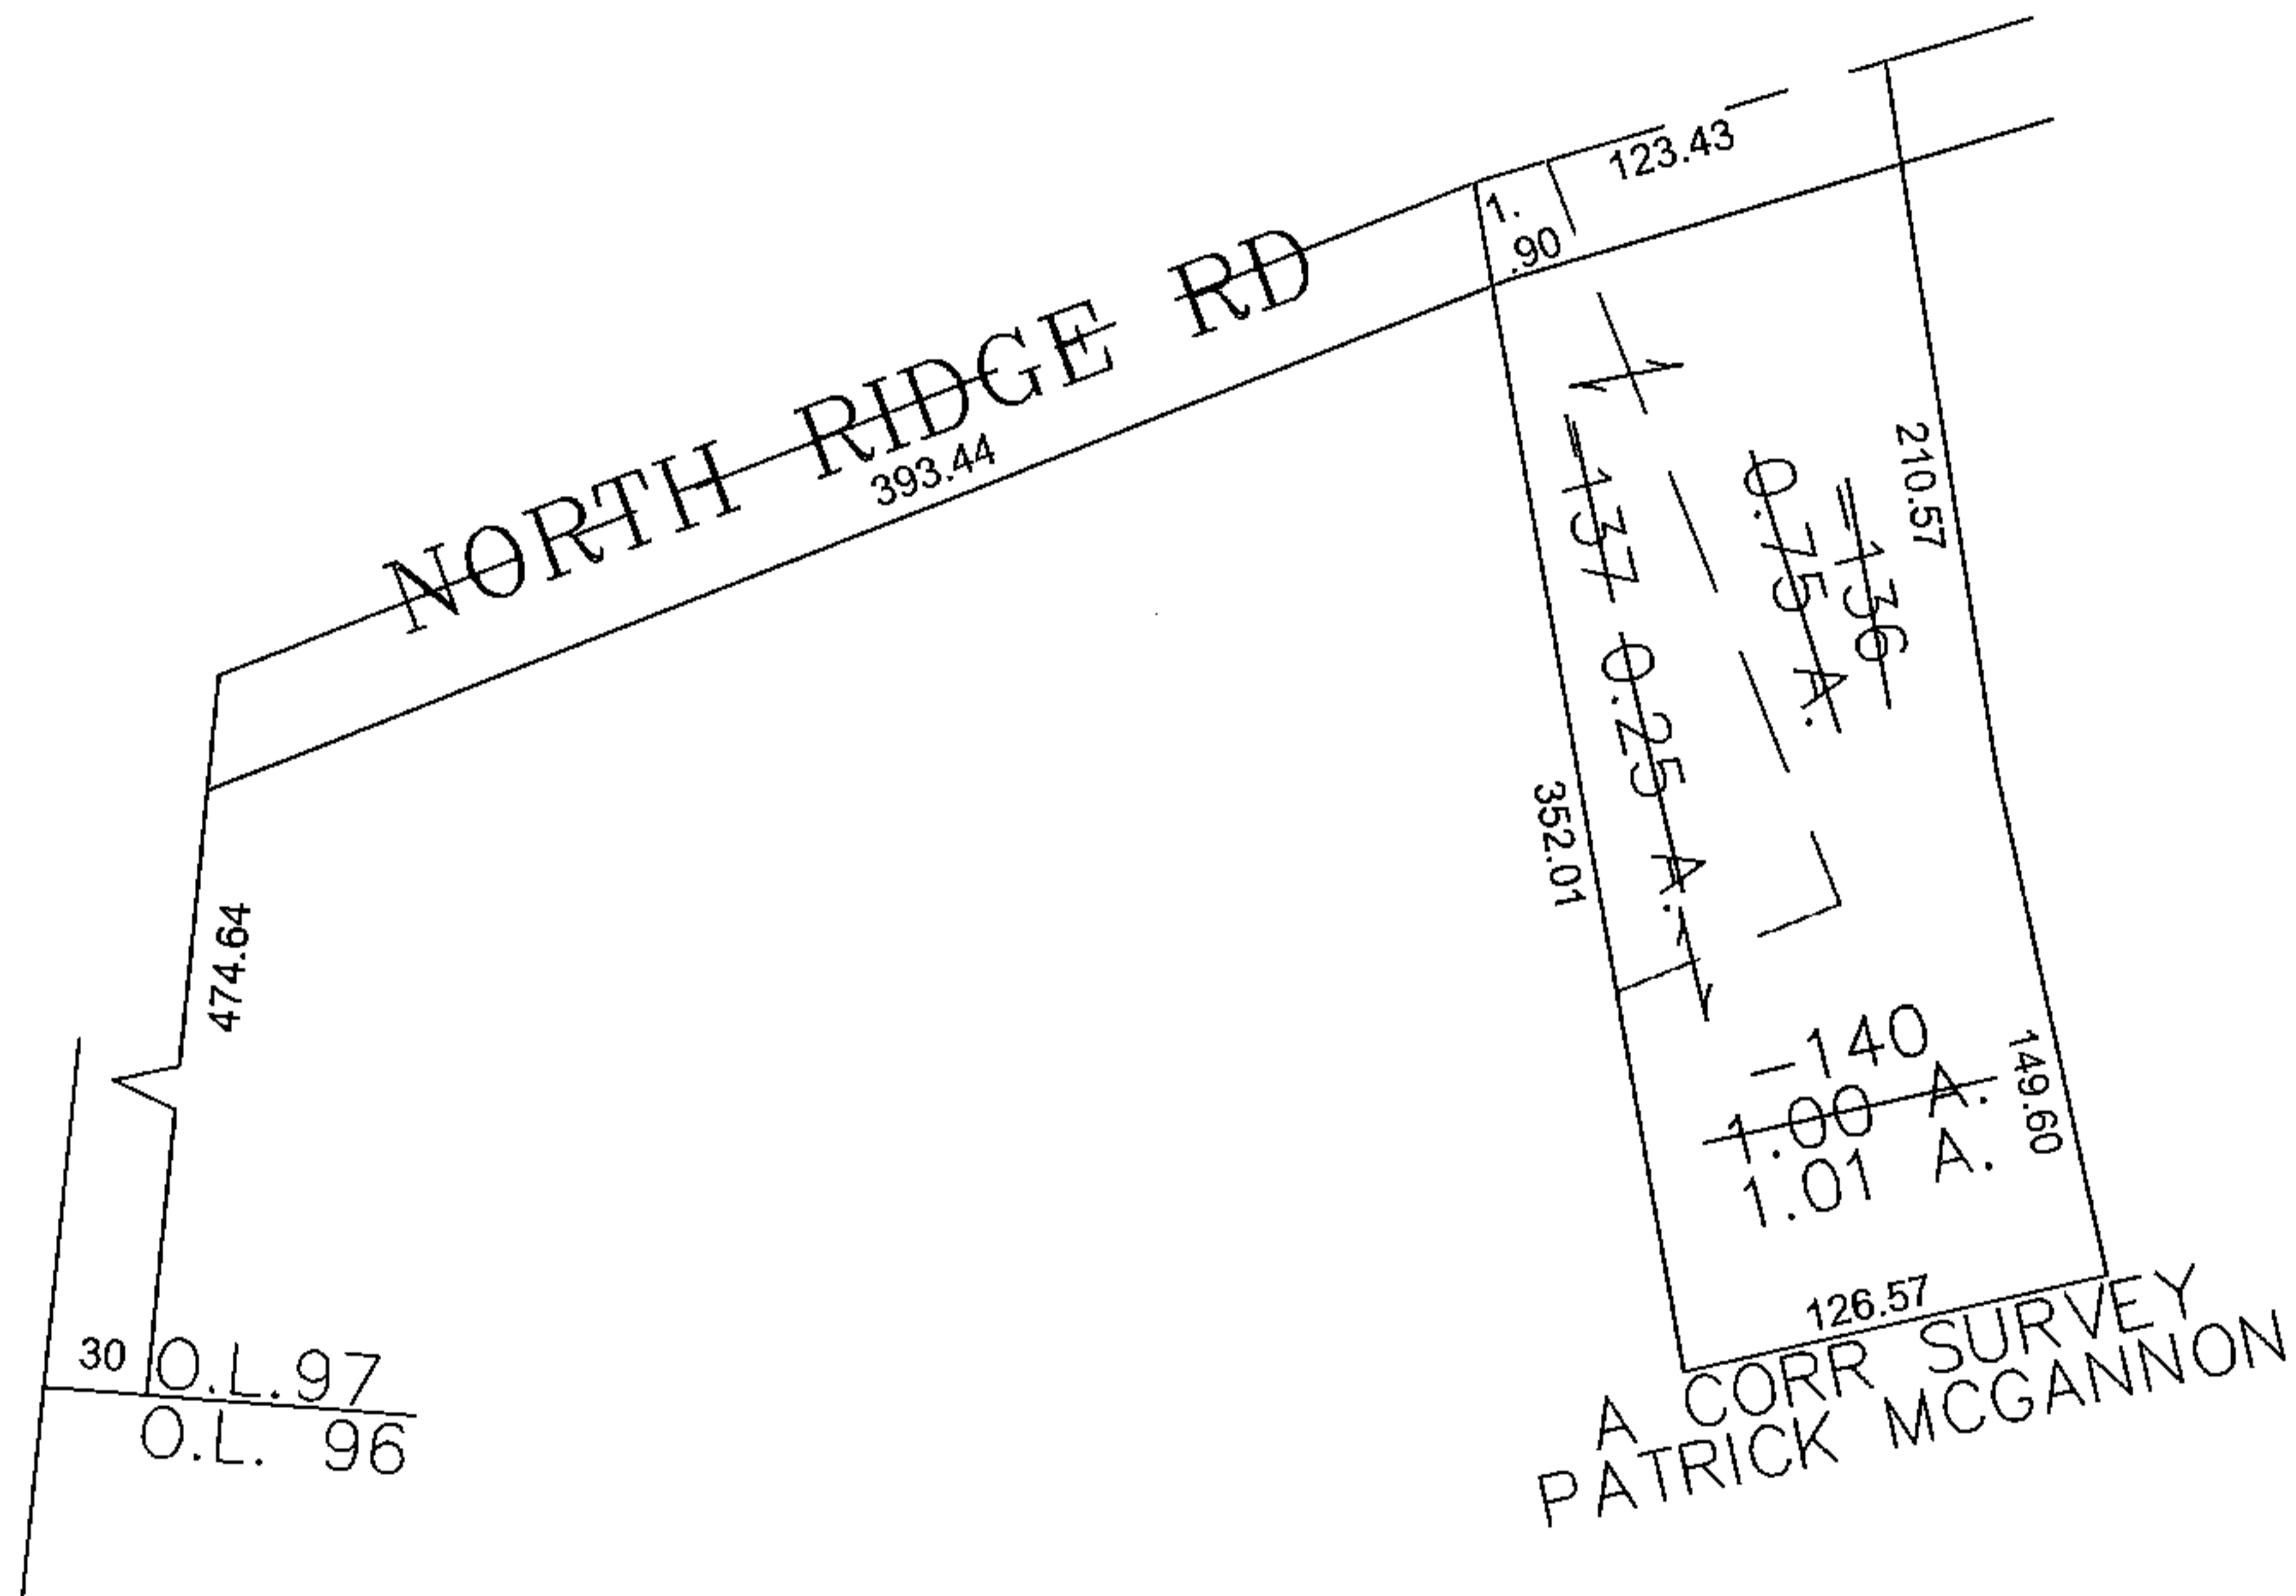


PARENT PARCEL: 05-00-097-103-136, -137

CHILD PARCEL: 05-00-097-103-140

STARTING POINT: SOUTHWEST CORNER OF ORIGINAL LOT 97

14-03311

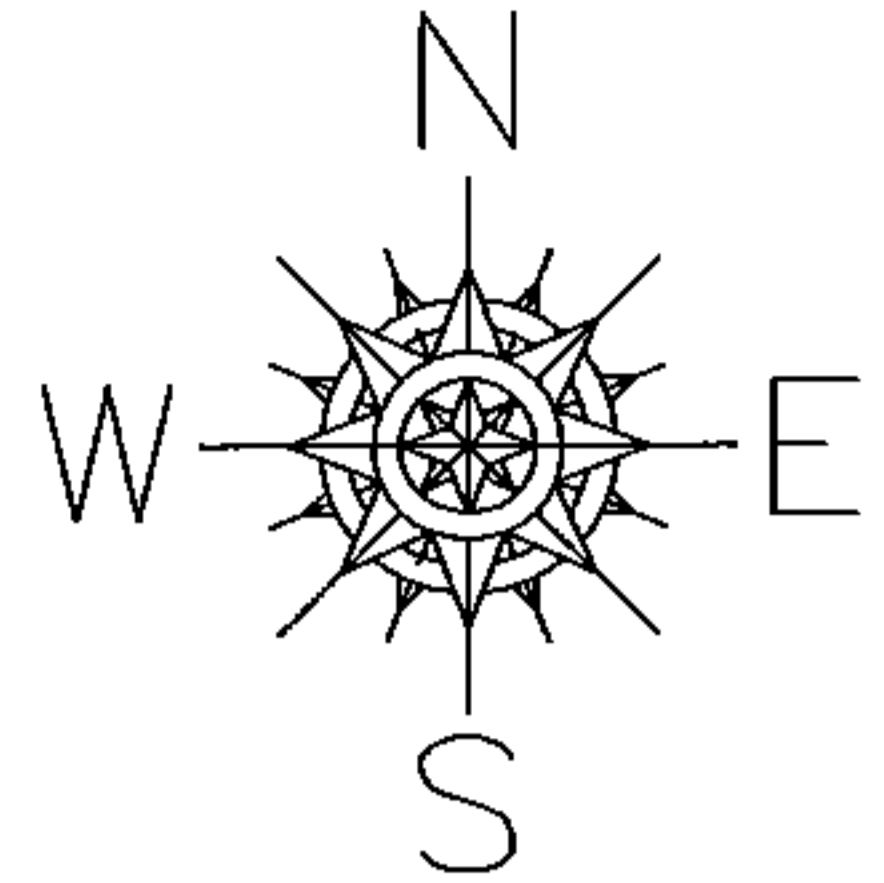

SPLITS/DEEDS PROCESSED

LORAIN COUNTY TAX MAP DEPARTMENT
226 MIDDLE AVE. ELYRIA, OHIO

SURVEYED BY: PATRICK MCGANNON

CLOSURE: 0.00 : 10.000

MAP PAGE(S): 05-00-097-B

APPROVED BY: JAH DATE: 11/12/2014

SCALE: 1" = 100 PRIOR INSTRUMENT: 20140517143