



PARENT PARCEL: 06-25-032-116-056, -057, -061, -067

CHILD PARCEL: 06-25-032-116-061, -068


STARTING POINT: INTERSECTION OF NORTH LINE OF S/L 18 AND WEST LINE OF ABBE RD.

14-03314

HILLIARD RD.

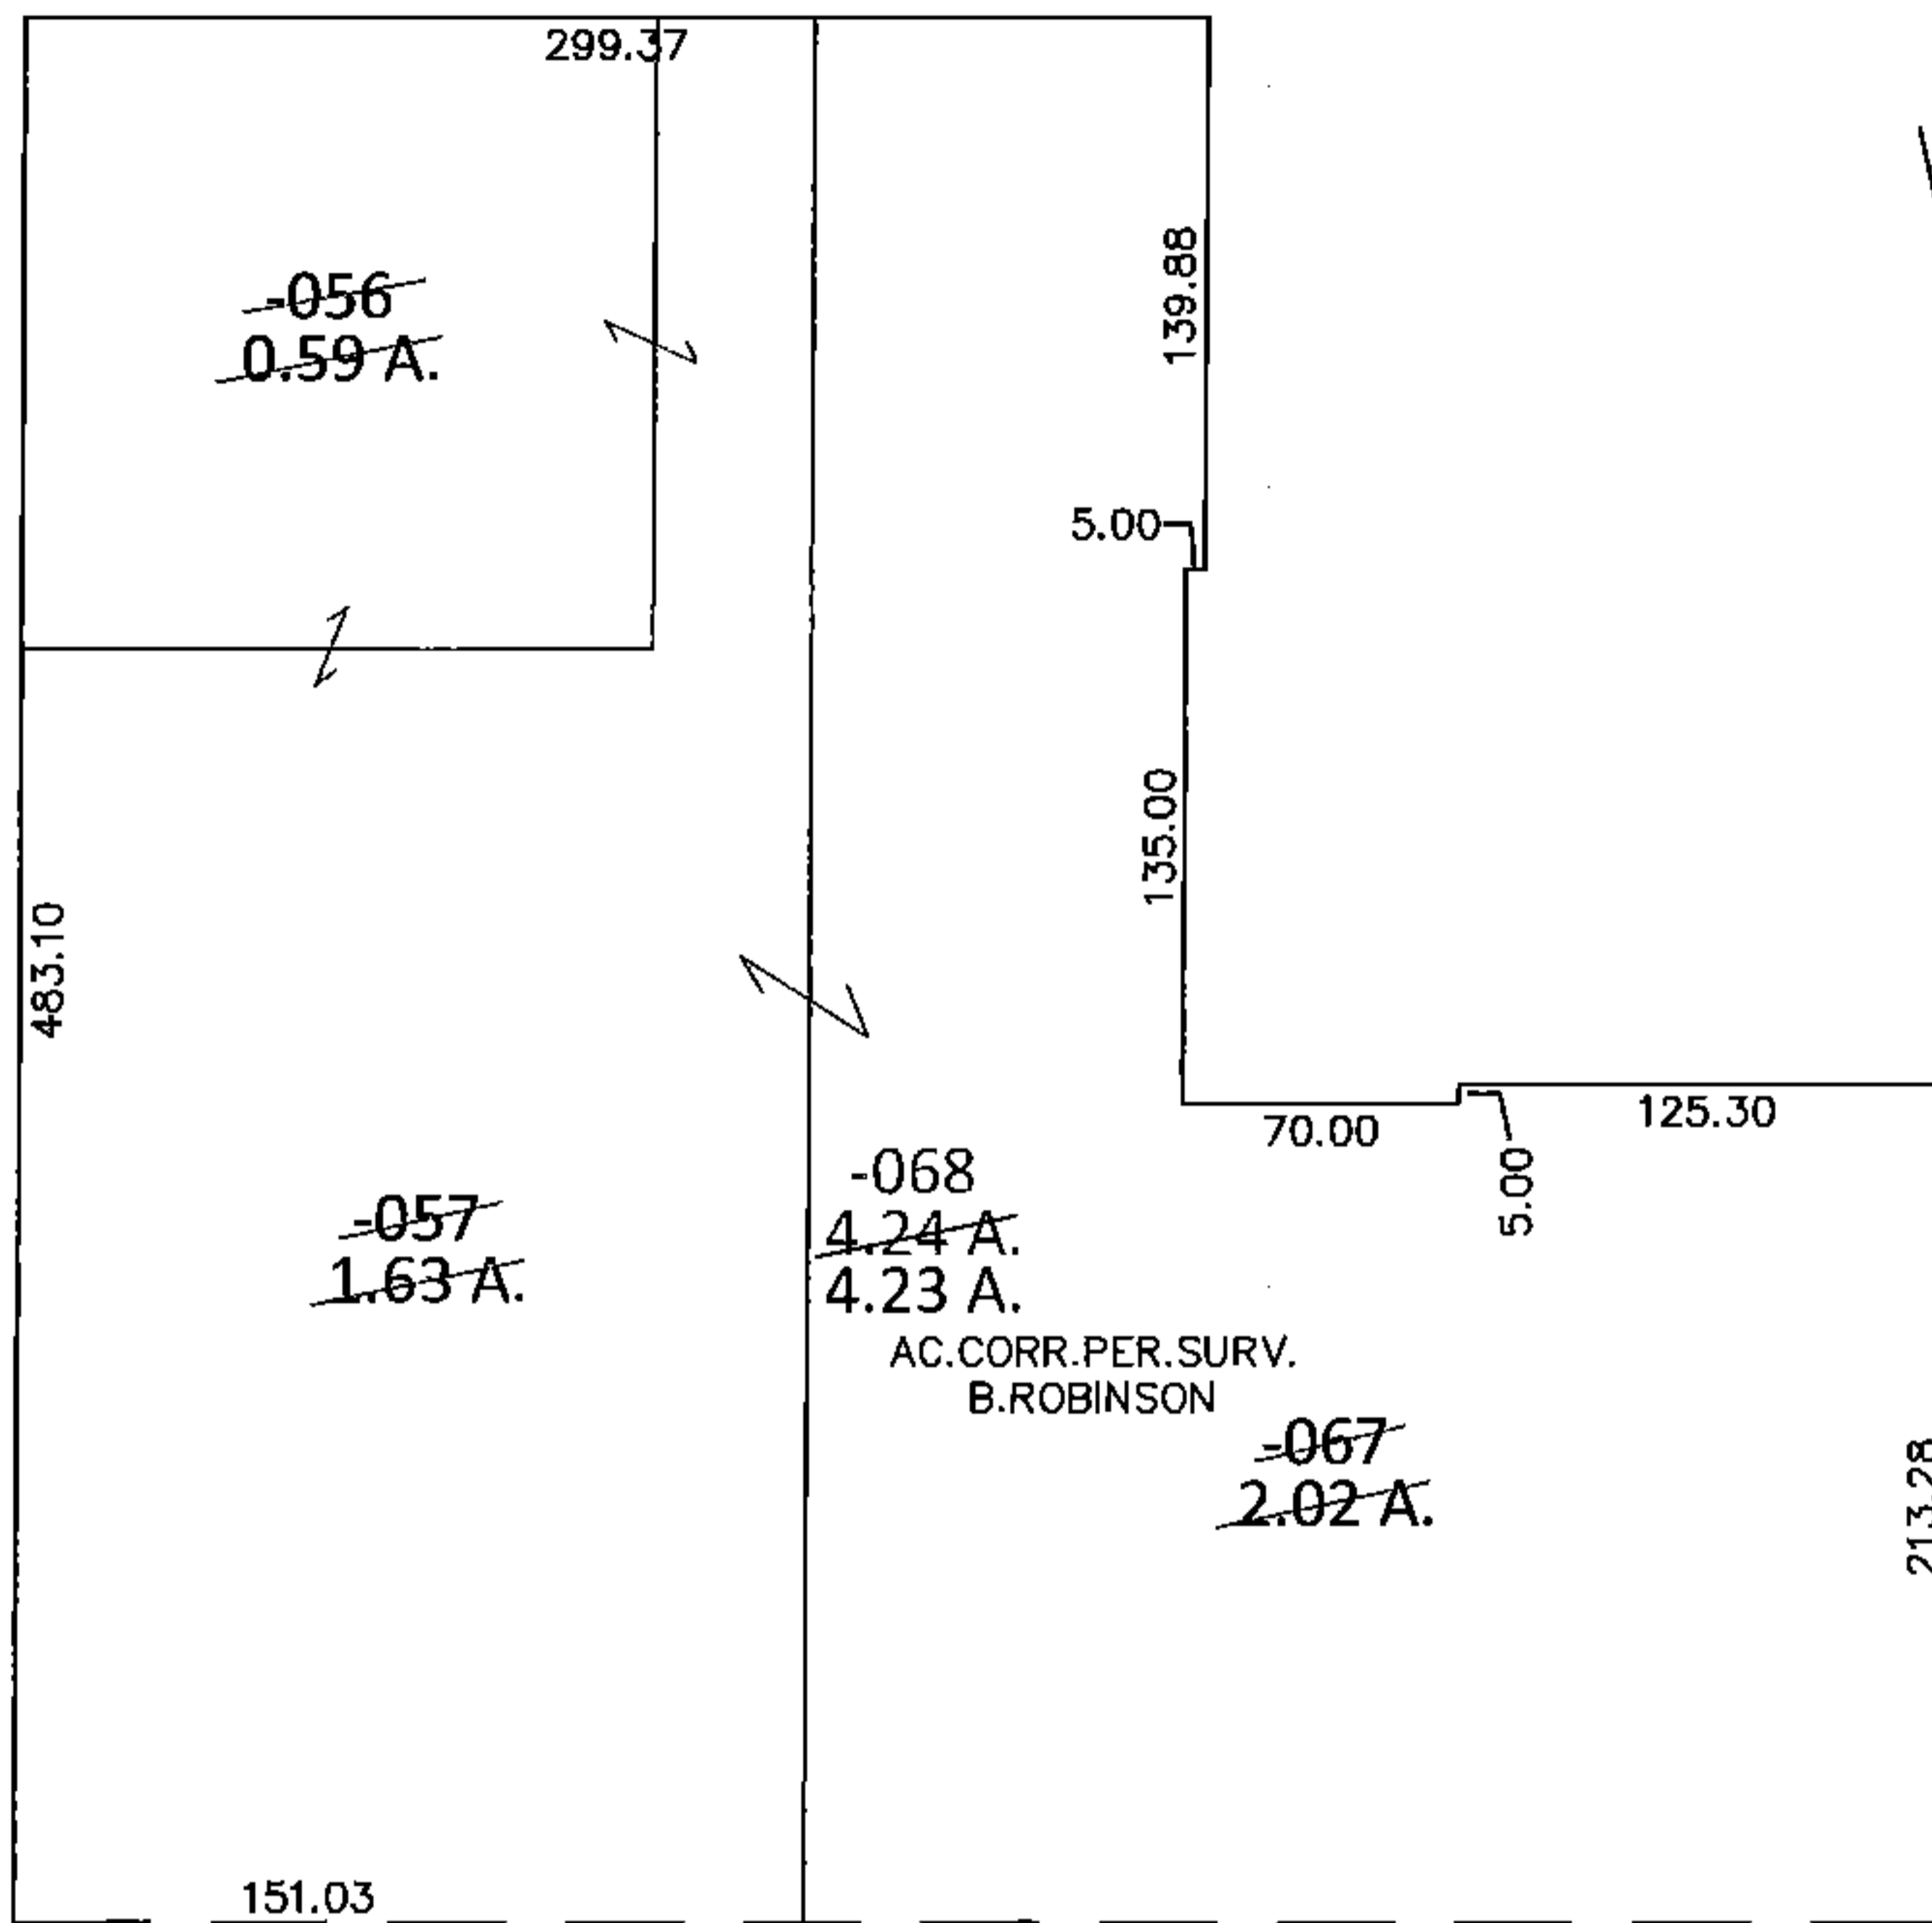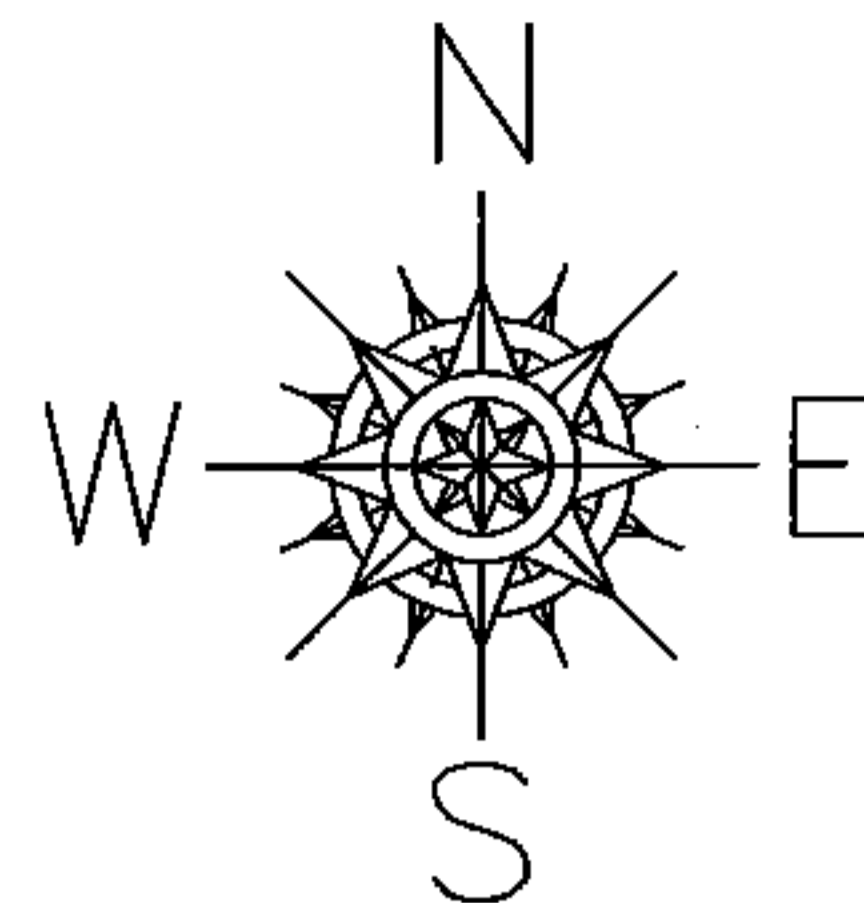


FRONTAGE & DEPTH CORR.  
 06-25-032-116-061  
 248.46 X 339.74  
~~247.01 X 338.50~~  
 PER SURVEY BY B. ROBINSON

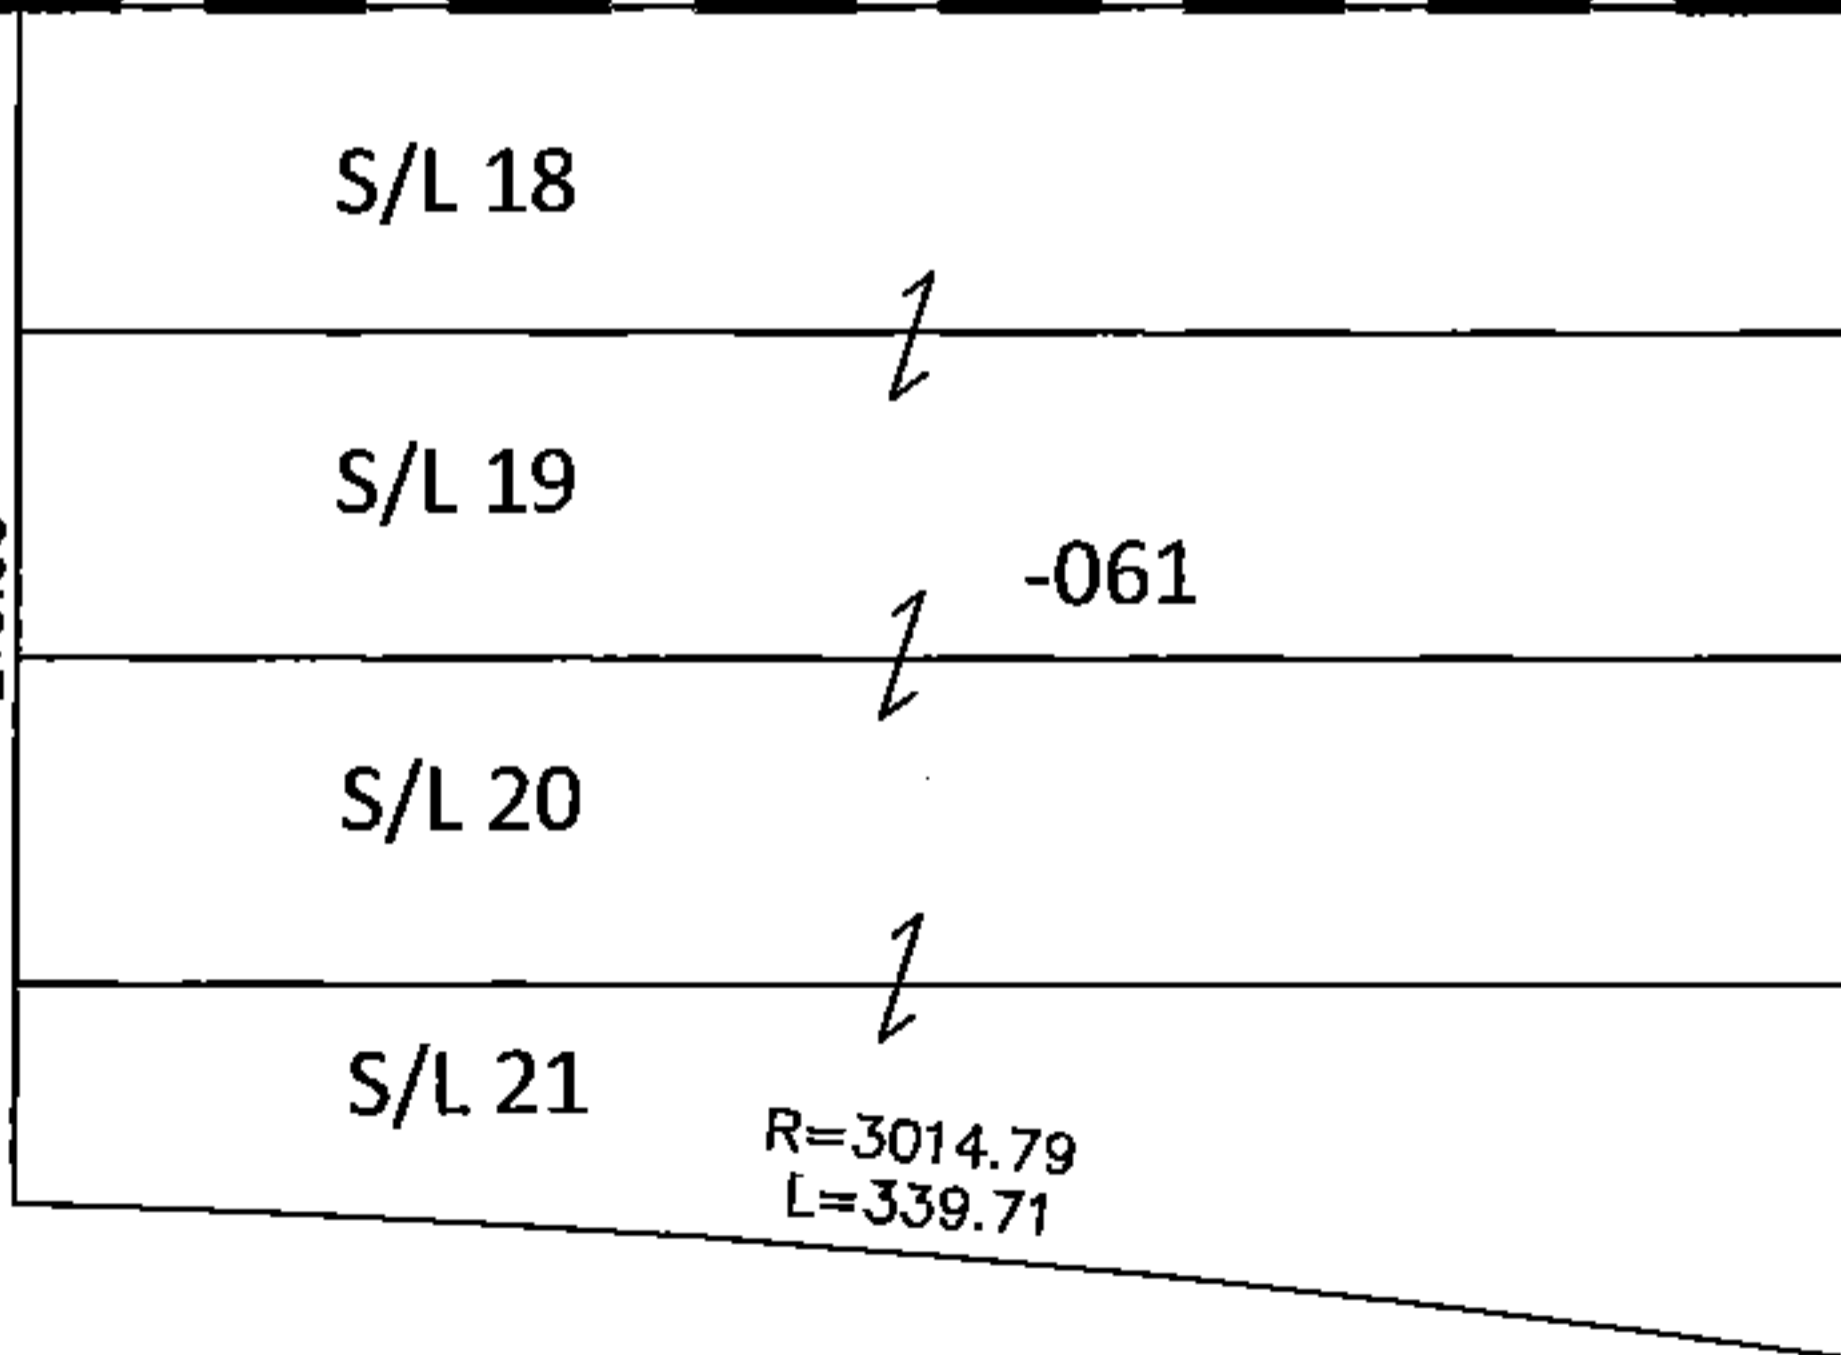

TURNPIKE

ABBE RD. (S.R. 301)

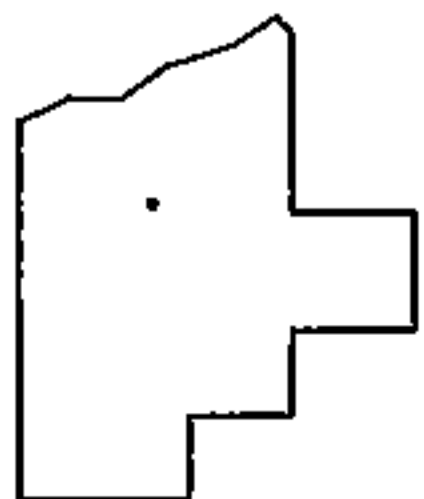

SPLITS/DEEDS PROCESSED

LORAIN COUNTY TAX MAP DEPARTMENT  
226 MIDDLE AVE. ELYRIA, OHIO

SURVEYED BY: BRUCE L. ROBINSON

CLOSURE: .01:10,000

MAP PAGE(S): 6-70

APPROVED BY: RRM DATE: 12-1-14

SCALE: 1"= 100 PRIOR INST.: 20070225240