
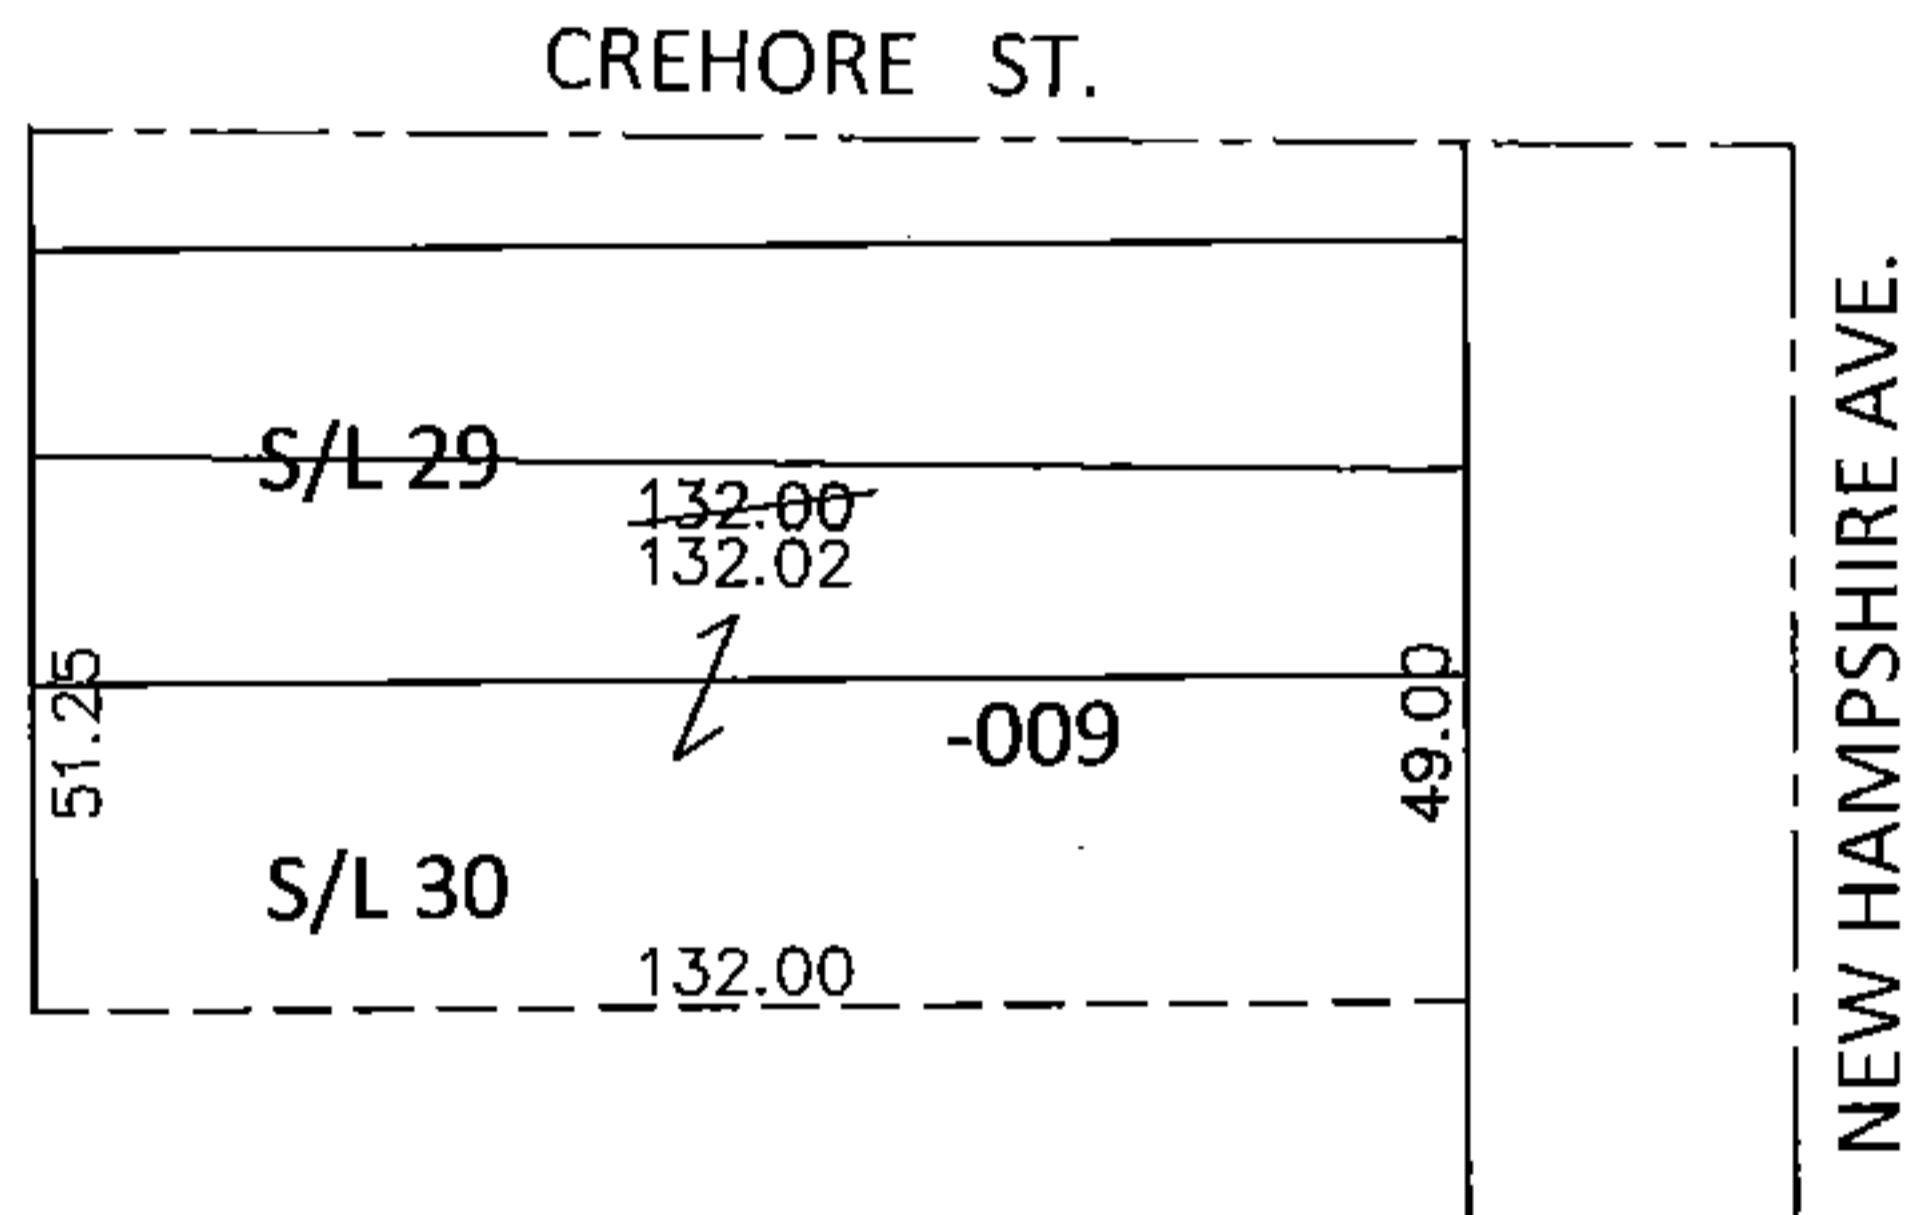


PARENT PARCEL: 03-00-055-114-009

CHILD PARCEL: _____

STARTING POINT: INTERSECTION OF SOUTH LINE OF CREHORE ST. AND WEST LINE OF NEW HAMPSHIRE AVE.

15-03315-D

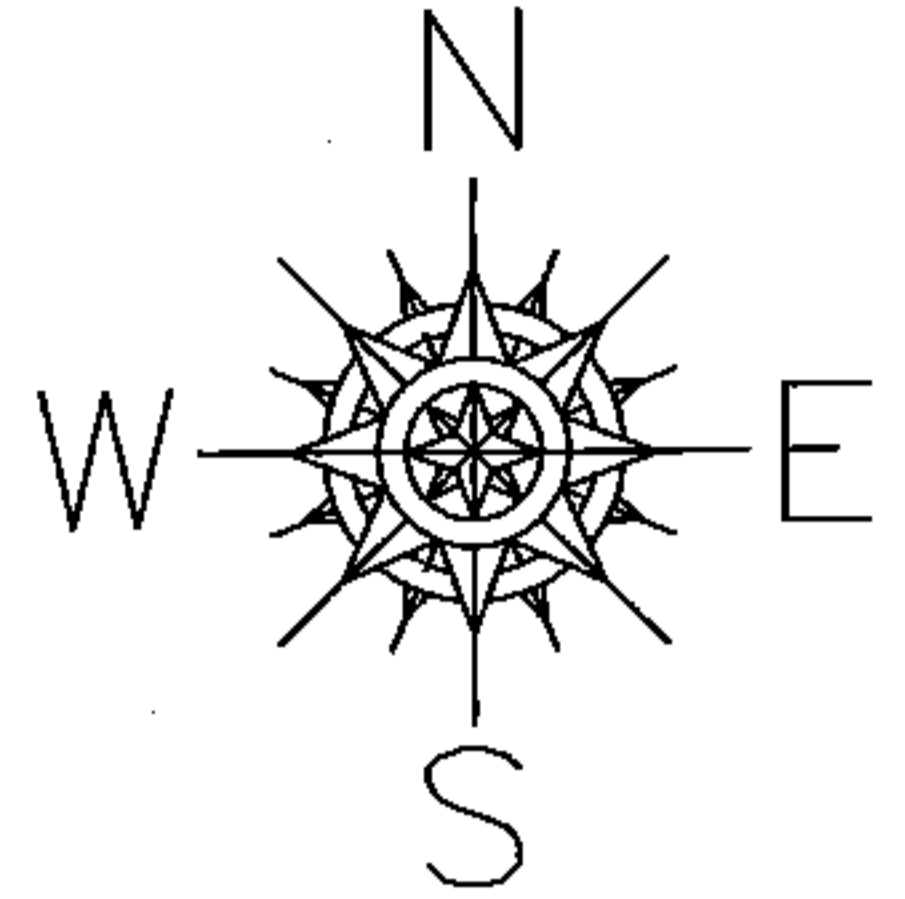


DEPTH CORRECTION

03-00-055-114-009

132.02

49 X ~~132~~

PER SURVEY BY W.WALLACE

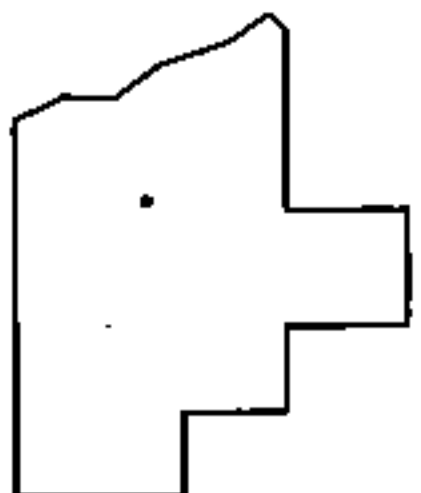

SPLITS/DEEDS PROCESSED

LORAIN COUNTY TAX MAP DEPARTMENT
226 MIDDLE AVE. ELYRIA, OHIO

SURVEYED BY: WILLIAMR. WALLACE

CLOSURE: .00:10,000

MAP PAGE(S): 3-00-055-A

APPROVED BY: RRM DATE: 10-14-15

SCALE: 1"= 50' PRIOR INST.: 20140516655