
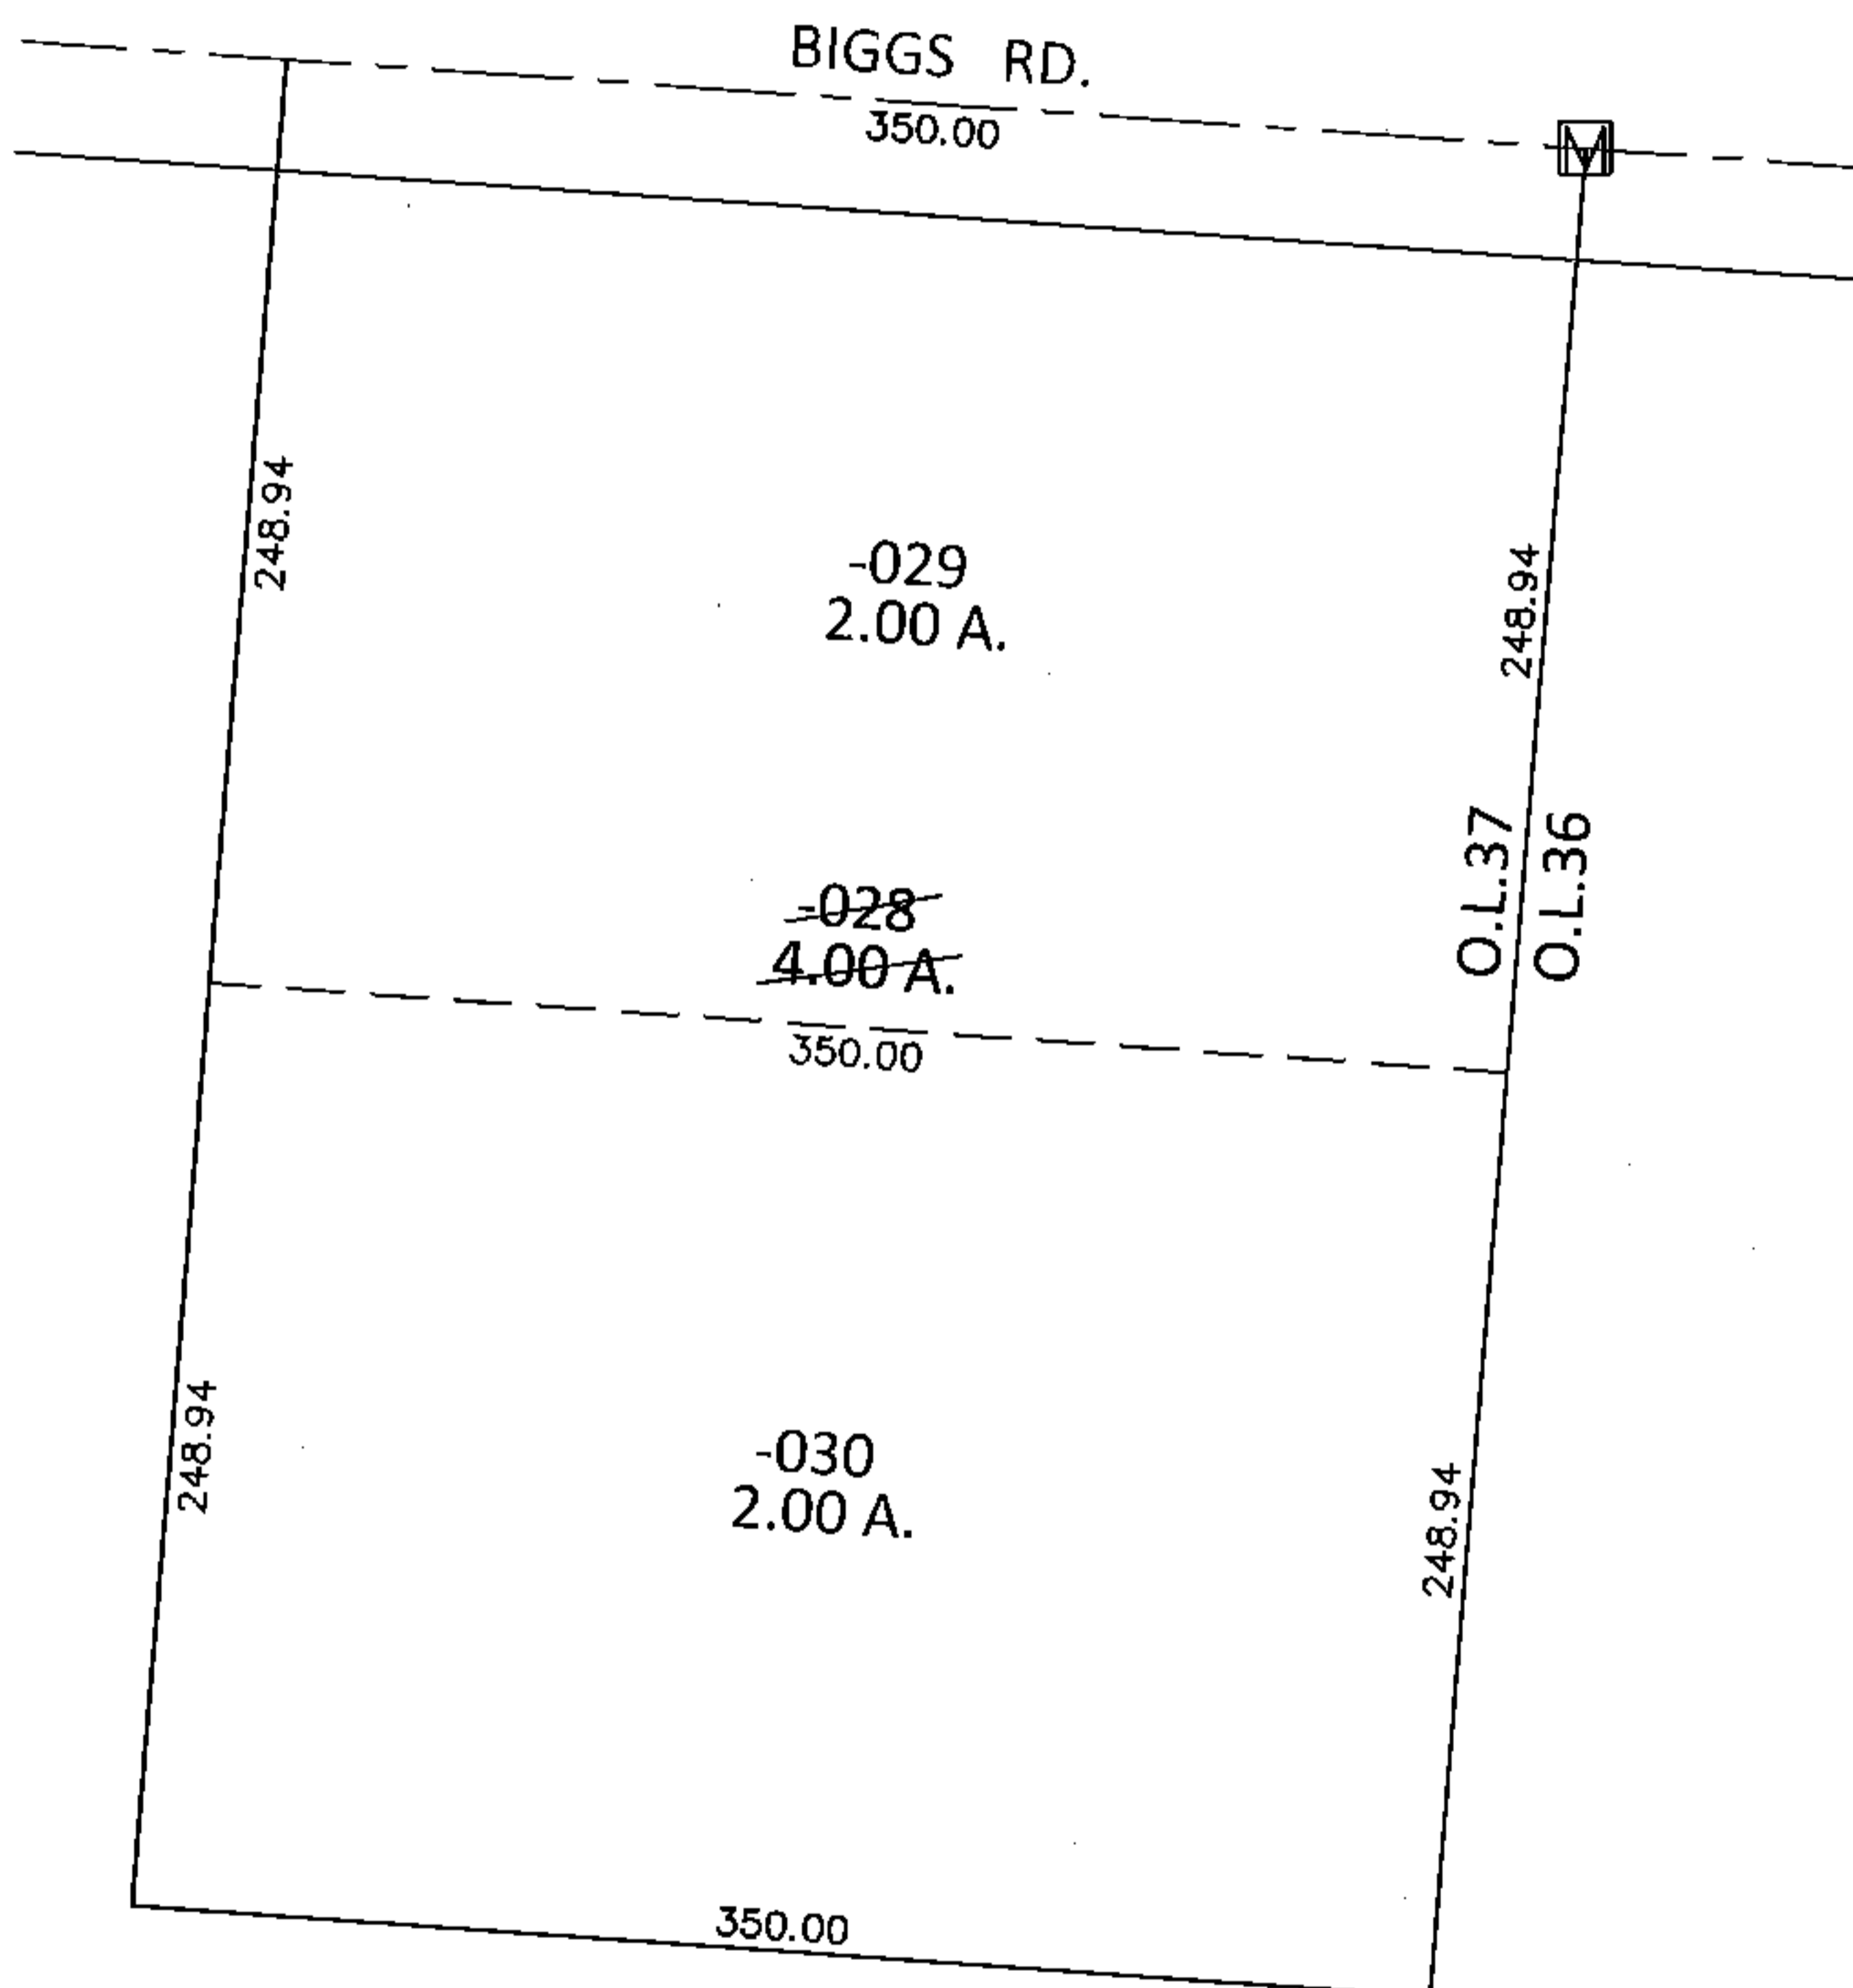


PARENT PARCEL: 15-00-037-000-028


CHILD PARCEL: 15-00-037-000-029, -030

STARTING POINT: AT A MON BOX AT THE NORTHEAST CORNER OF O.L.37

15-03316-X

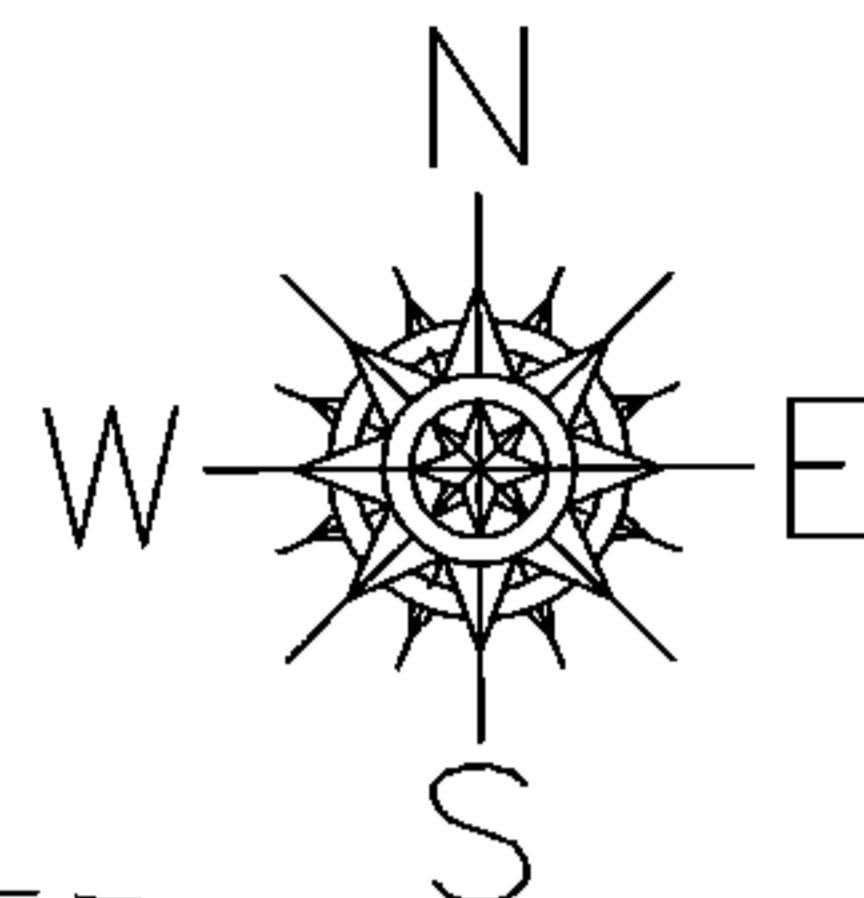

UNCOMBINATION

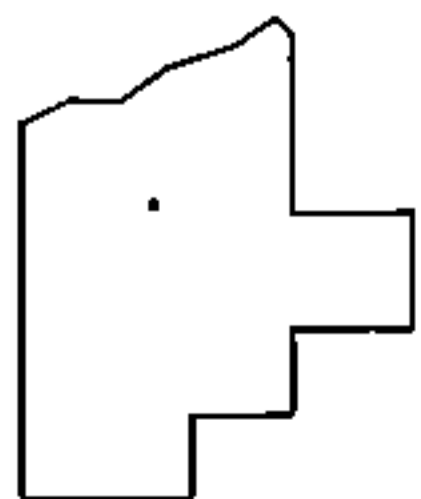

**SPLITS/DEEDS PROCESSED**

LORAIN COUNTY TAX MAP DEPARTMENT  
226 MIDDLE AVE. ELYRIA, OHIO

SURVEYED BY: GARY E. PENFOUND

CLOSURE: .00:10,000

MAP PAGE(S): 15-B

APPROVED BY: RRM DATE: 10-15-15

SCALE: 1"= 100 PRIOR INST.: DV 1143/584