

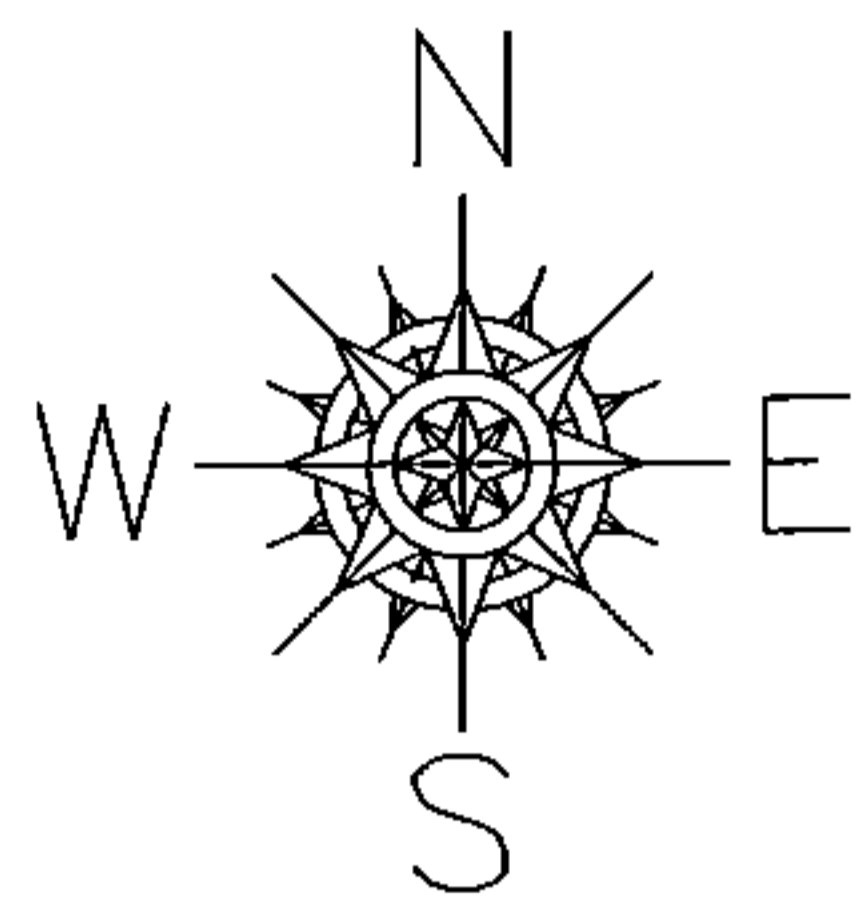


PARENT PARCEL: 04-00-028-102-170, -171
 CHILD PARCEL: 04-00-028-102-183, -184, -185
 STARTING POINT: CENTERLINE OF NAGEL RD & O.L. 28

14-03316

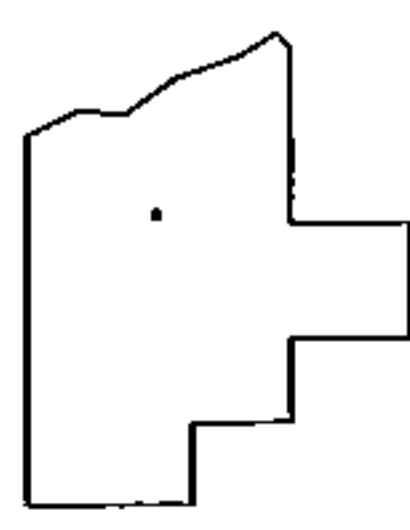

JUST IMAGINE DR

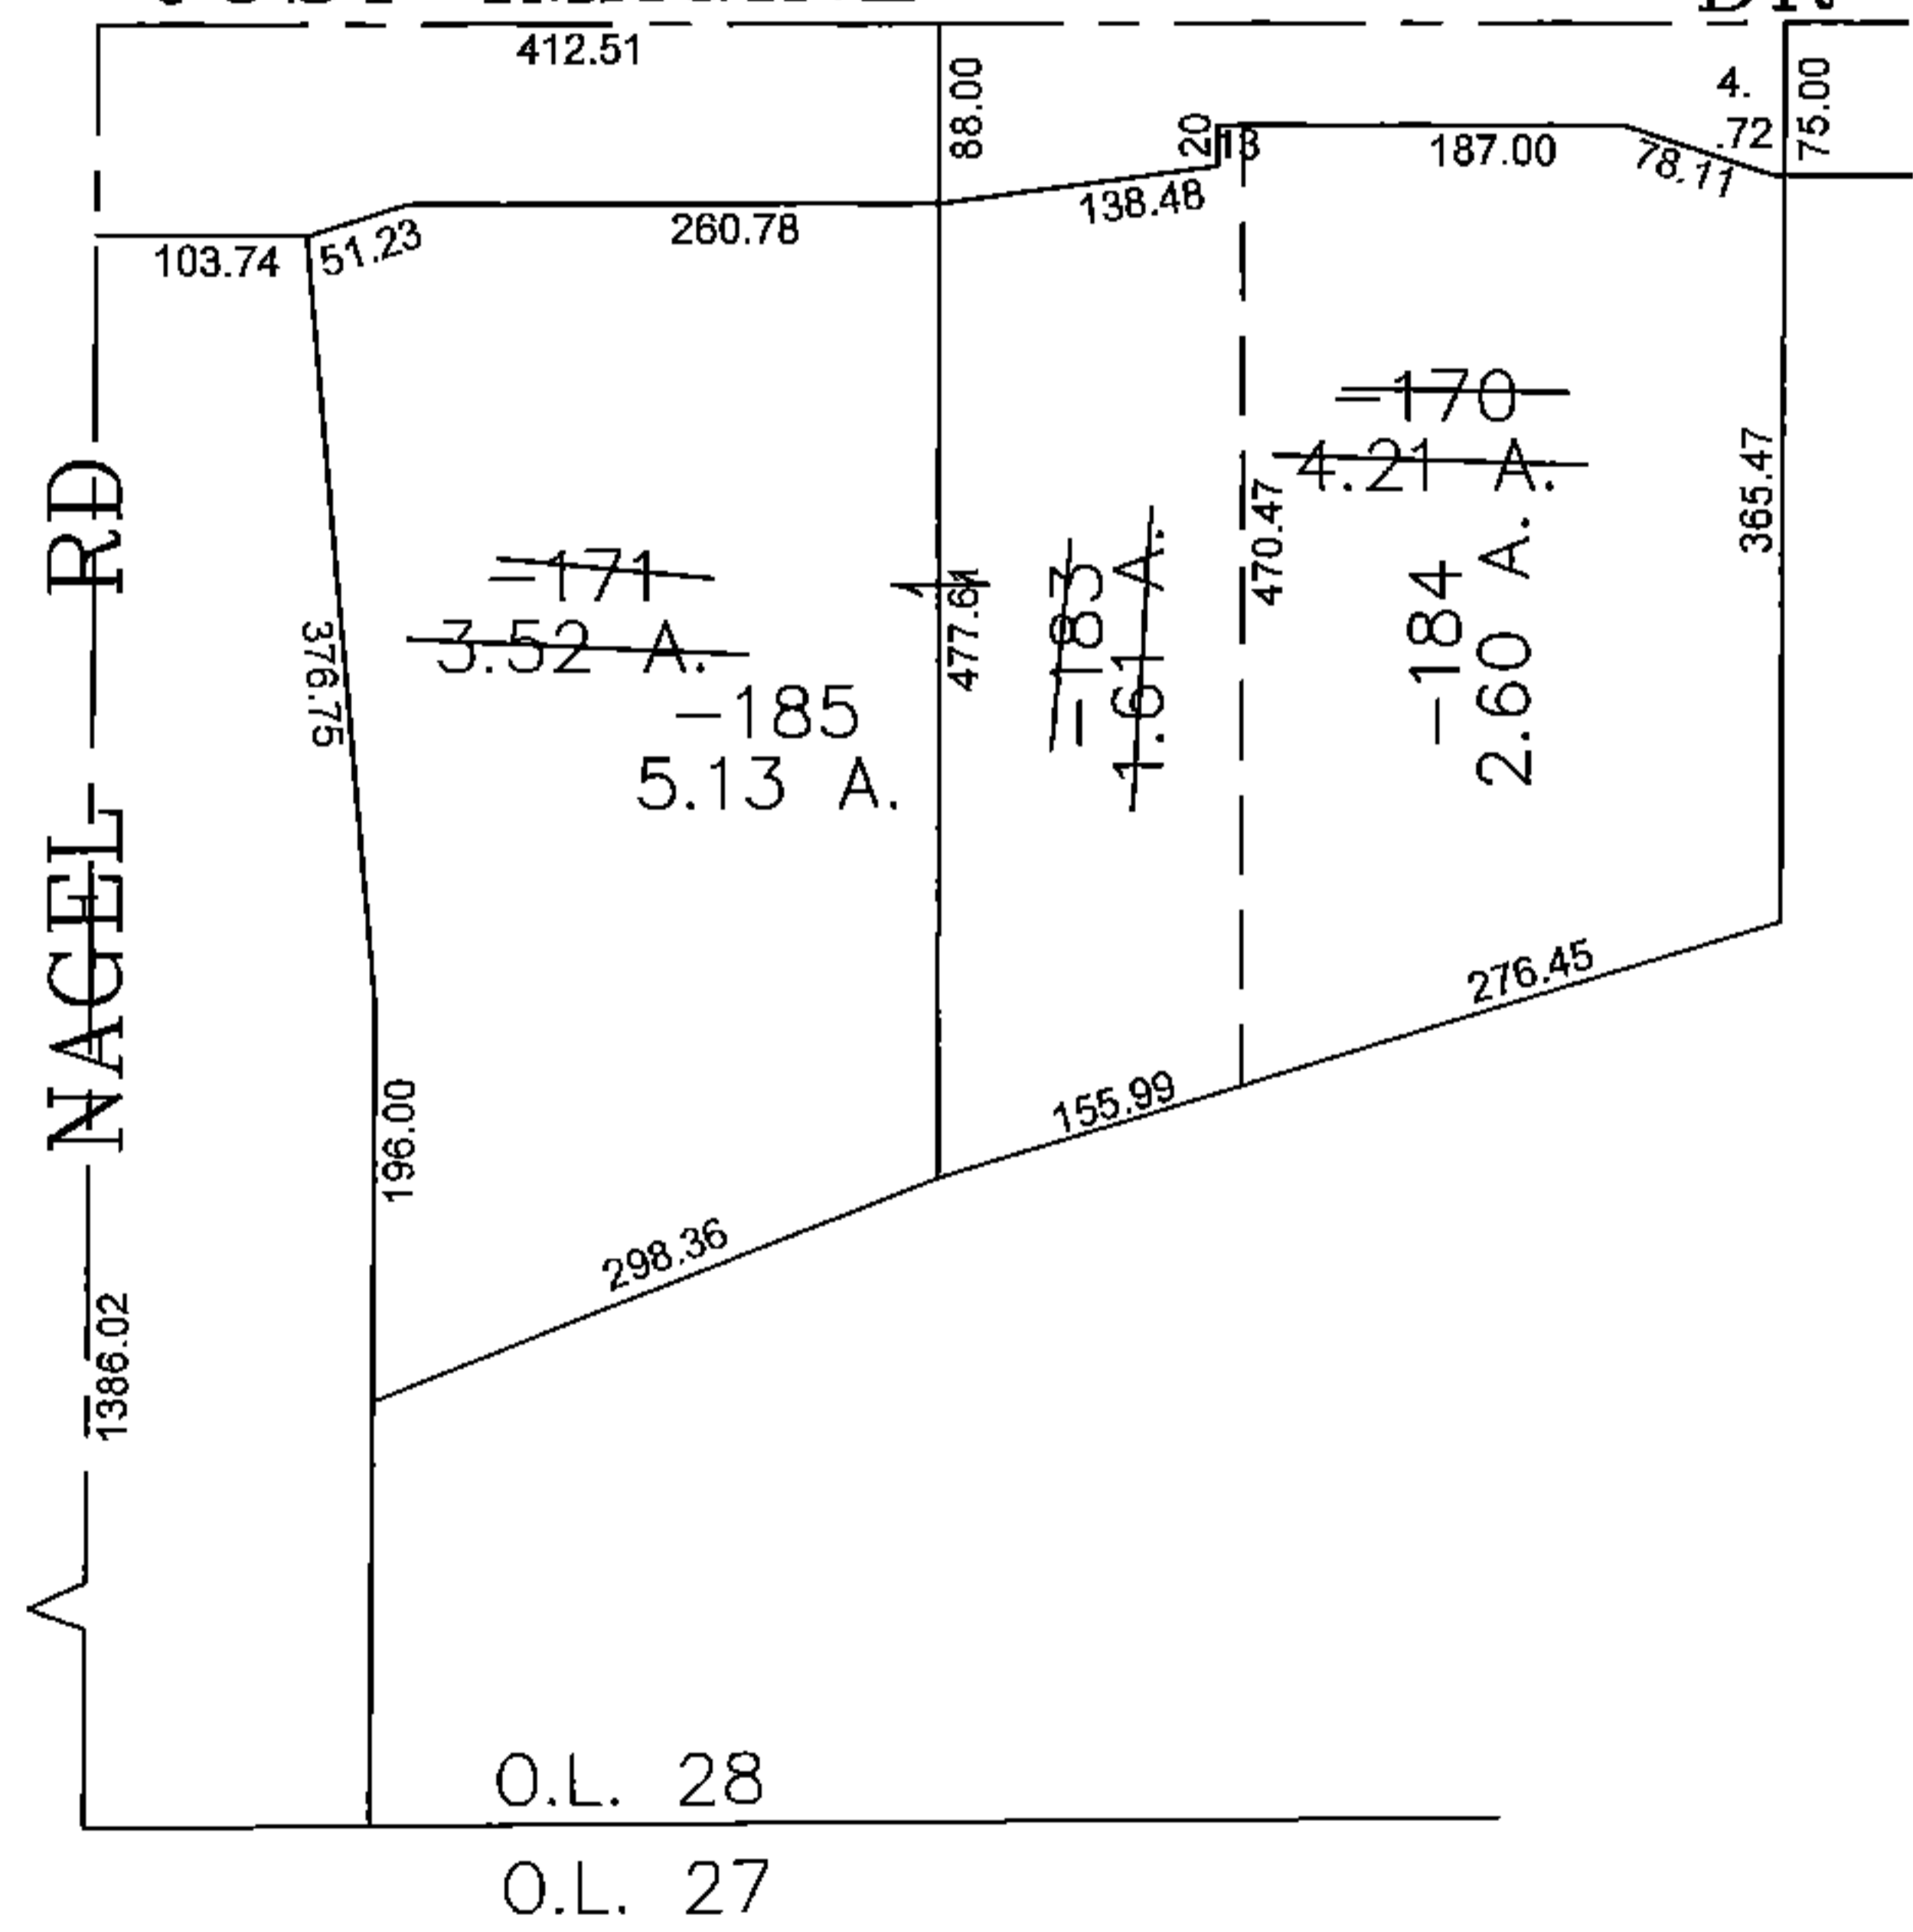

SPLITS/DEEDS PROCESSED
 LORAIN COUNTY TAX MAP DEPARTMENT
 226 MIDDLE AVE. ELYRIA, OHIO

SURVEYED BY: PETER ZWICK
 CLOSURE: 0.00 : 10.000
 MAP PAGE(S): 04-00-028-A
 APPROVED BY: JAH DATE: 12/9/2014
 SCALE: 1" = 200 PRIOR INSTRUMENT: 20060133905