


PARENT PARCEL: 06-24-056-000-009

CHILD PARCEL: \_\_\_\_\_

STARTING POINT: INTERSECTION OF SOUTH LINE OF BATH ST. AND WEST LINE OF WEST RIVER RD.

15-03317-X

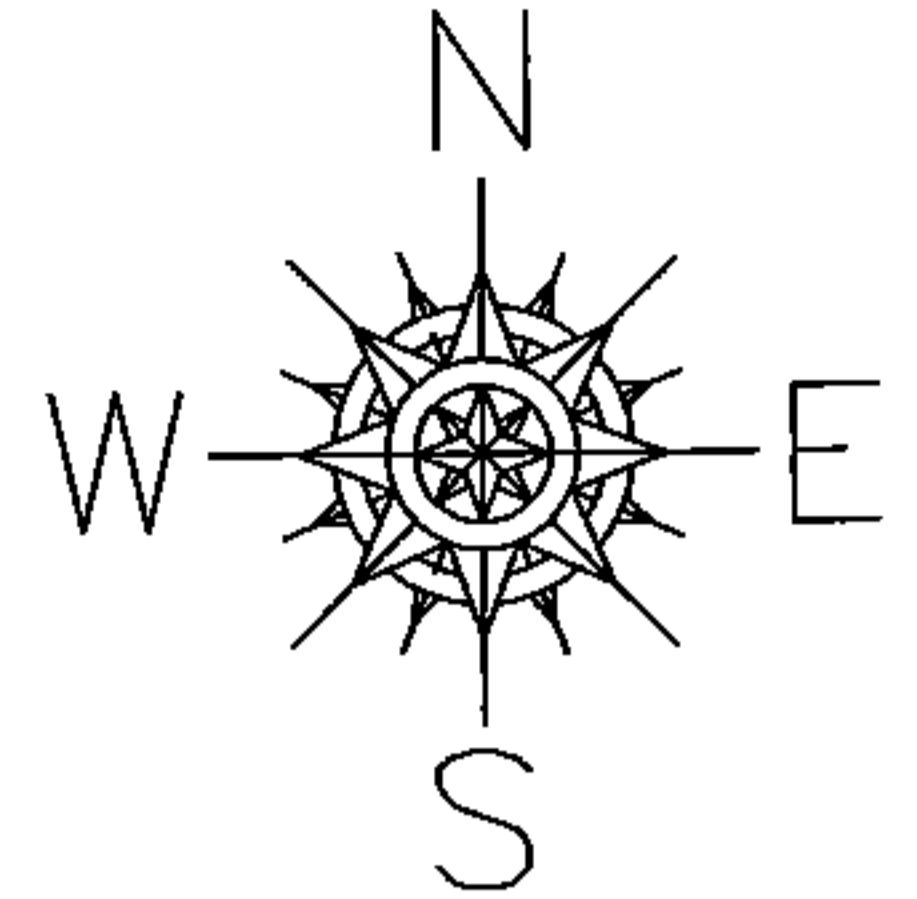

BATH ST.

66.00

625.83

-009

NEW LINE  
154.45

NEW LINE  
154.10

S/L8

S/L7

65.35

WEST RIVER RD.


**MAP & DEPTH CORRECTION**

06-24-056-000-009

66 X 154.45

~~66 X~~

PER SURVEY BY T.HOZALSKI

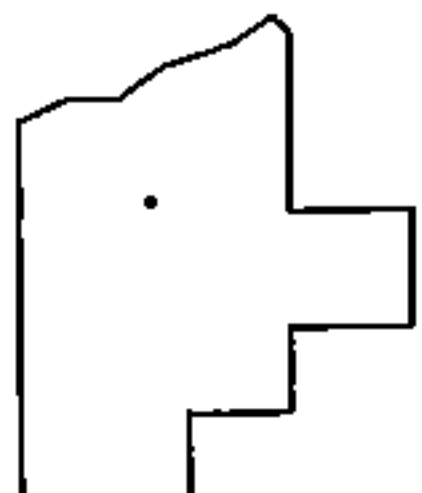

**SPLITS/DEEDS PROCESSED**

LORAIN COUNTY TAX MAP DEPARTMENT  
226 MIDDLE AVE. ELYRIA, OHIO

SURVEYED BY: TIMOTHY D. HOZALSKI

CLOSURE: .00:10,000

MAP PAGE(S): 6-100

APPROVED BY: RRM DATE: 10-19-15

SCALE: 1"= 50' PRIOR INST.: 20140521697