
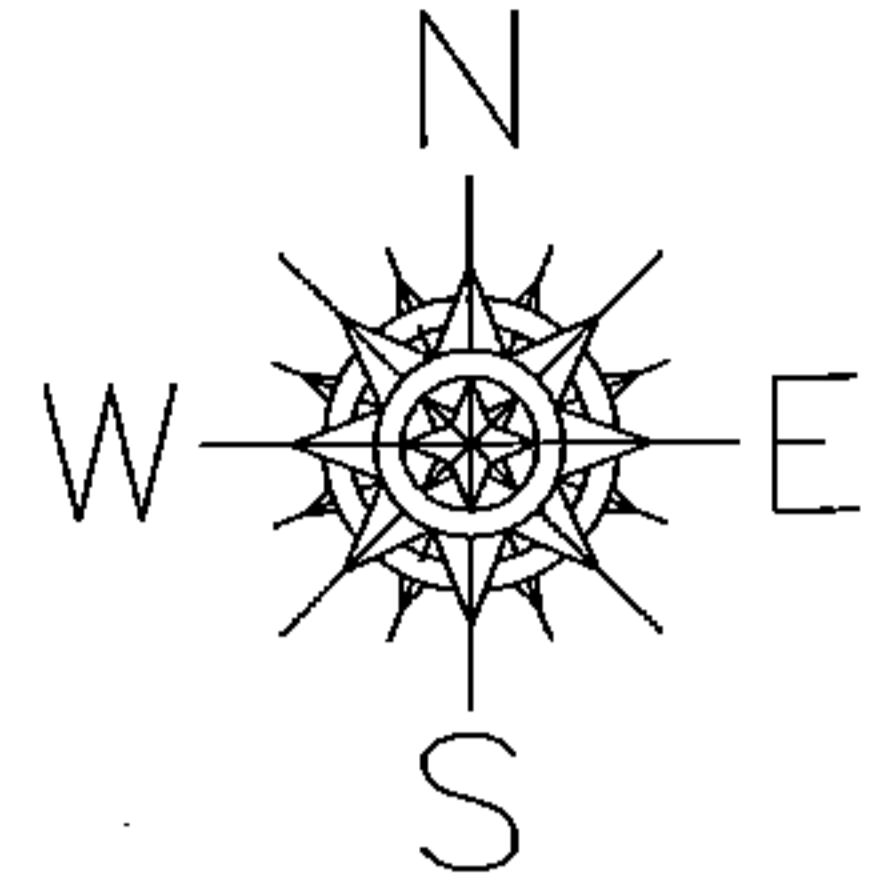


PARENT PARCEL: 04-00-028-101-111

CHILD PARCEL: 04-00-028-101-112 THRU -116

STARTING POINT: CENTERLINE OF NAGEL RD & O.L. 28

14-03318

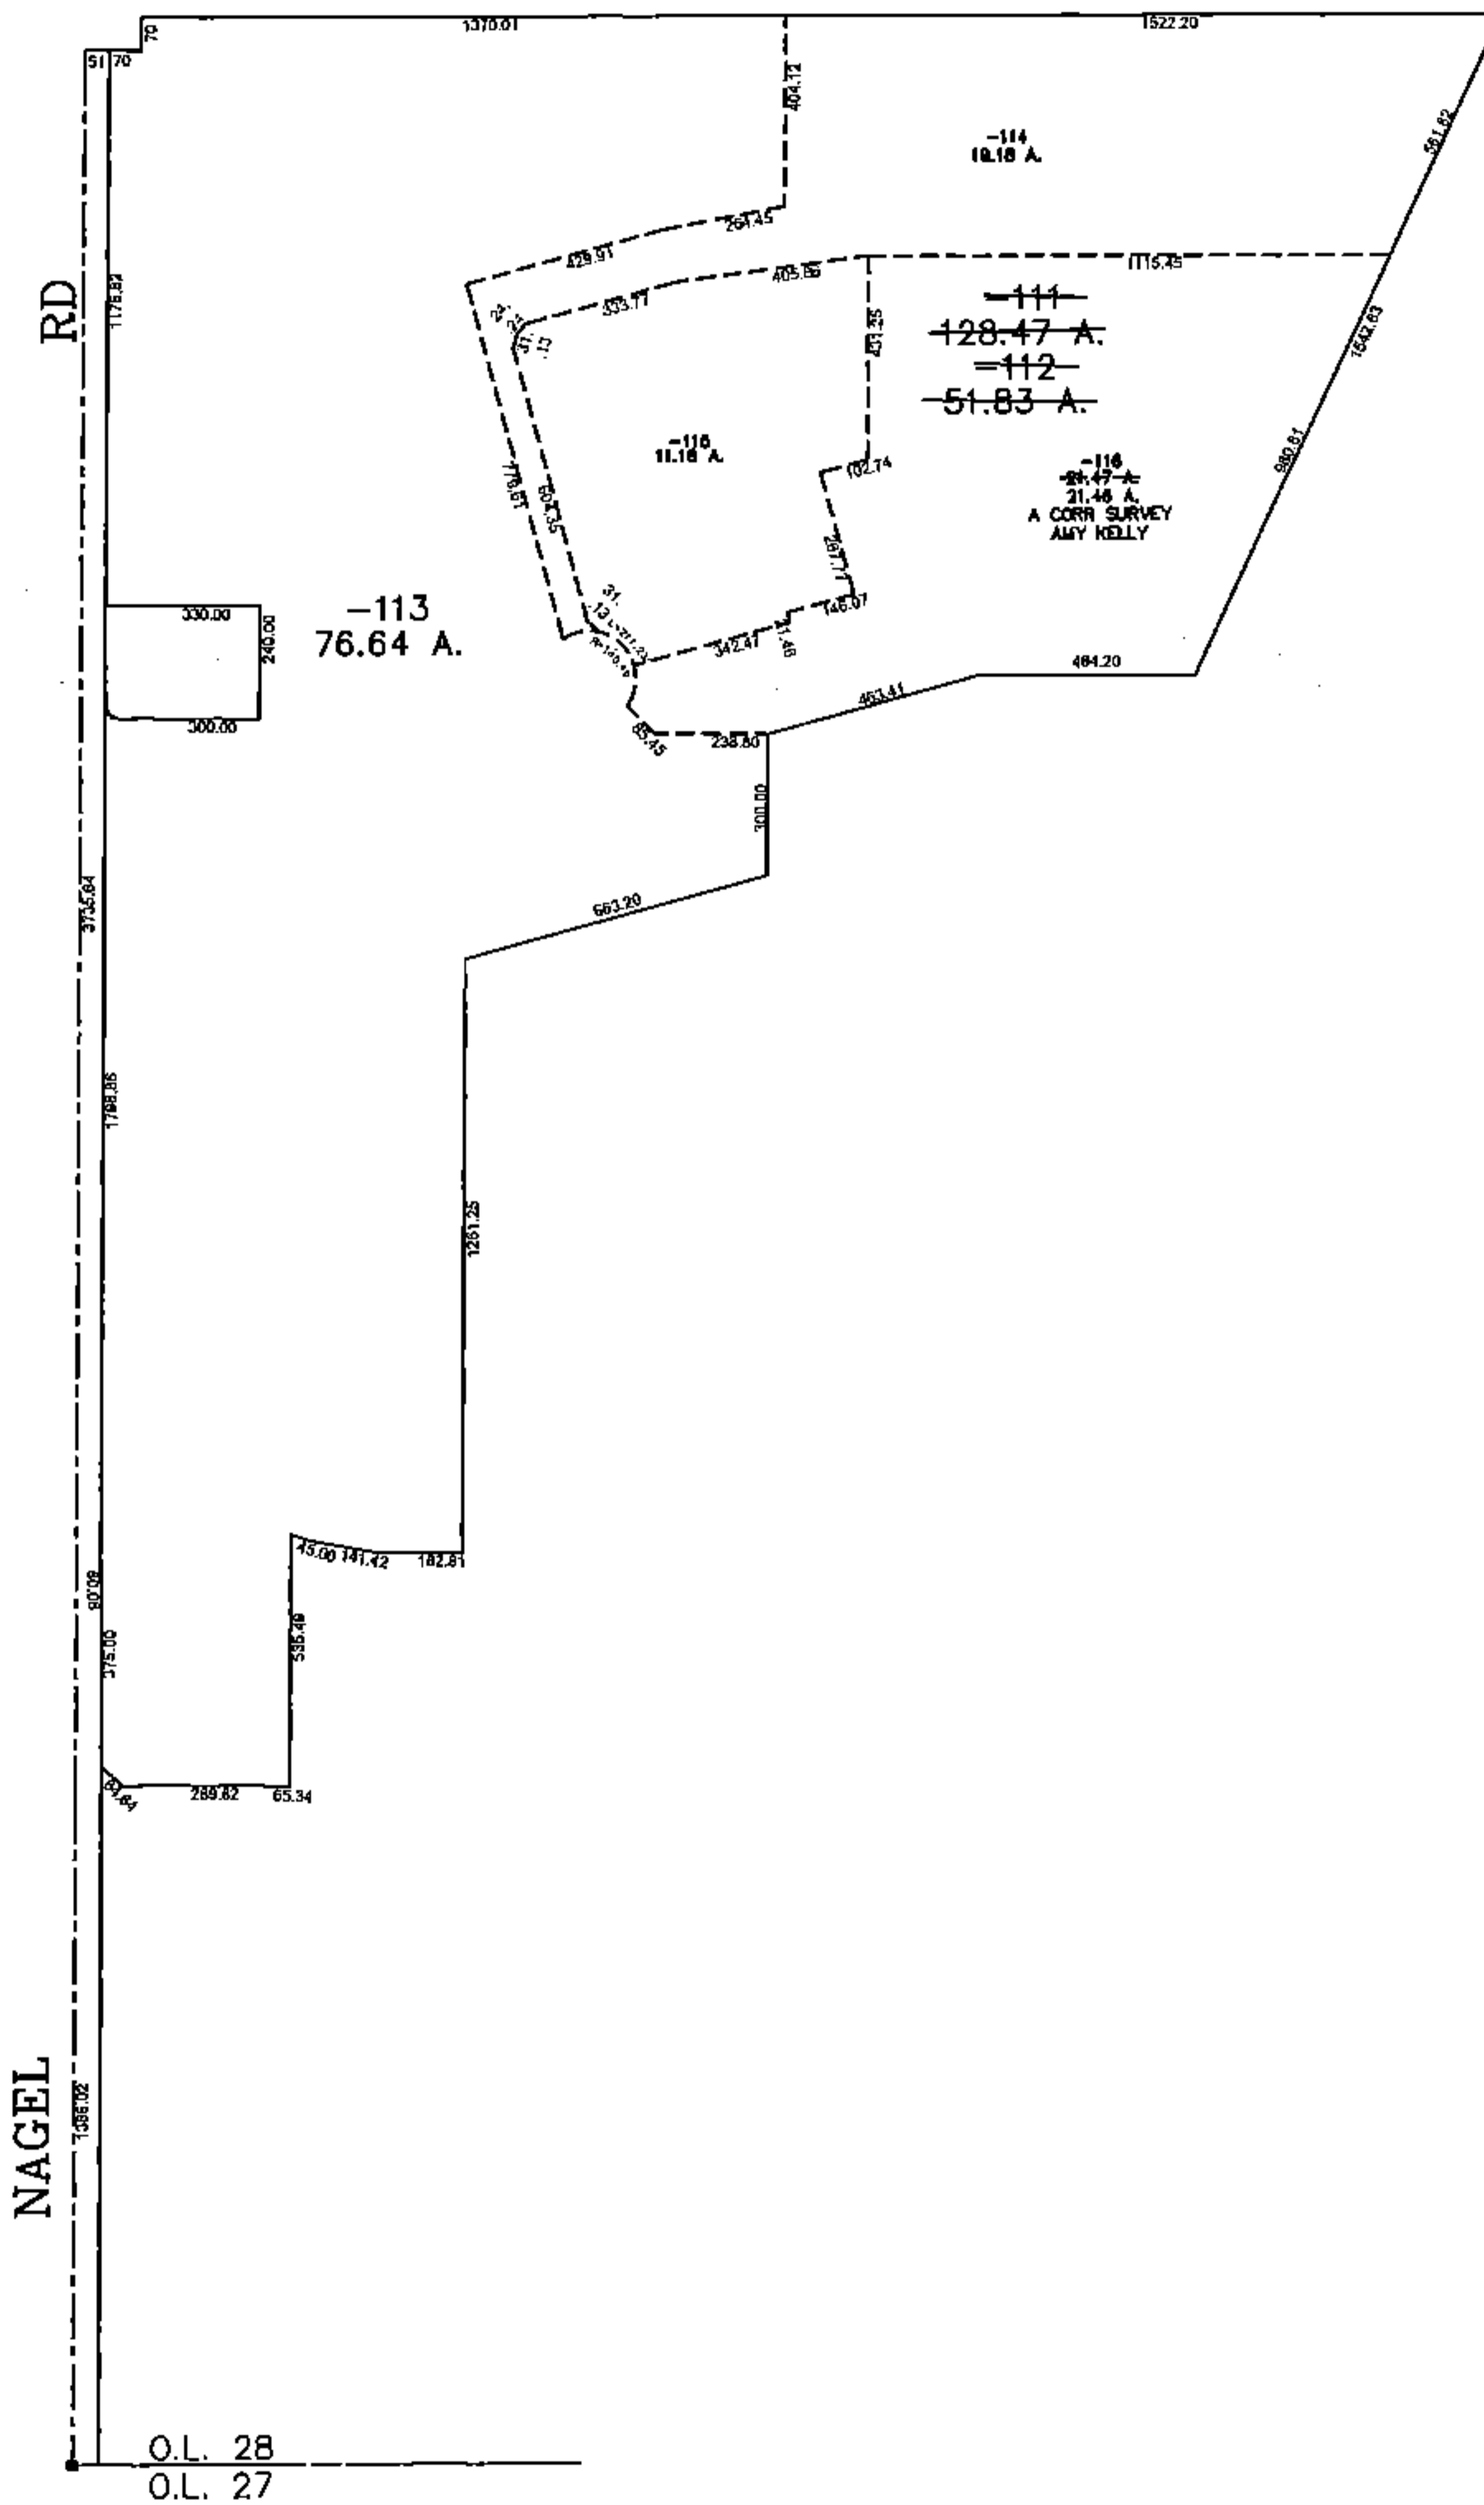

SPLITS/DEEDS PROCESSED

LORAIN COUNTY TAX MAP DEPARTMENT
226 MIDDLE AVE. ELYRIA, OHIO

SURVEYED BY: AMY KELLY & PETER ZWICK

CLOSURE: 0.00 : 10.000

MAP PAGE(S): 04-00-028

APPROVED BY: JAH DATE: 12/11/2014

SCALE: 1" = 700' PRIOR INSTRUMENT: 20130482288