
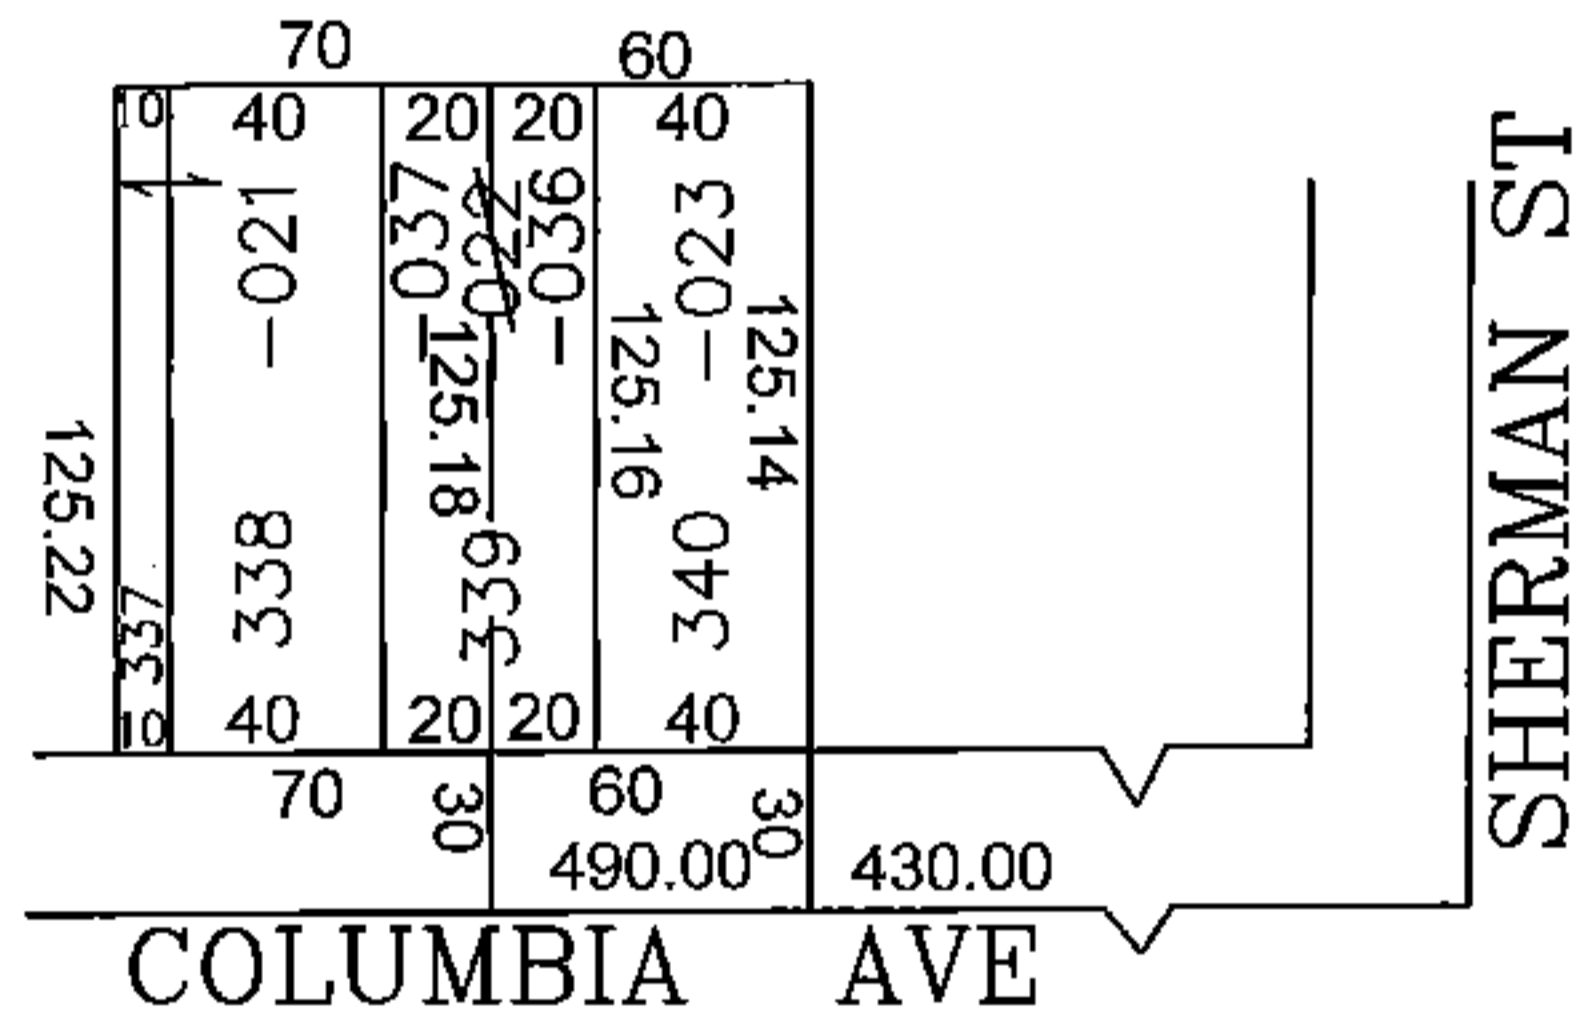


PARENT PARCEL: 06-25-004-101-022, -023, -021

CHILD PARCEL: 06-25-004-101-036, -037

STARTING POINT: CENTERLINE OF COLUMBIA AVE & SHERMAN ST

14-03320

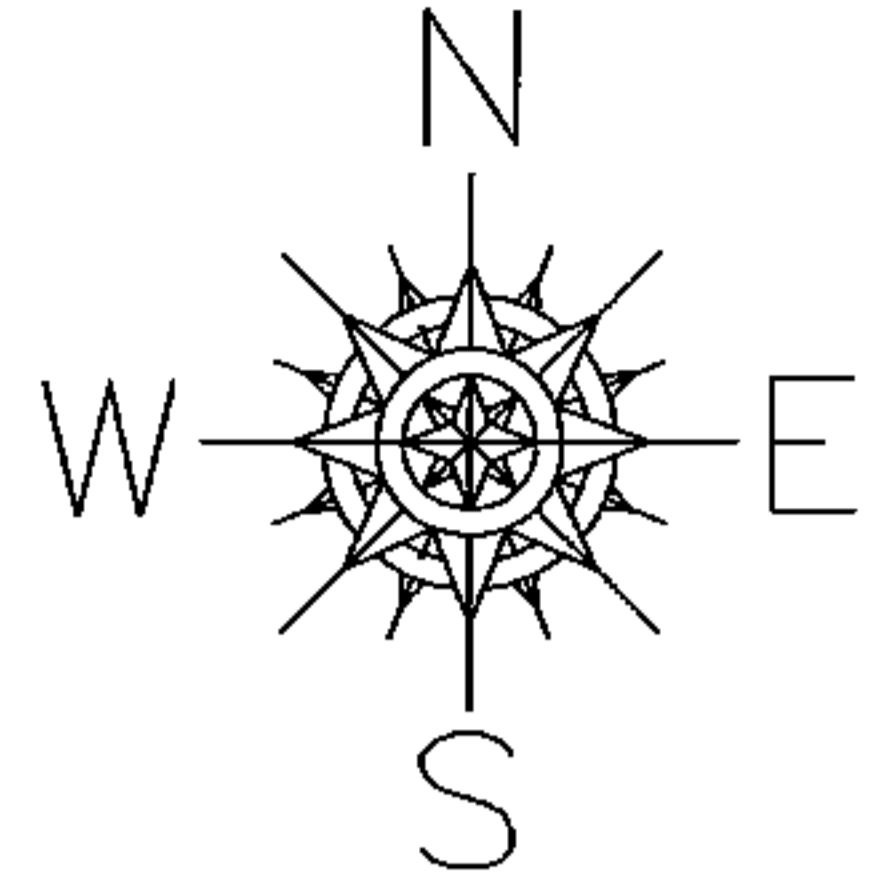

SPLITS/DEEDS PROCESSED

LORAIN COUNTY TAX MAP DEPARTMENT
226 MIDDLE AVE. ELYRIA, OHIO

SURVEYED BY: THOMAS SIMON
CLOSURE: 0.00 : 10,000
MAP PAGE(S): 6-139
APPROVED BY: JAH DATE: 12/10/2014
SCALE: 1" = 100 PRIOR INSTRUMENT: 20140499304