
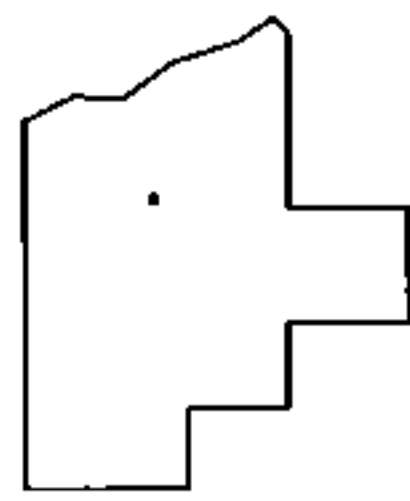
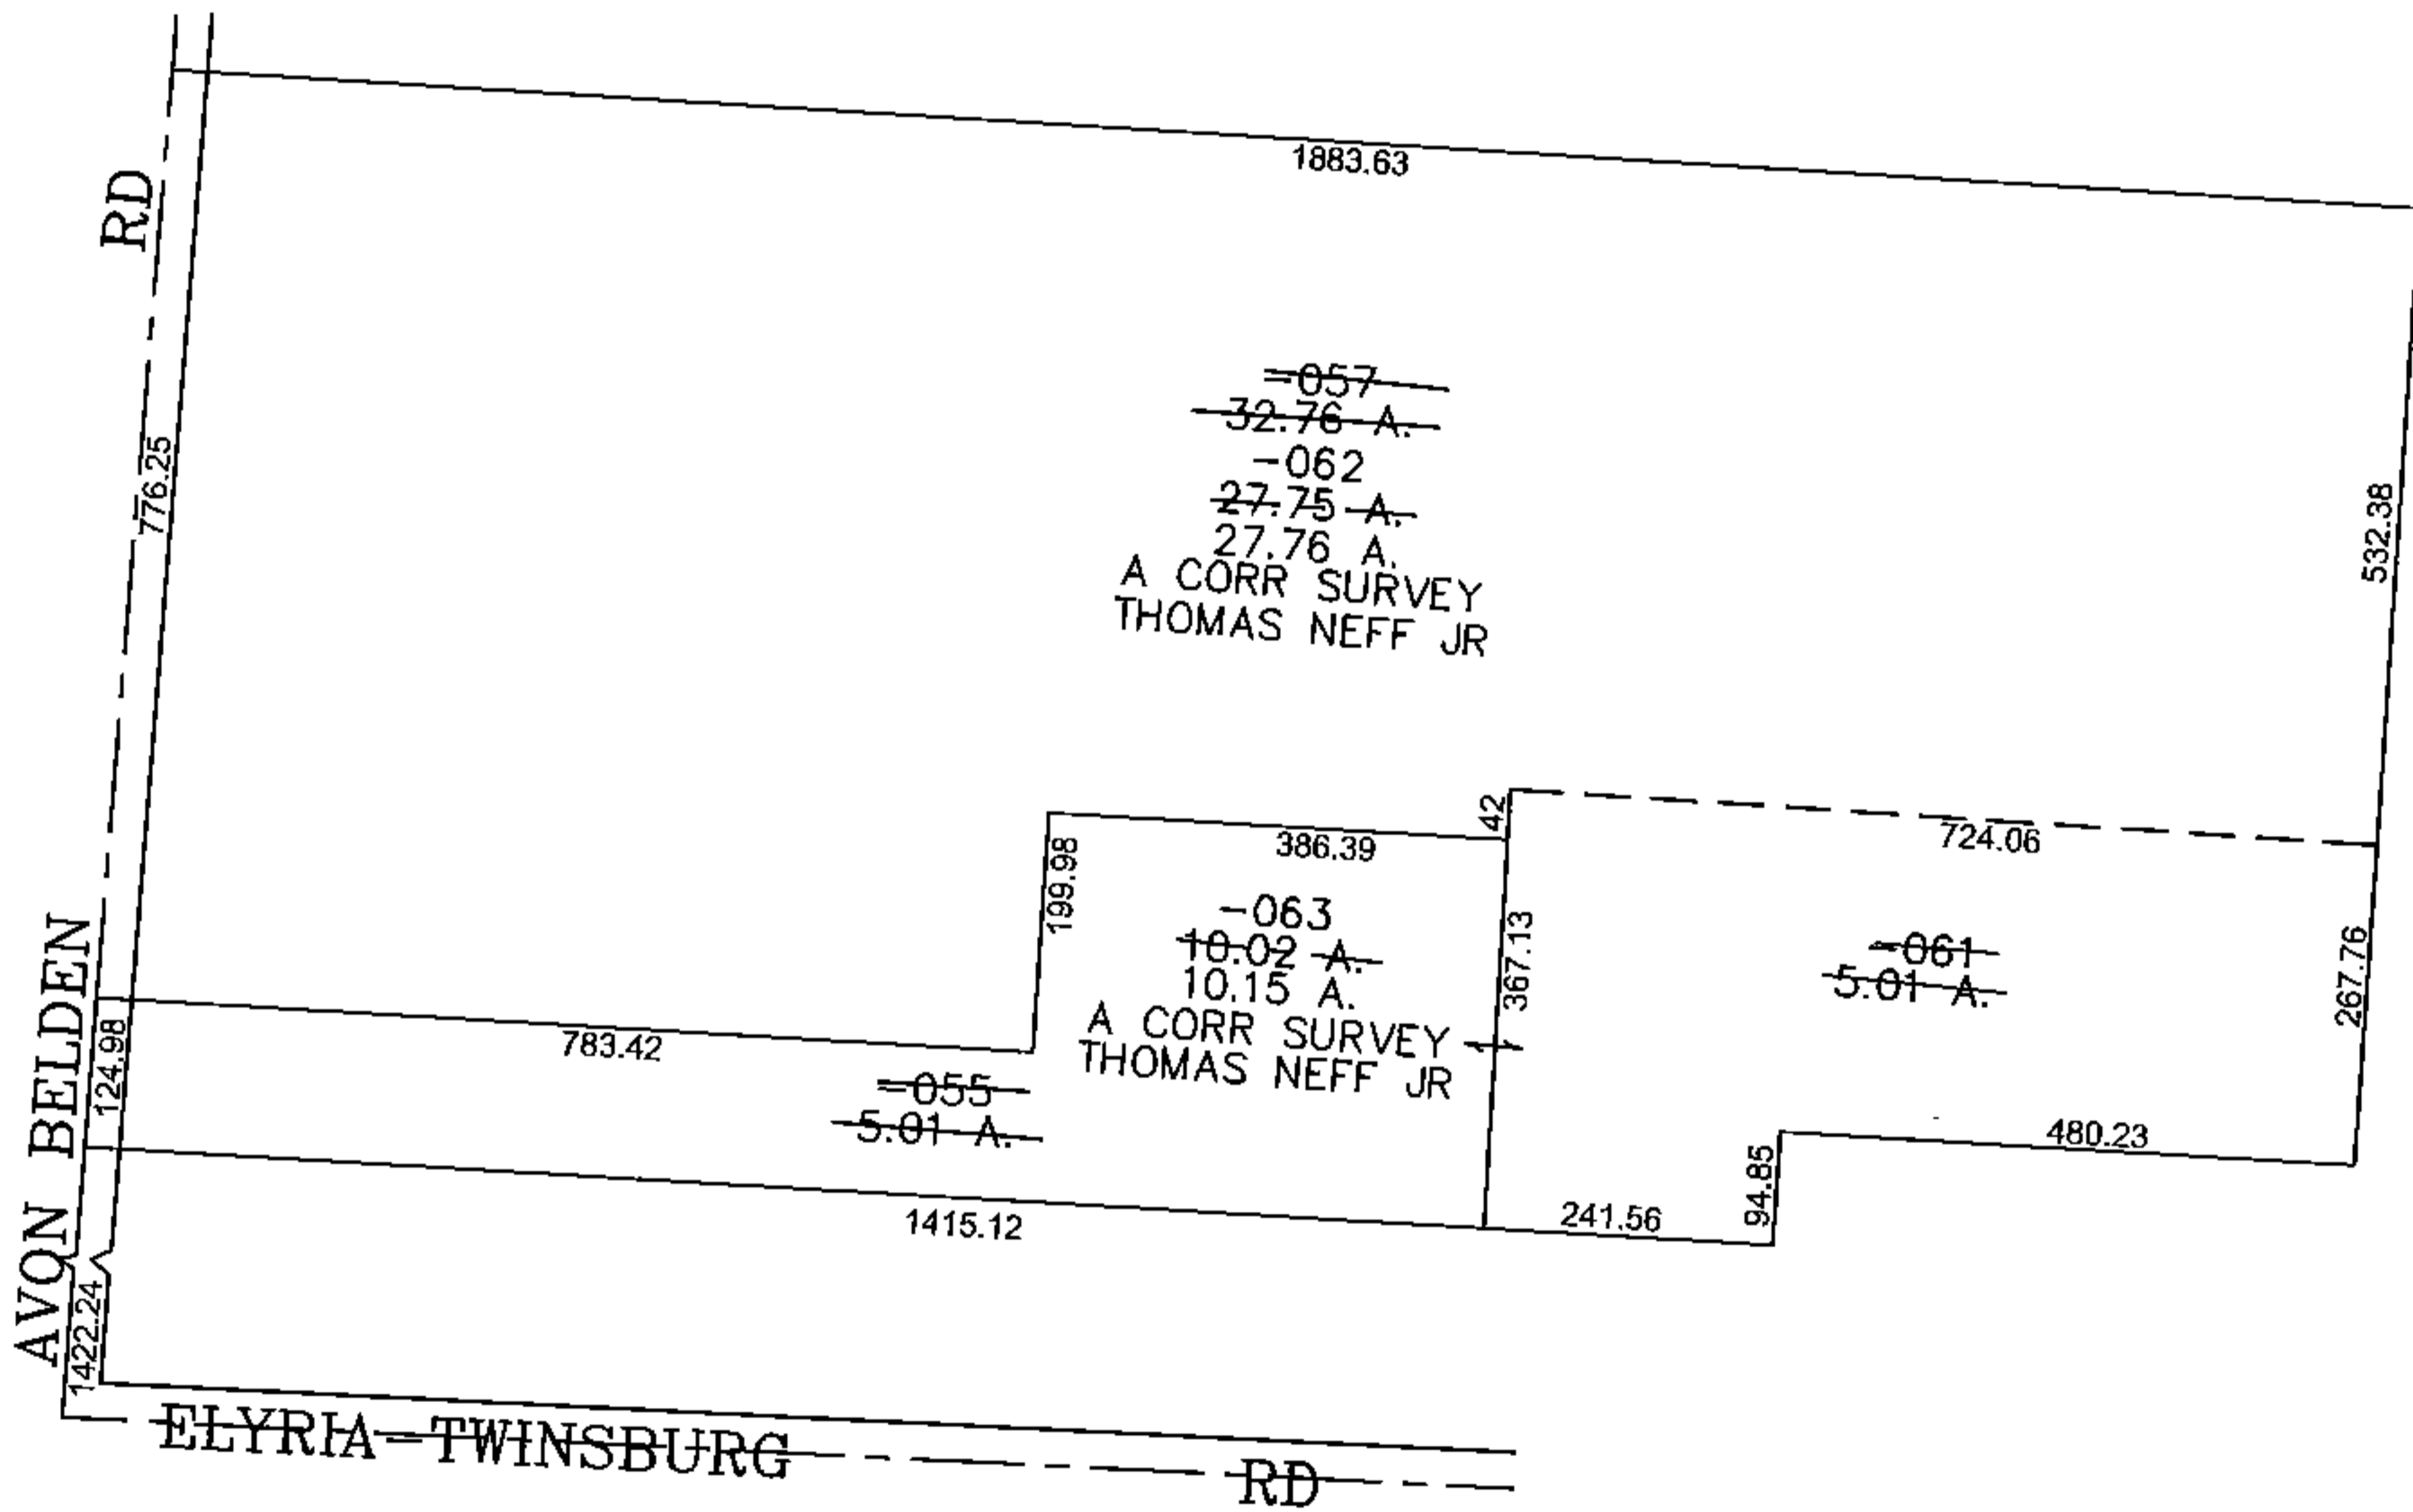


PARENT PARCEL: 11-00-046-000-057

CHILD PARCEL: 11-00-046-000-061, -062, -063

STARTING POINT: CENTERLINE OF AVON BELDEN RD & ELYRIA TWINSBURG RD

14-03324

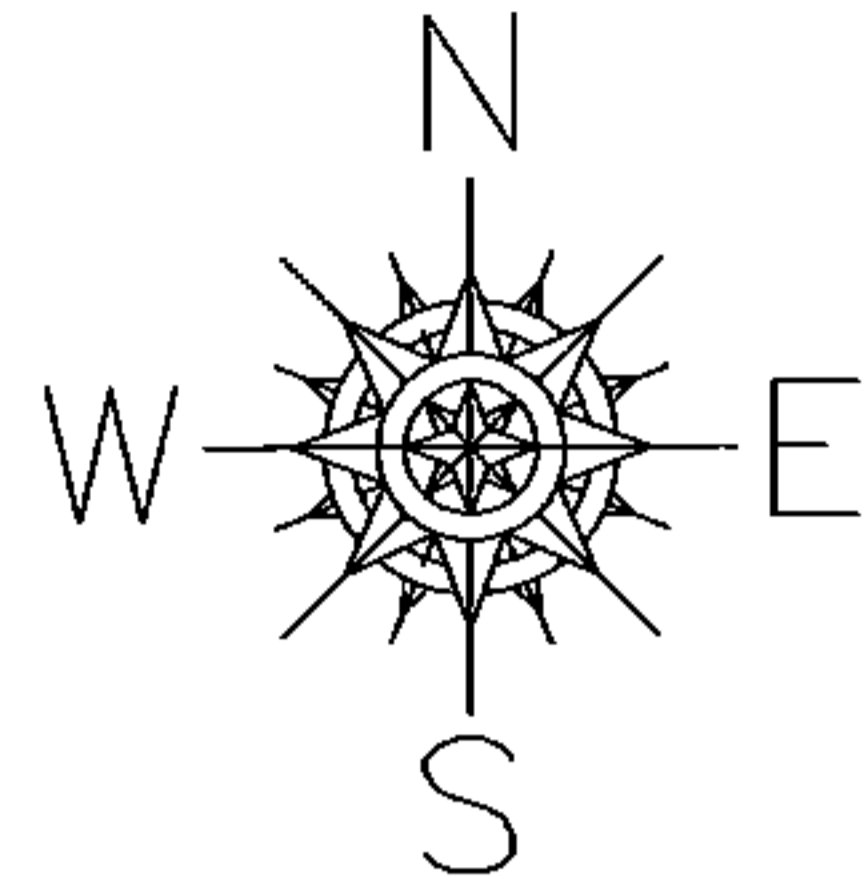

**SPLITS/DEEDS PROCESSED**  
 LORAIN COUNTY TAX MAP DEPARTMENT  
 226 MIDDLE AVE. ELYRIA, OHIO

SURVEYED BY: THOMAS NEFF JR  
 CLOSURE: 0.00 : 10.000  
 MAP PAGE(S): 11-C 11-00-047-B  
 APPROVED BY: JAH DATE: 12-16-2014  
 SCALE: 1" = 300 PRIOR INSTRUMENT: 20100332875