
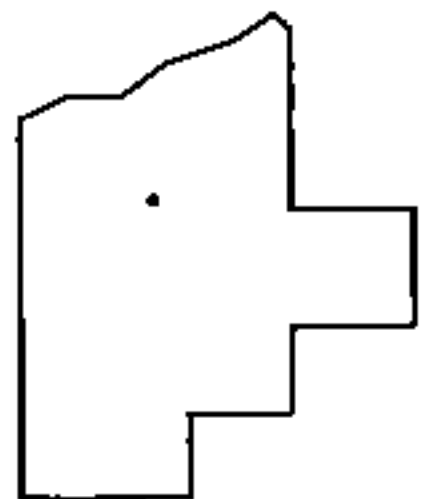
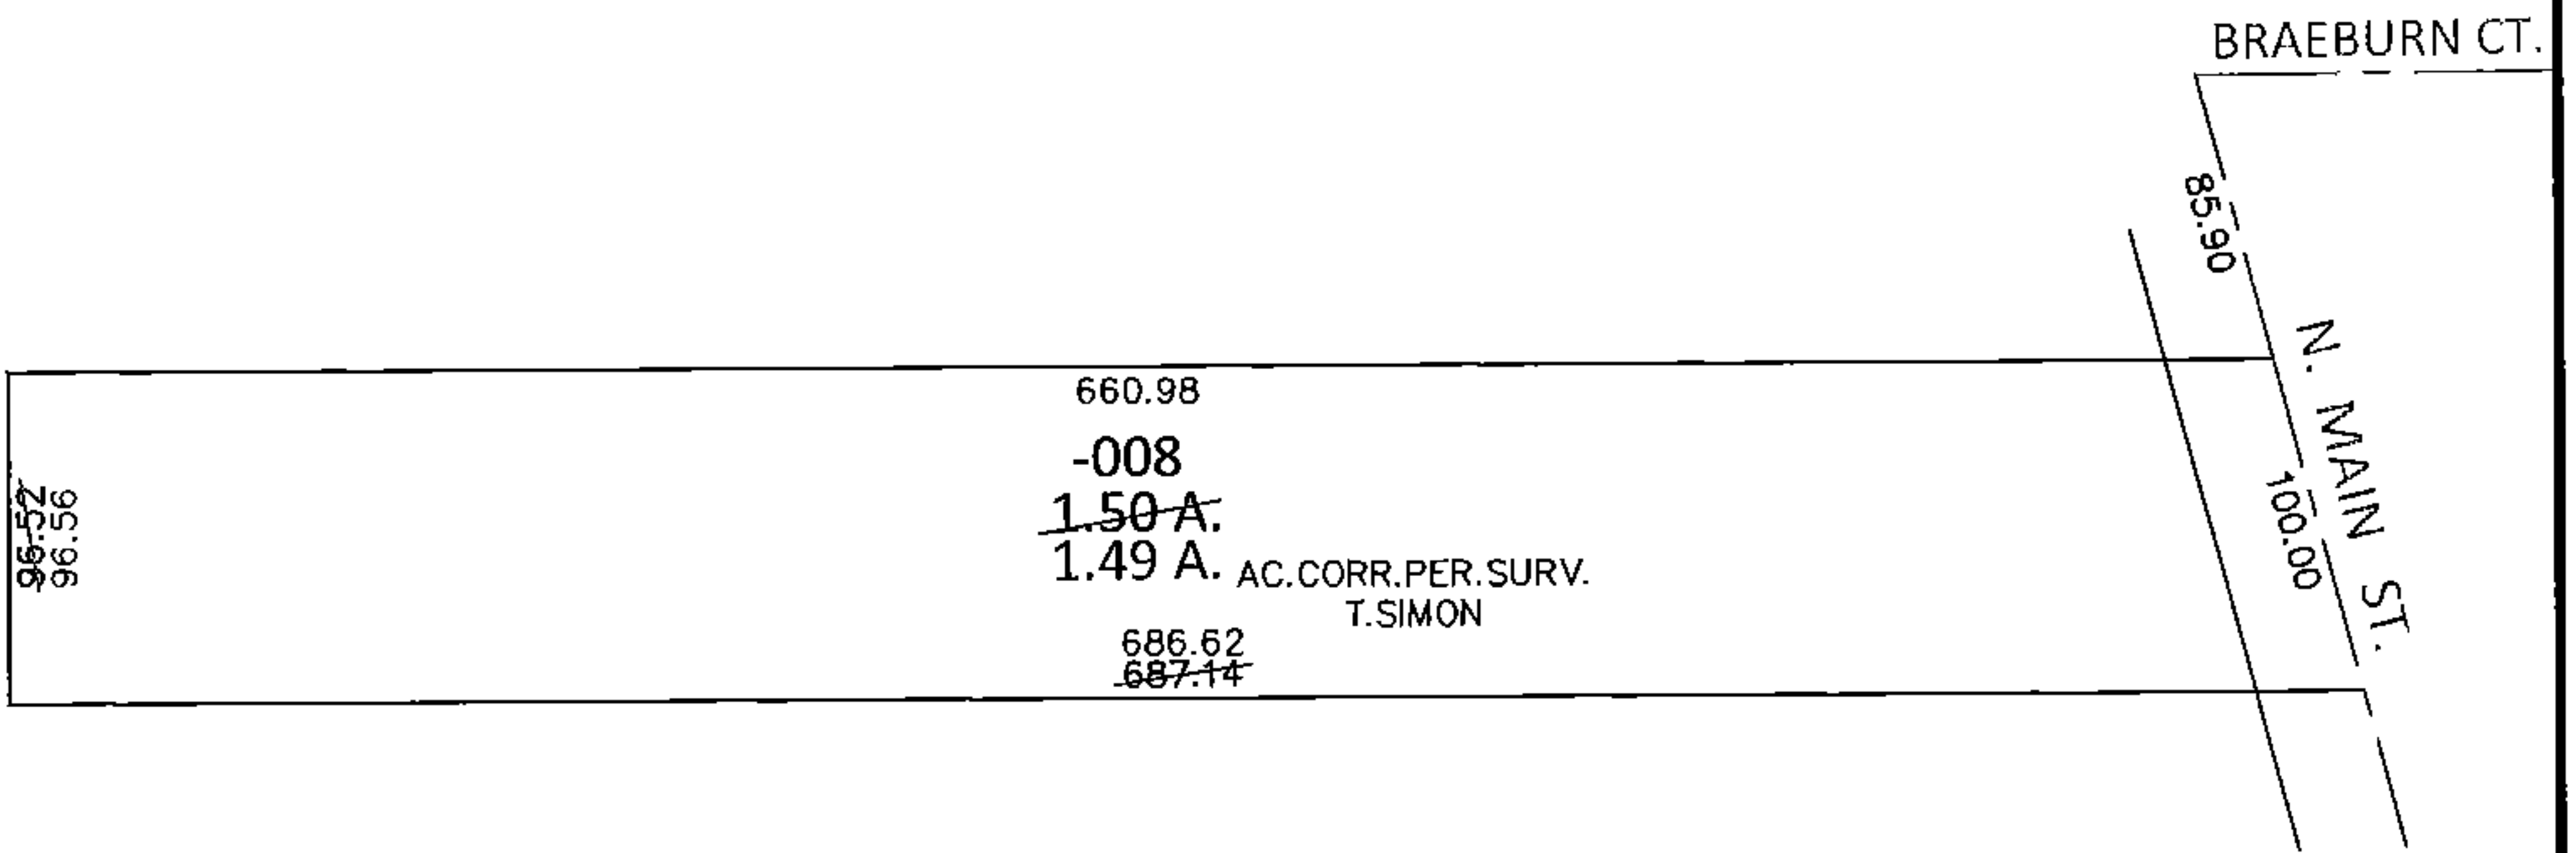


PARENT PARCEL: 02-02-001-101-008

CHILD PARCEL: _____

STARTING POINT: INTERSECTION OF C/L OF N.MAIN ST. AND C/L OF BRAEBURN CT.

15-03325-X

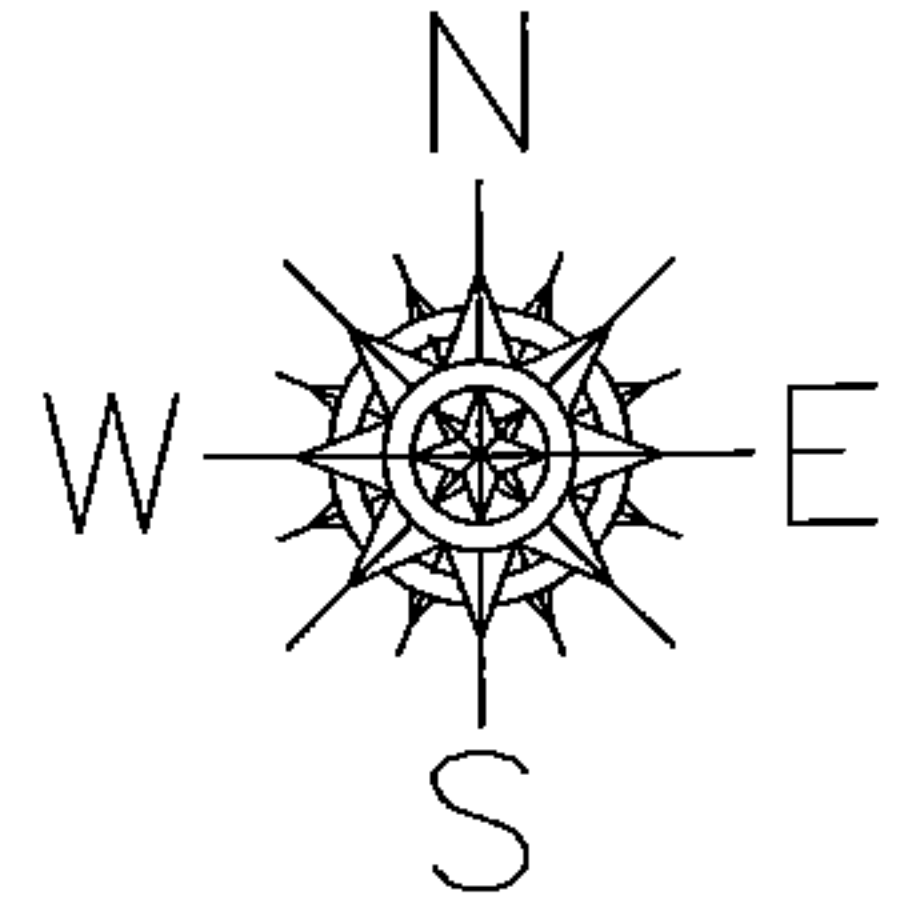

SPLITS/DEEDS PROCESSED

LORAIN COUNTY TAX MAP DEPARTMENT
226 MIDDLE AVE. ELYRIA, OHIO

SURVEYED BY: THOMAS A. SIMON

CLOSURE: .01:10,000

MAP PAGE(S): 2-02-001-A

APPROVED BY: RRM DATE: 10-28-15

SCALE: 1"= 100 PRIOR INST.: 20150534839