


PARENT PARCEL: 13-11-006-000-013, 003 008 13-11-015-101-005, -008
 CHILD PARCEL: 13-11-006-000-015 THRU -017 13-11-015-101-008
 STARTING POINT: CENTERLINE OF ST RT 511 AND NORTHERLY LINE OF CAMDEN TWP

14-03326

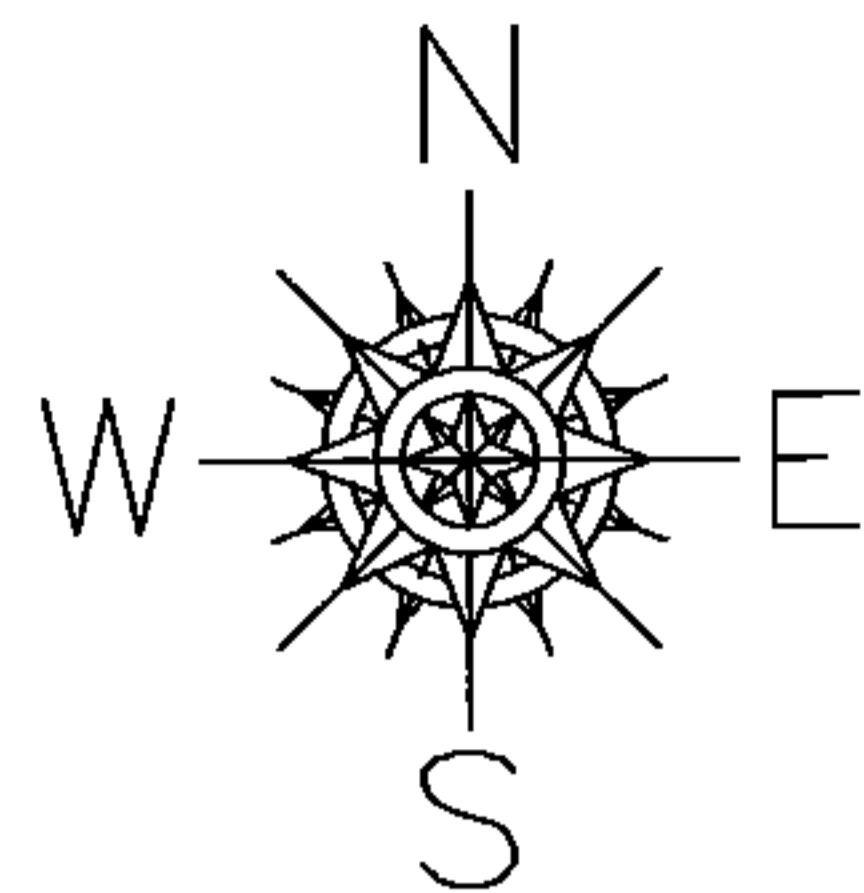

HENRIETTA TWP
 CAMDEN TWP

511

~~-013~~
~~56.28 A.~~
~~-016~~
 46.18 A.

KIPTON VILL
 CAMDEN TWP

680.10

~~-008~~
 0.16 A.

599.89
~~-003~~
~~3.85 A.~~
~~-017~~
~~4.0 A.~~
 3.76 A.

~~-015~~
 5.66 A.

A CORR PER SURVEY
 THOMAS SIMON

576.56

550.13
 0.6
 O.L. 15

~~-008~~
 4.44 A.

ST RT


~~-005~~
~~3.86 A.~~
 4.19 A.
 A CORR PER SURVEY
 THOMAS SIMON

60.80

864.41

30.94

390.86

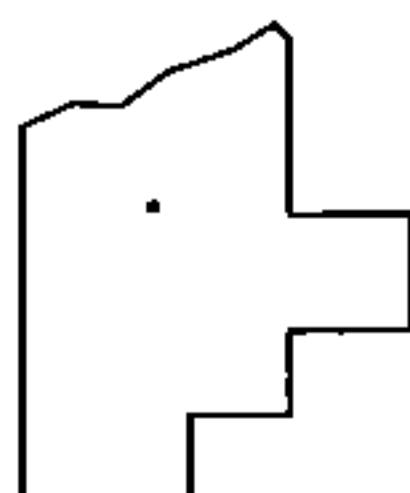

SPLITS/DEEDS PROCESSED
 LORAIN COUNTY TAX MAP DEPARTMENT
 226 MIDDLE AVE. ELYRIA, OHIO

SURVEYED BY: THOMAS SIMON
 CLOSURE: 0.01 : 10,000
 MAP PAGE(S): 13-C
 APPROVED BY: JAH DATE: 12/18/2014
 SCALE: 1" = 200' PRIOR INSTRUMENT: 19990640295