


PARENT PARCEL: 04-00-026-110-007



CHILD PARCEL: \_\_\_\_\_

STARTING POINT: AT A MON BOX AT THE INTERSECTION OF C/L OF SCHWARTZ RD. AND EAST LINE OF LORAIN COUNTY

15-03328-C

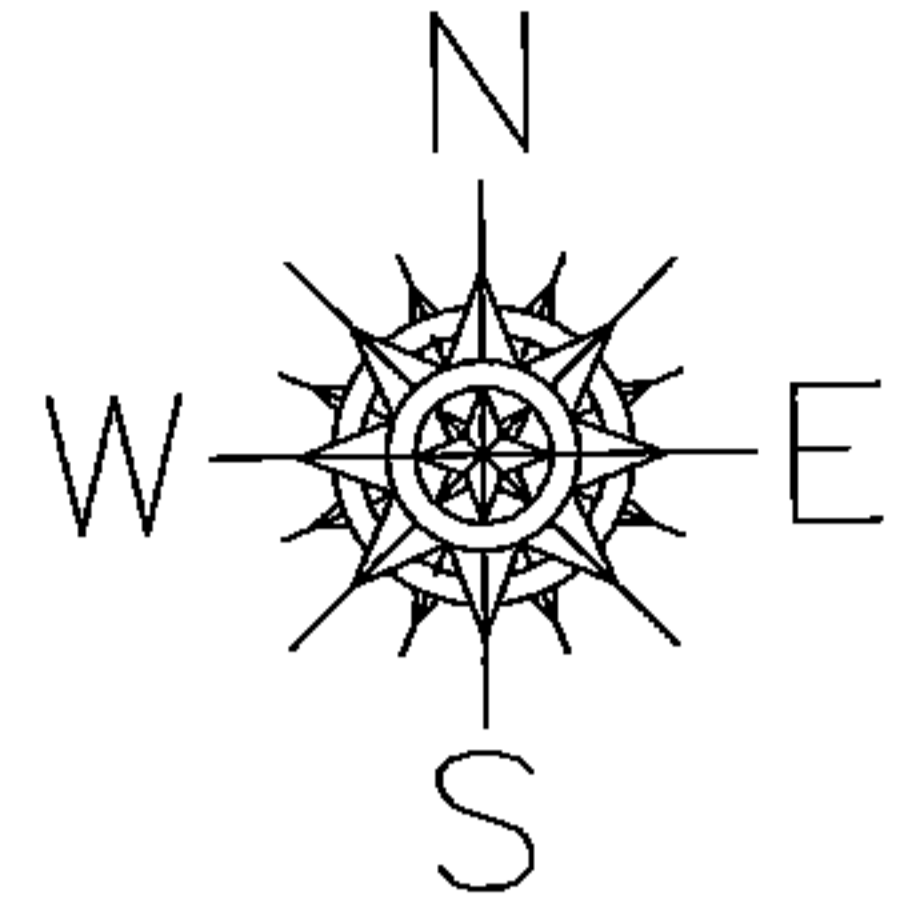

MAP CORRECTION ONLY

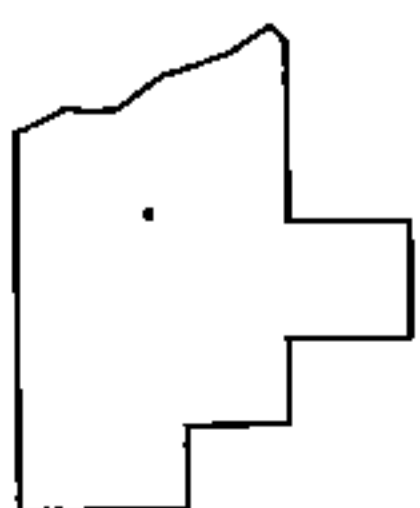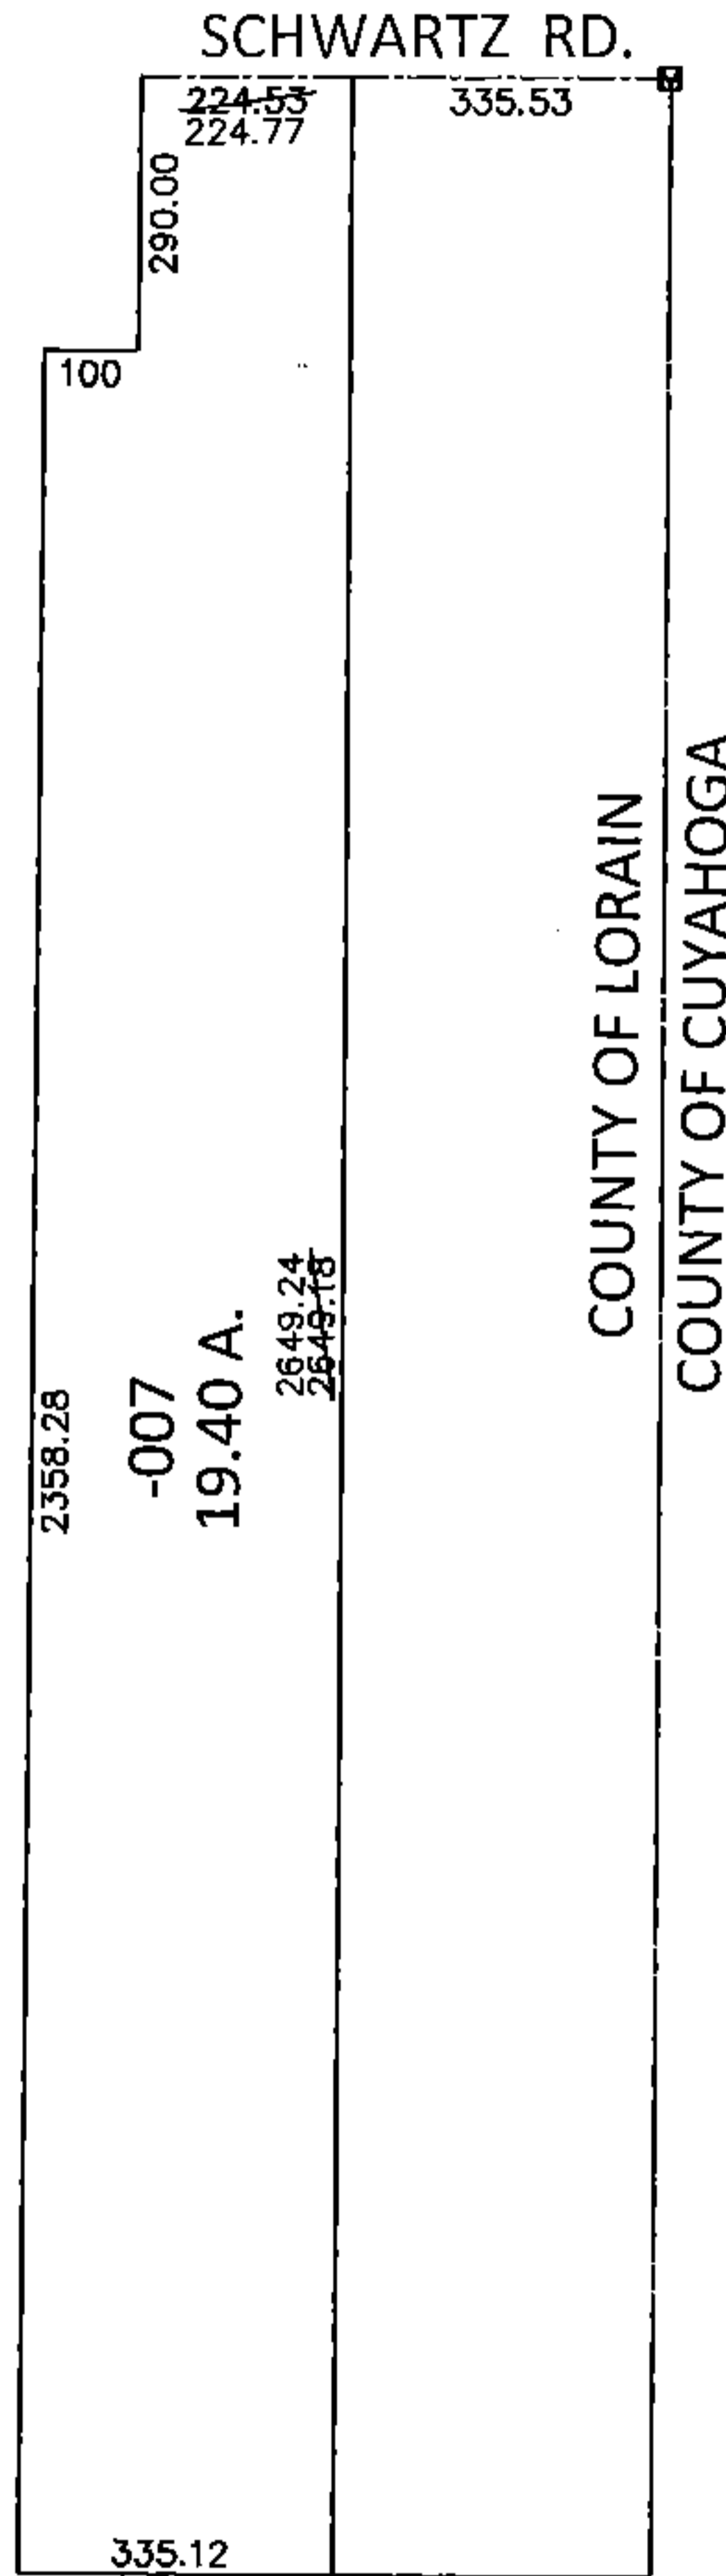

SPLITS/DEEDS PROCESSED

LORAIN COUNTY TAX MAP DEPARTMENT  
226 MIDDLE AVE. ELYRIA, OHIO

SURVEYED BY: STUART W. SAYLER

CLOSURE: .01:10,000

MAP PAGE(S): 4-00-026-H

APPROVED BY: RRM DATE: 11-2-15

SCALE: 1"= 400 PRIOR INST.: 20030940261