
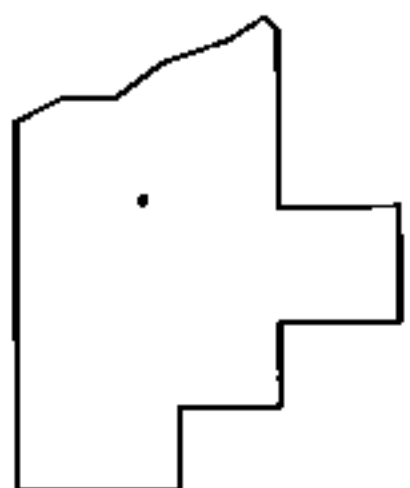
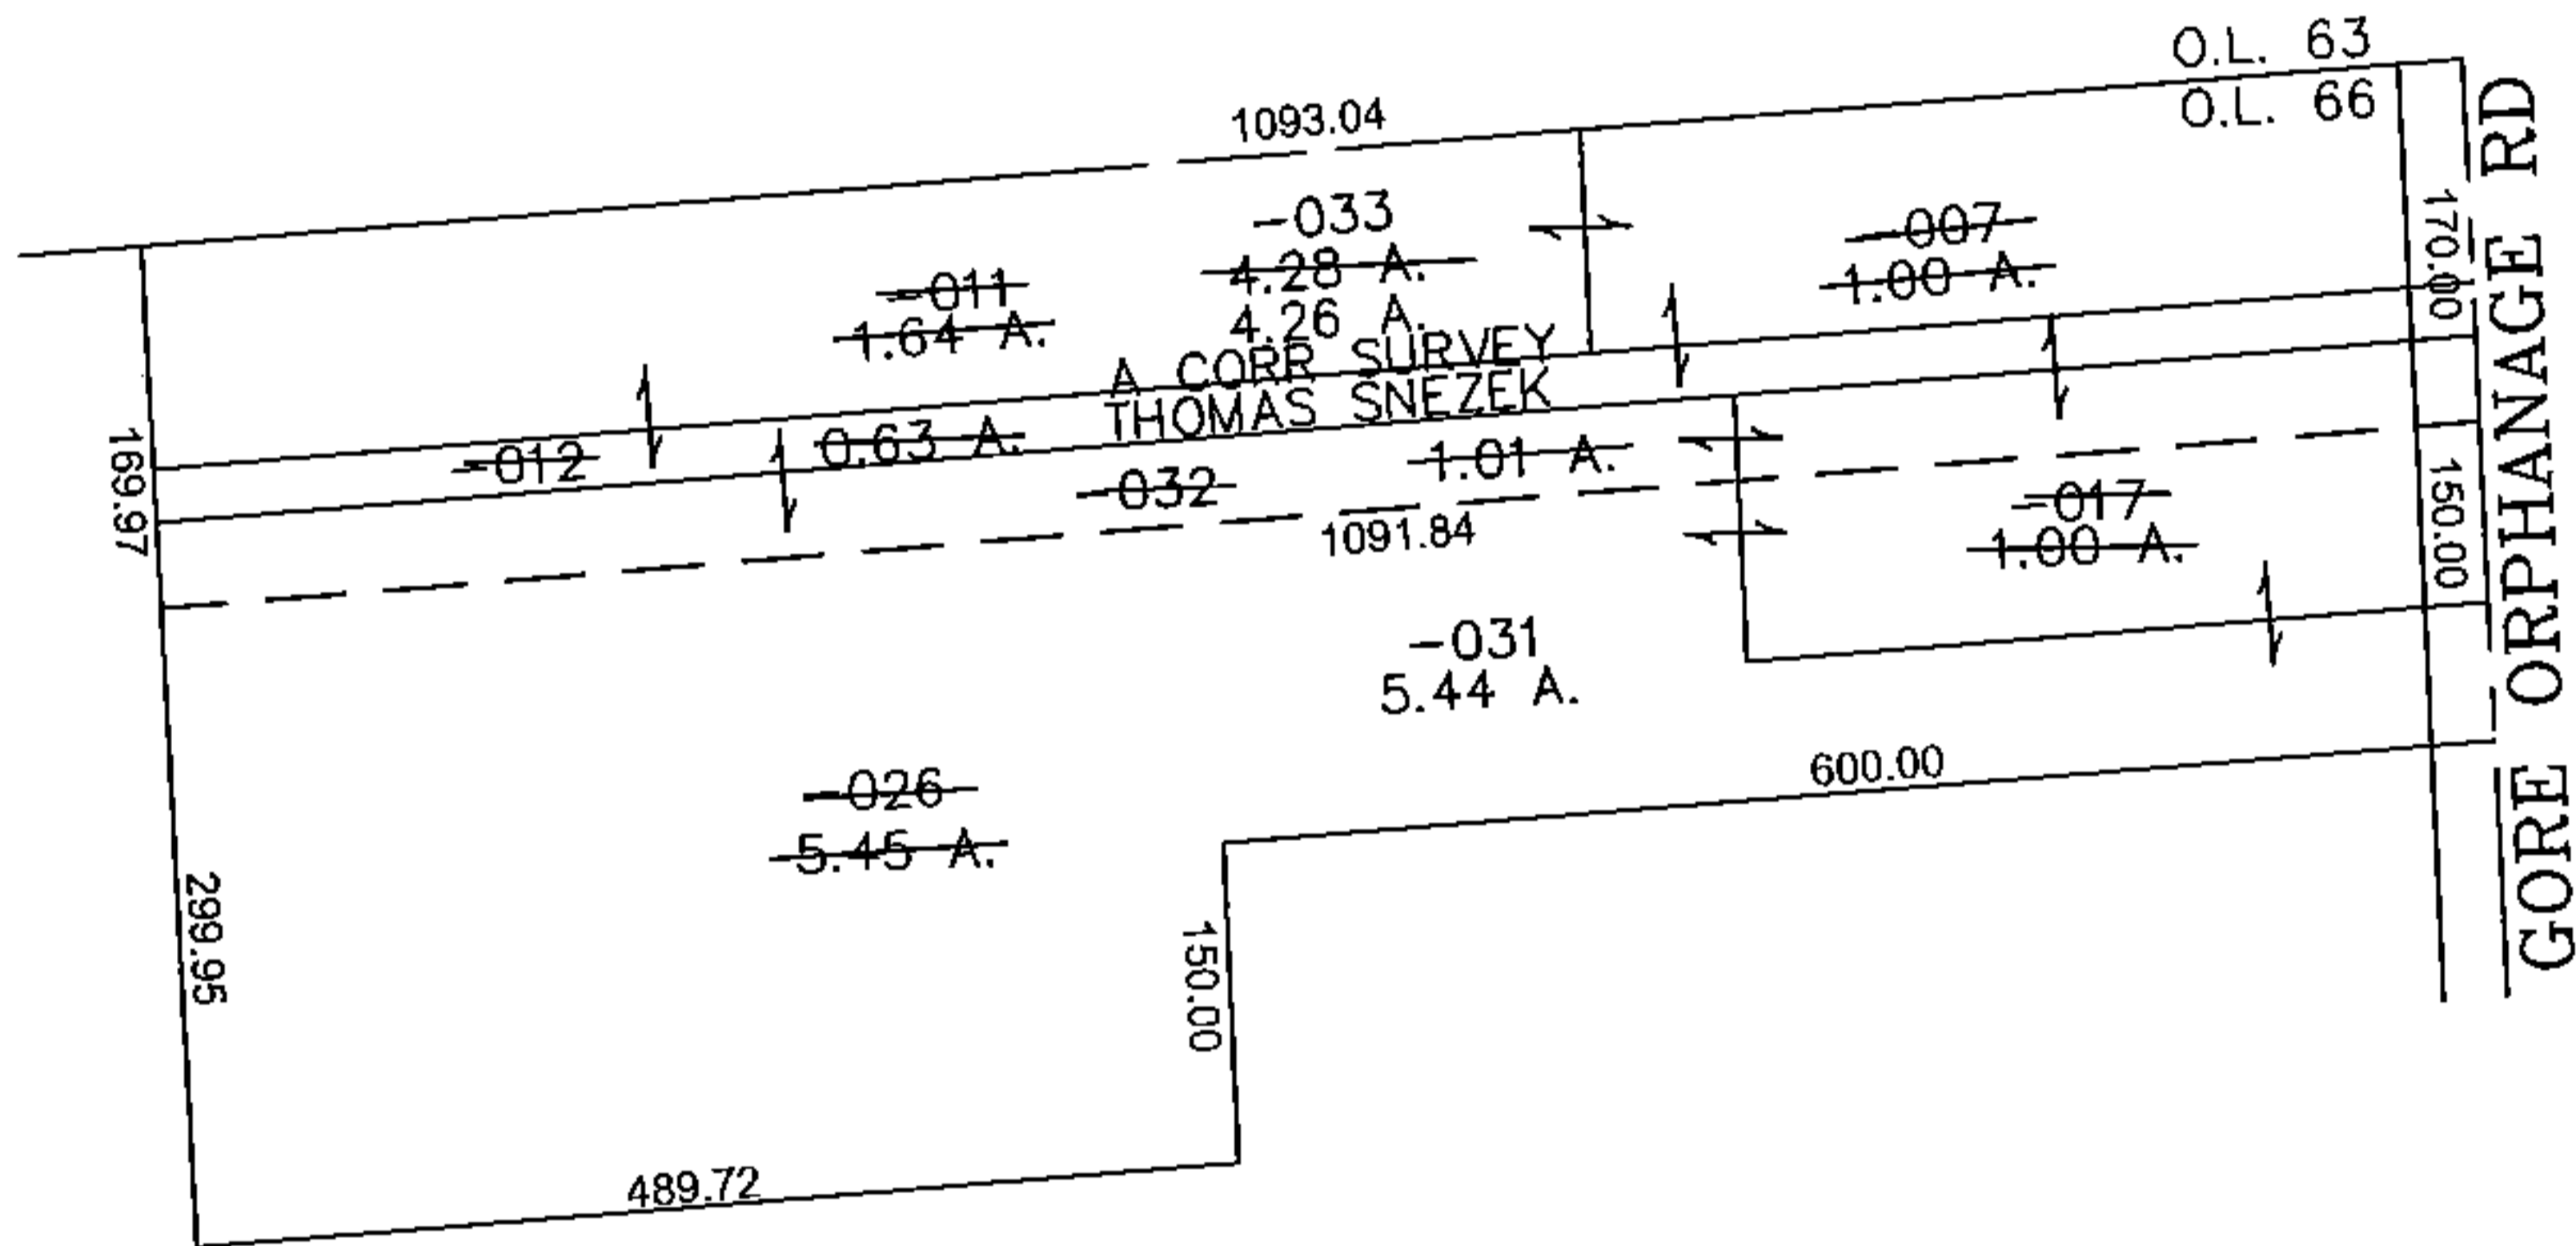


PARENT PARCEL: 01-00-066-000-017, -026, -007, -011, -012  
 CHILD PARCEL: 01-00-066-000-031, -032, -033  
 STARTING POINT: CENTERLINE OF GORE ORPHANAGE RD & O.L. 66

14-03328

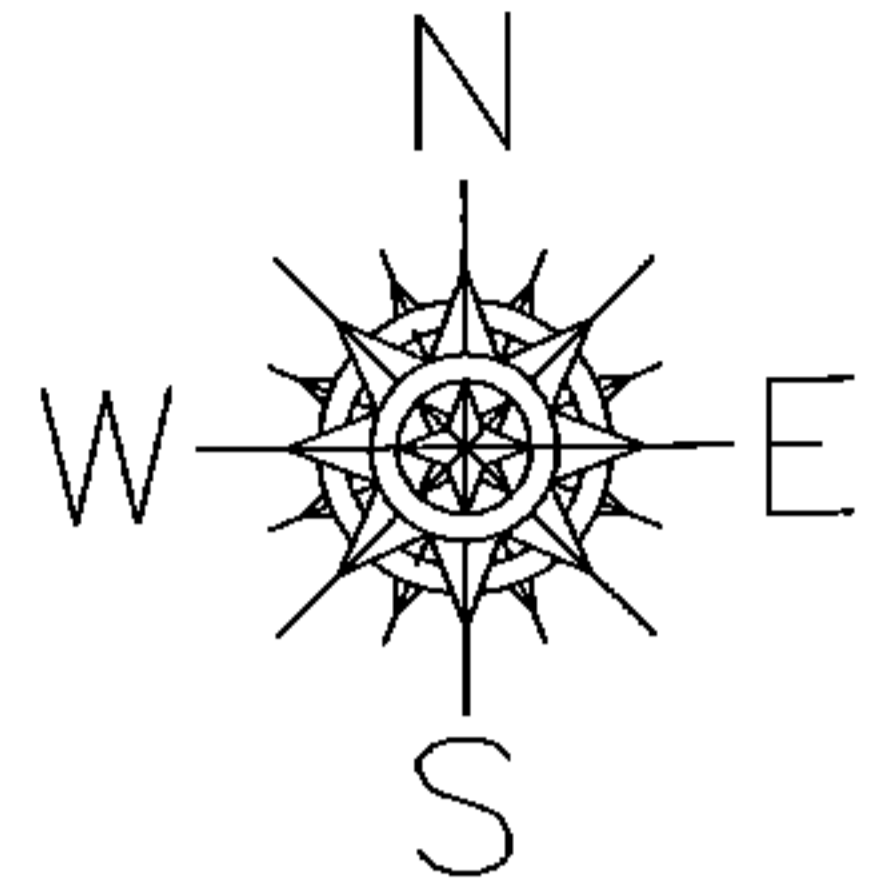

**SPLITS/DEEDS PROCESSED**  
 LORAIN COUNTY TAX MAP DEPARTMENT  
 226 MIDDLE AVE. ELYRIA, OHIO

SURVEYED BY: THOMAS SNEZEK  
 CLOSURE: 0.00 : 10.000  
 MAP PAGE(S): 01-00-066  
 APPROVED BY: JAH DATE: 12/22/2014  
 SCALE: 1" = 200 PRIOR INSTRUMENT: 20070184024