


PARENT PARCEL: 16-00-003-101-011, -012



CHILD PARCEL: 16-00-003-101-063, -064

STARTING POINT: CENTERLINE OF ELM ST & O.L. 3

14-03329

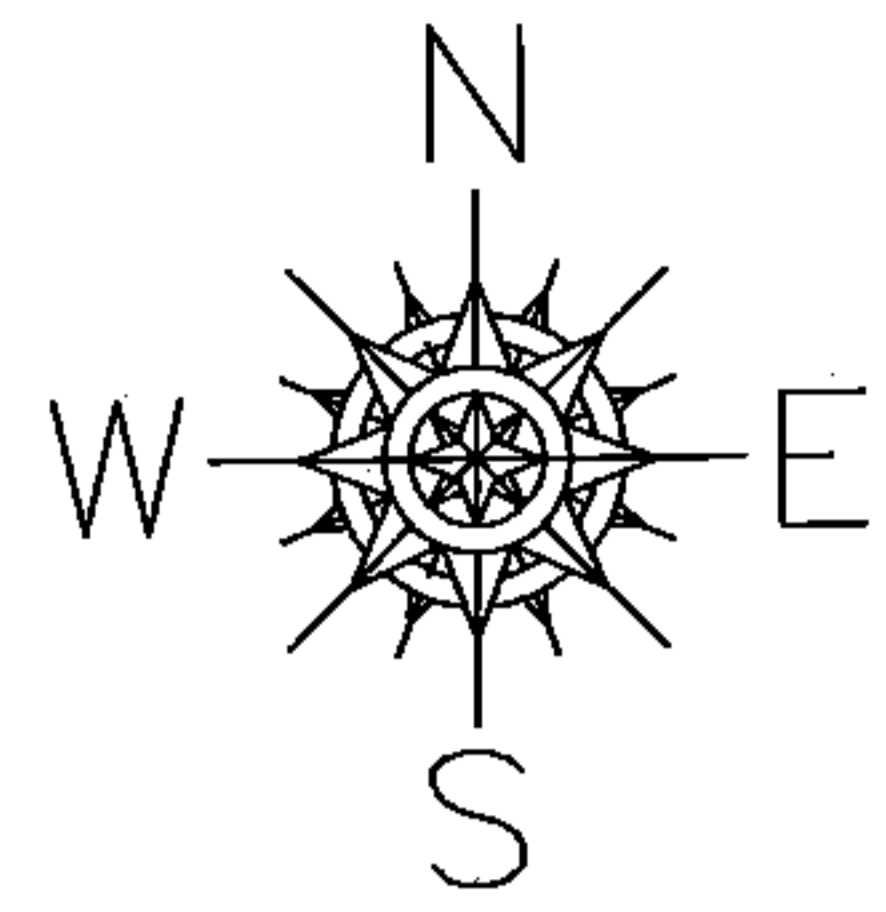

O.L. 80 EATON TWP
O.L. 3 GRAFTON TWP

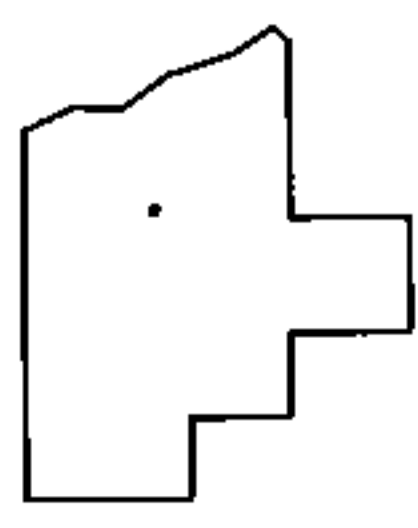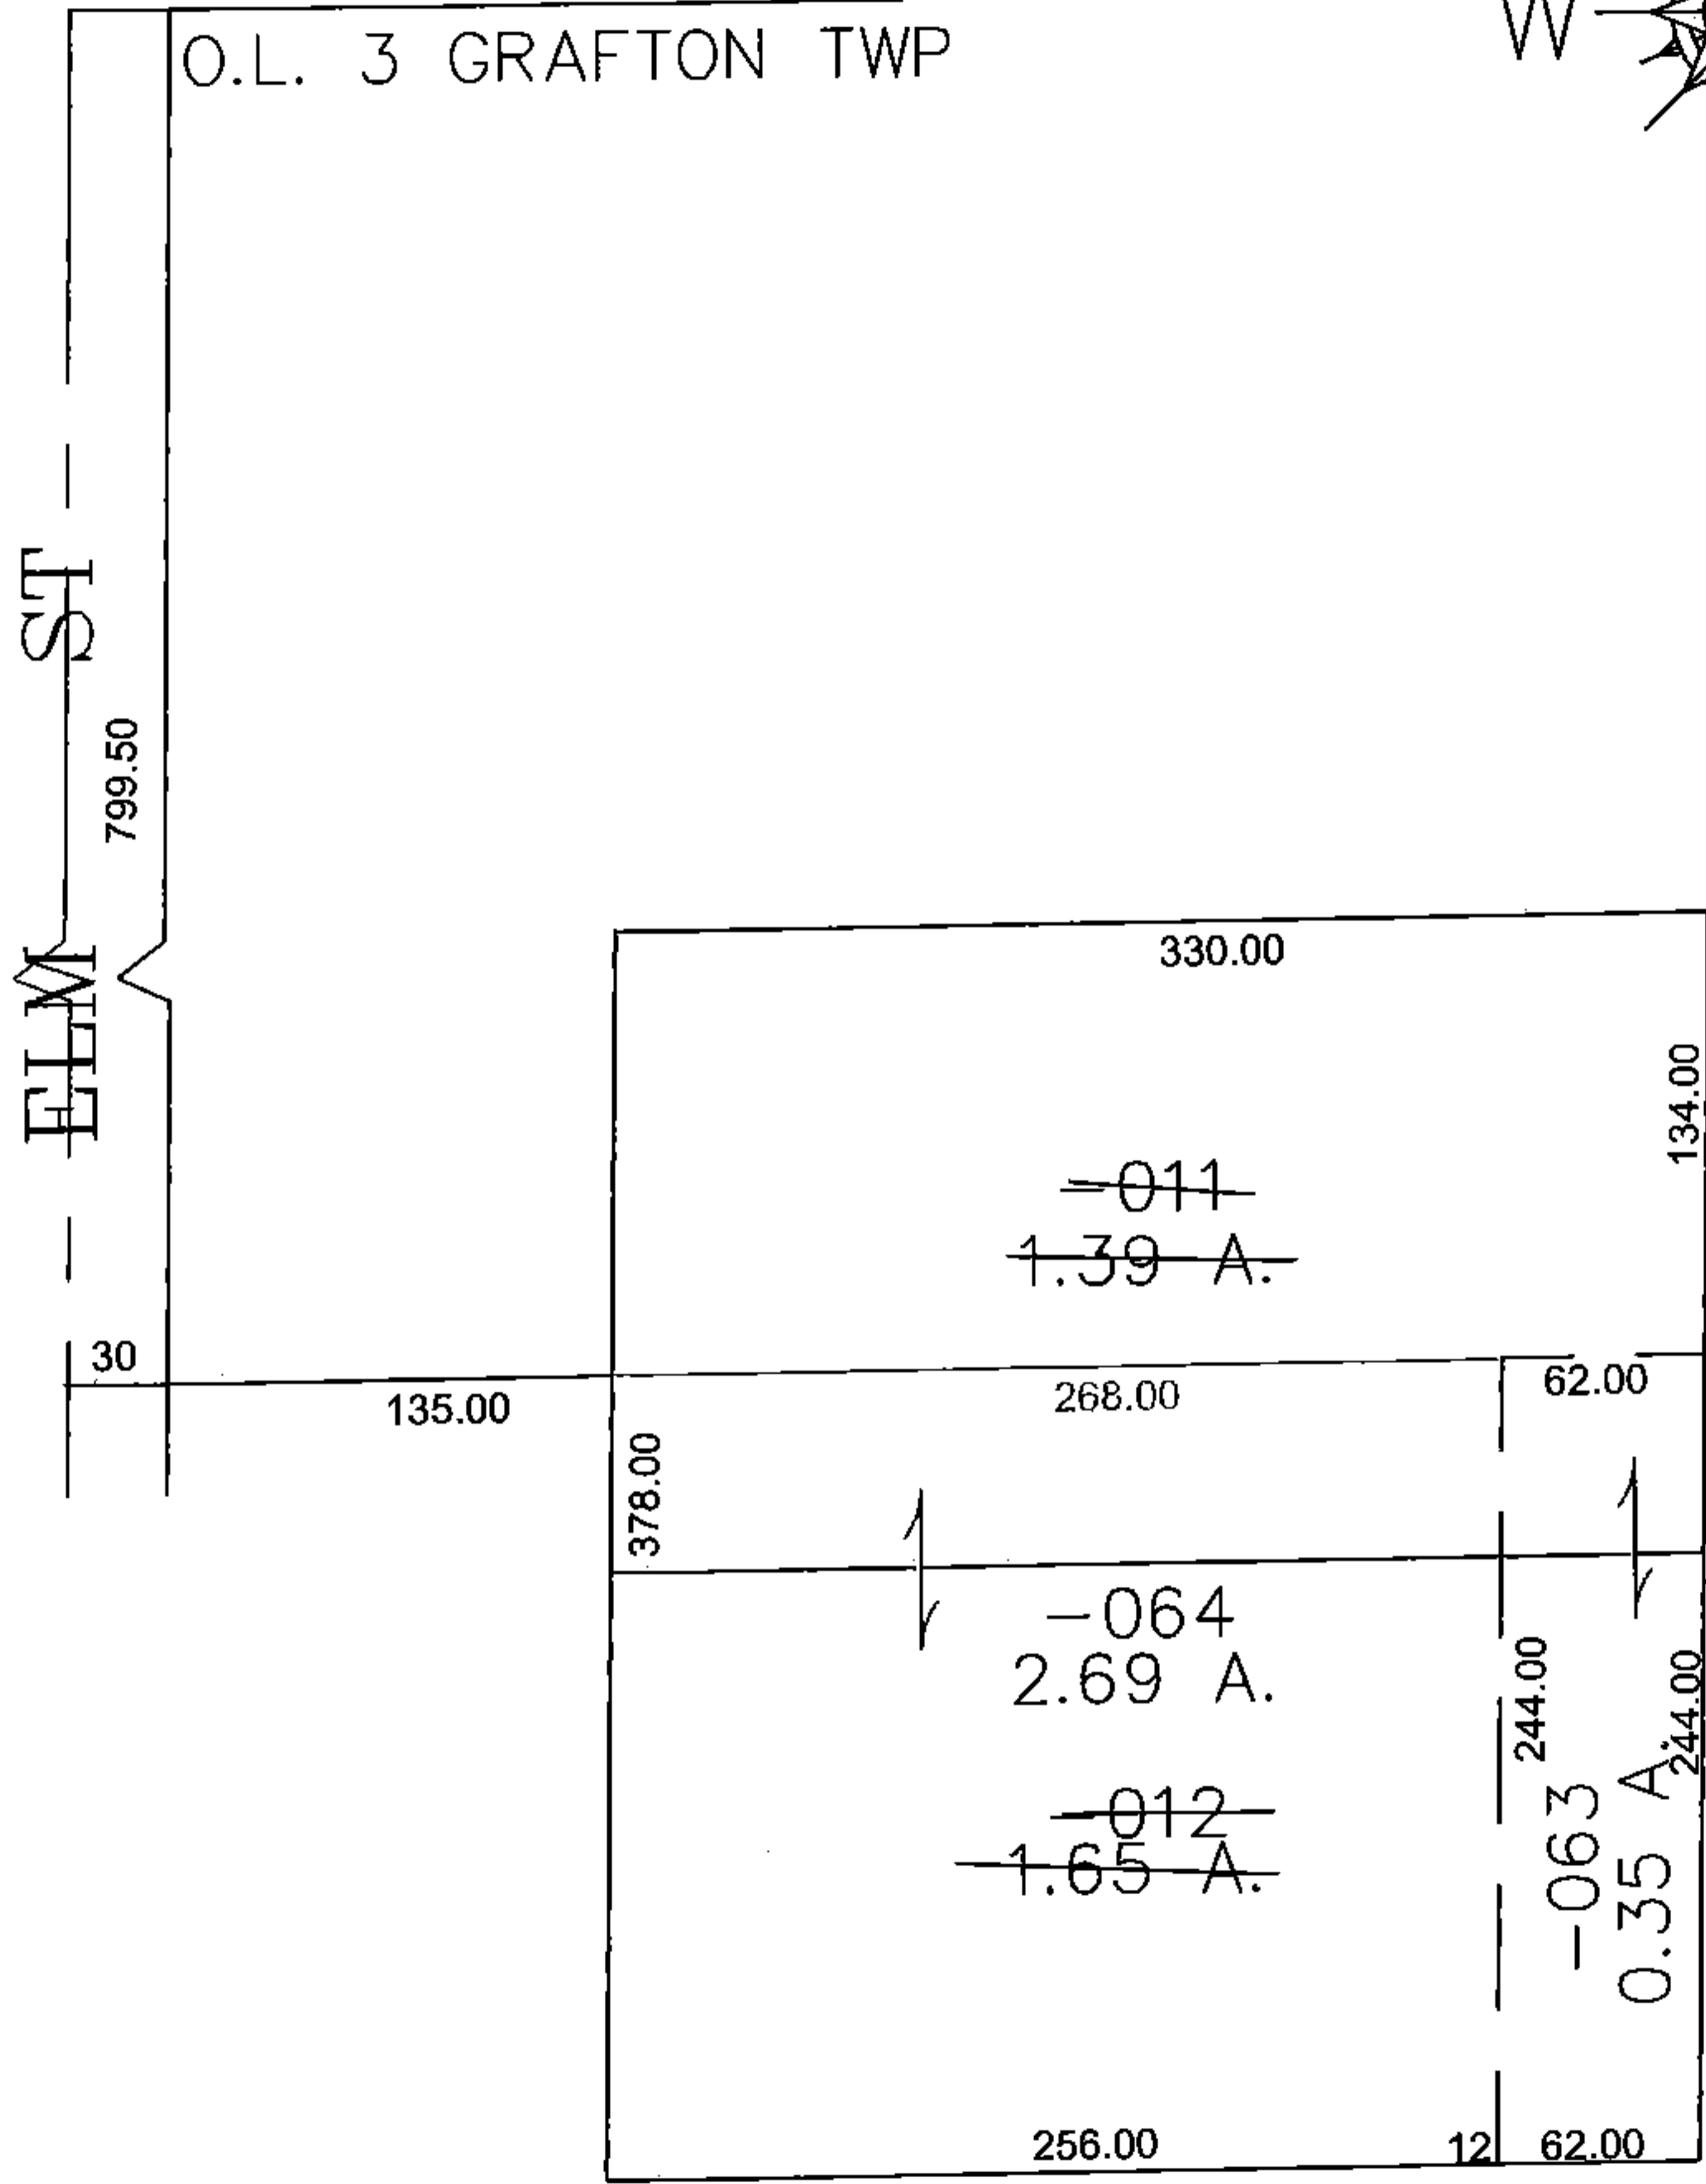

SPLITS/DEEDS PROCESSED

LORAIN COUNTY TAX MAP DEPARTMENT
226 MIDDLE AVE. ELYRIA, OHIO

SURVEYED BY: MATTHEW NEFF
 CLOSURE: 0.00 : 10.000
 MAP PAGE(S): 16-A
 APPROVED BY: JAH DATE: 1/6/2015
 SCALE: 1" = 100 PRIOR INSTRUMENT: DV 429/329