


PARENT PARCEL: 18-00-016-000-041



CHILD PARCEL: 18-00-016-000-069, -070

STARTING POINT: CENTERLINE OF HAWLEY RD & O.L. 16

14-03330

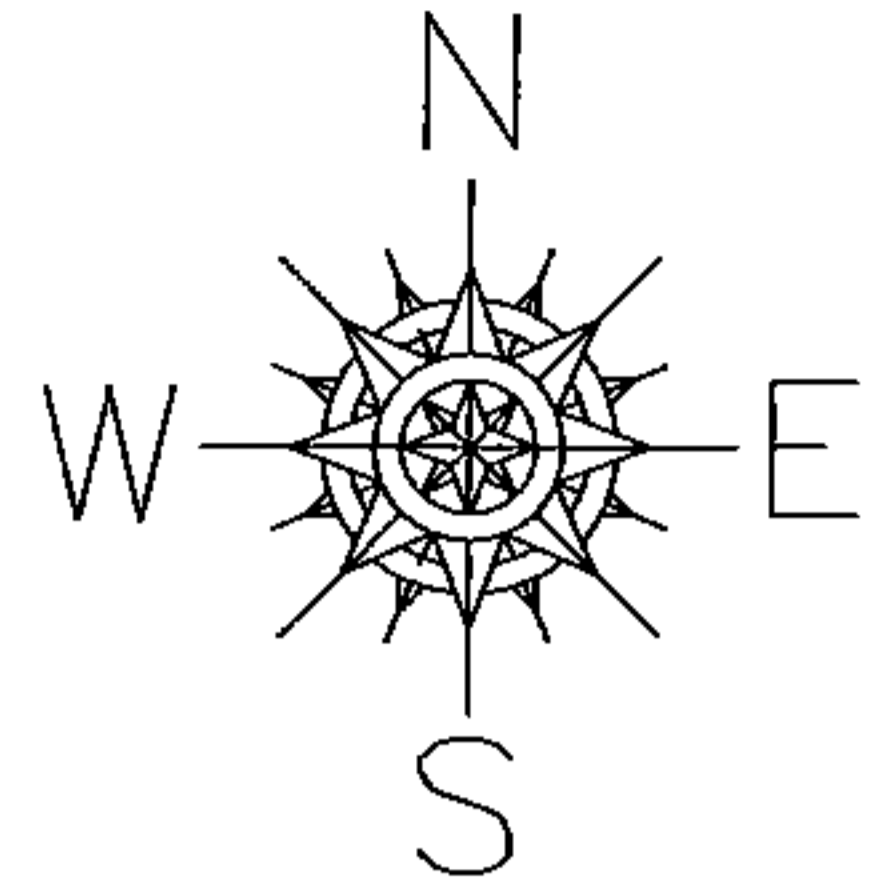

O.L. 17
O.L. 16

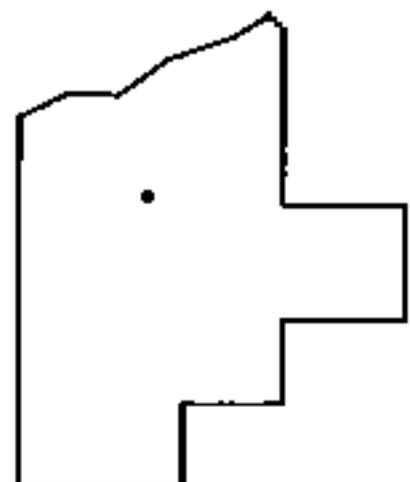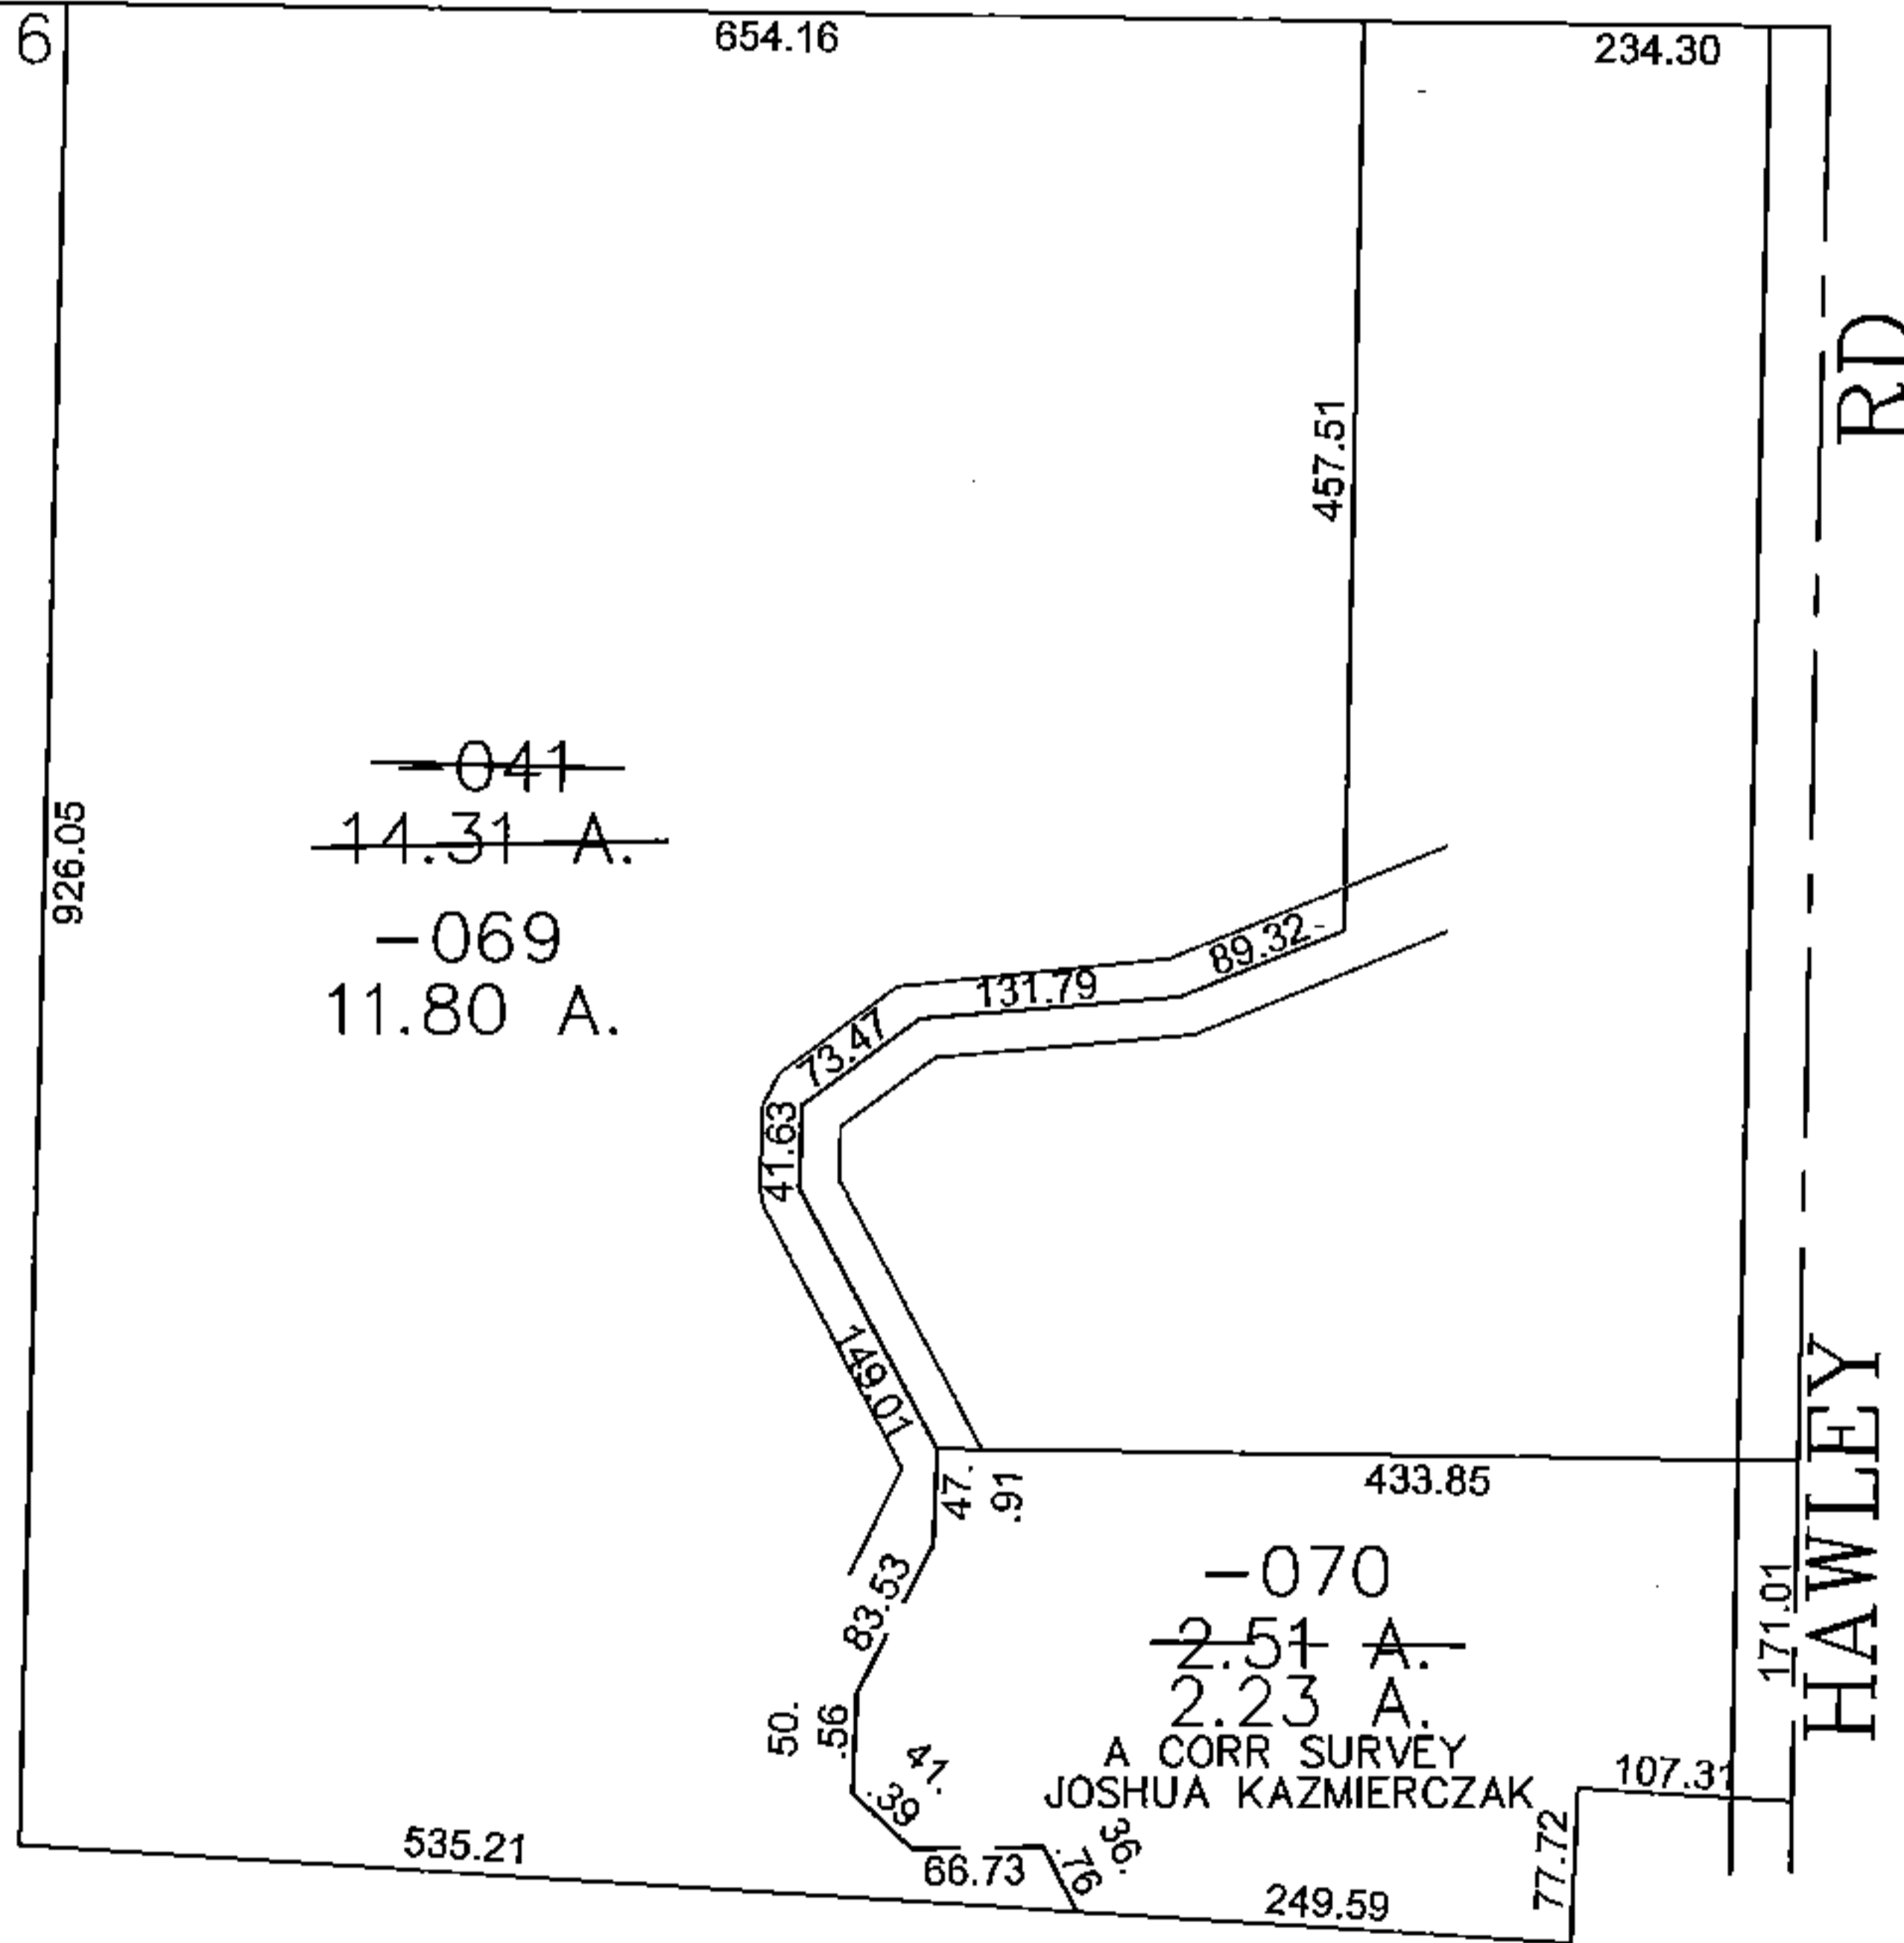

SPLITS/DEEDS PROCESSED
LORAIN COUNTY TAX MAP DEPARTMENT
226 MIDDLE AVE. ELYRIA, OHIO

SURVEYED BY: JOSHUA KAZMIERCZAK
CLOSURE: 0.00 : 10.000
MAP PAGE(S): 18-00-016-B
APPROVED BY: JAH DATE: 12/29/2014
SCALE: 1" = 200. PRIOR INSTRUMENT: DV 764/153