
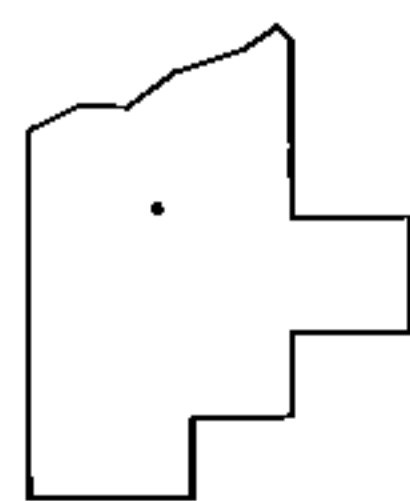
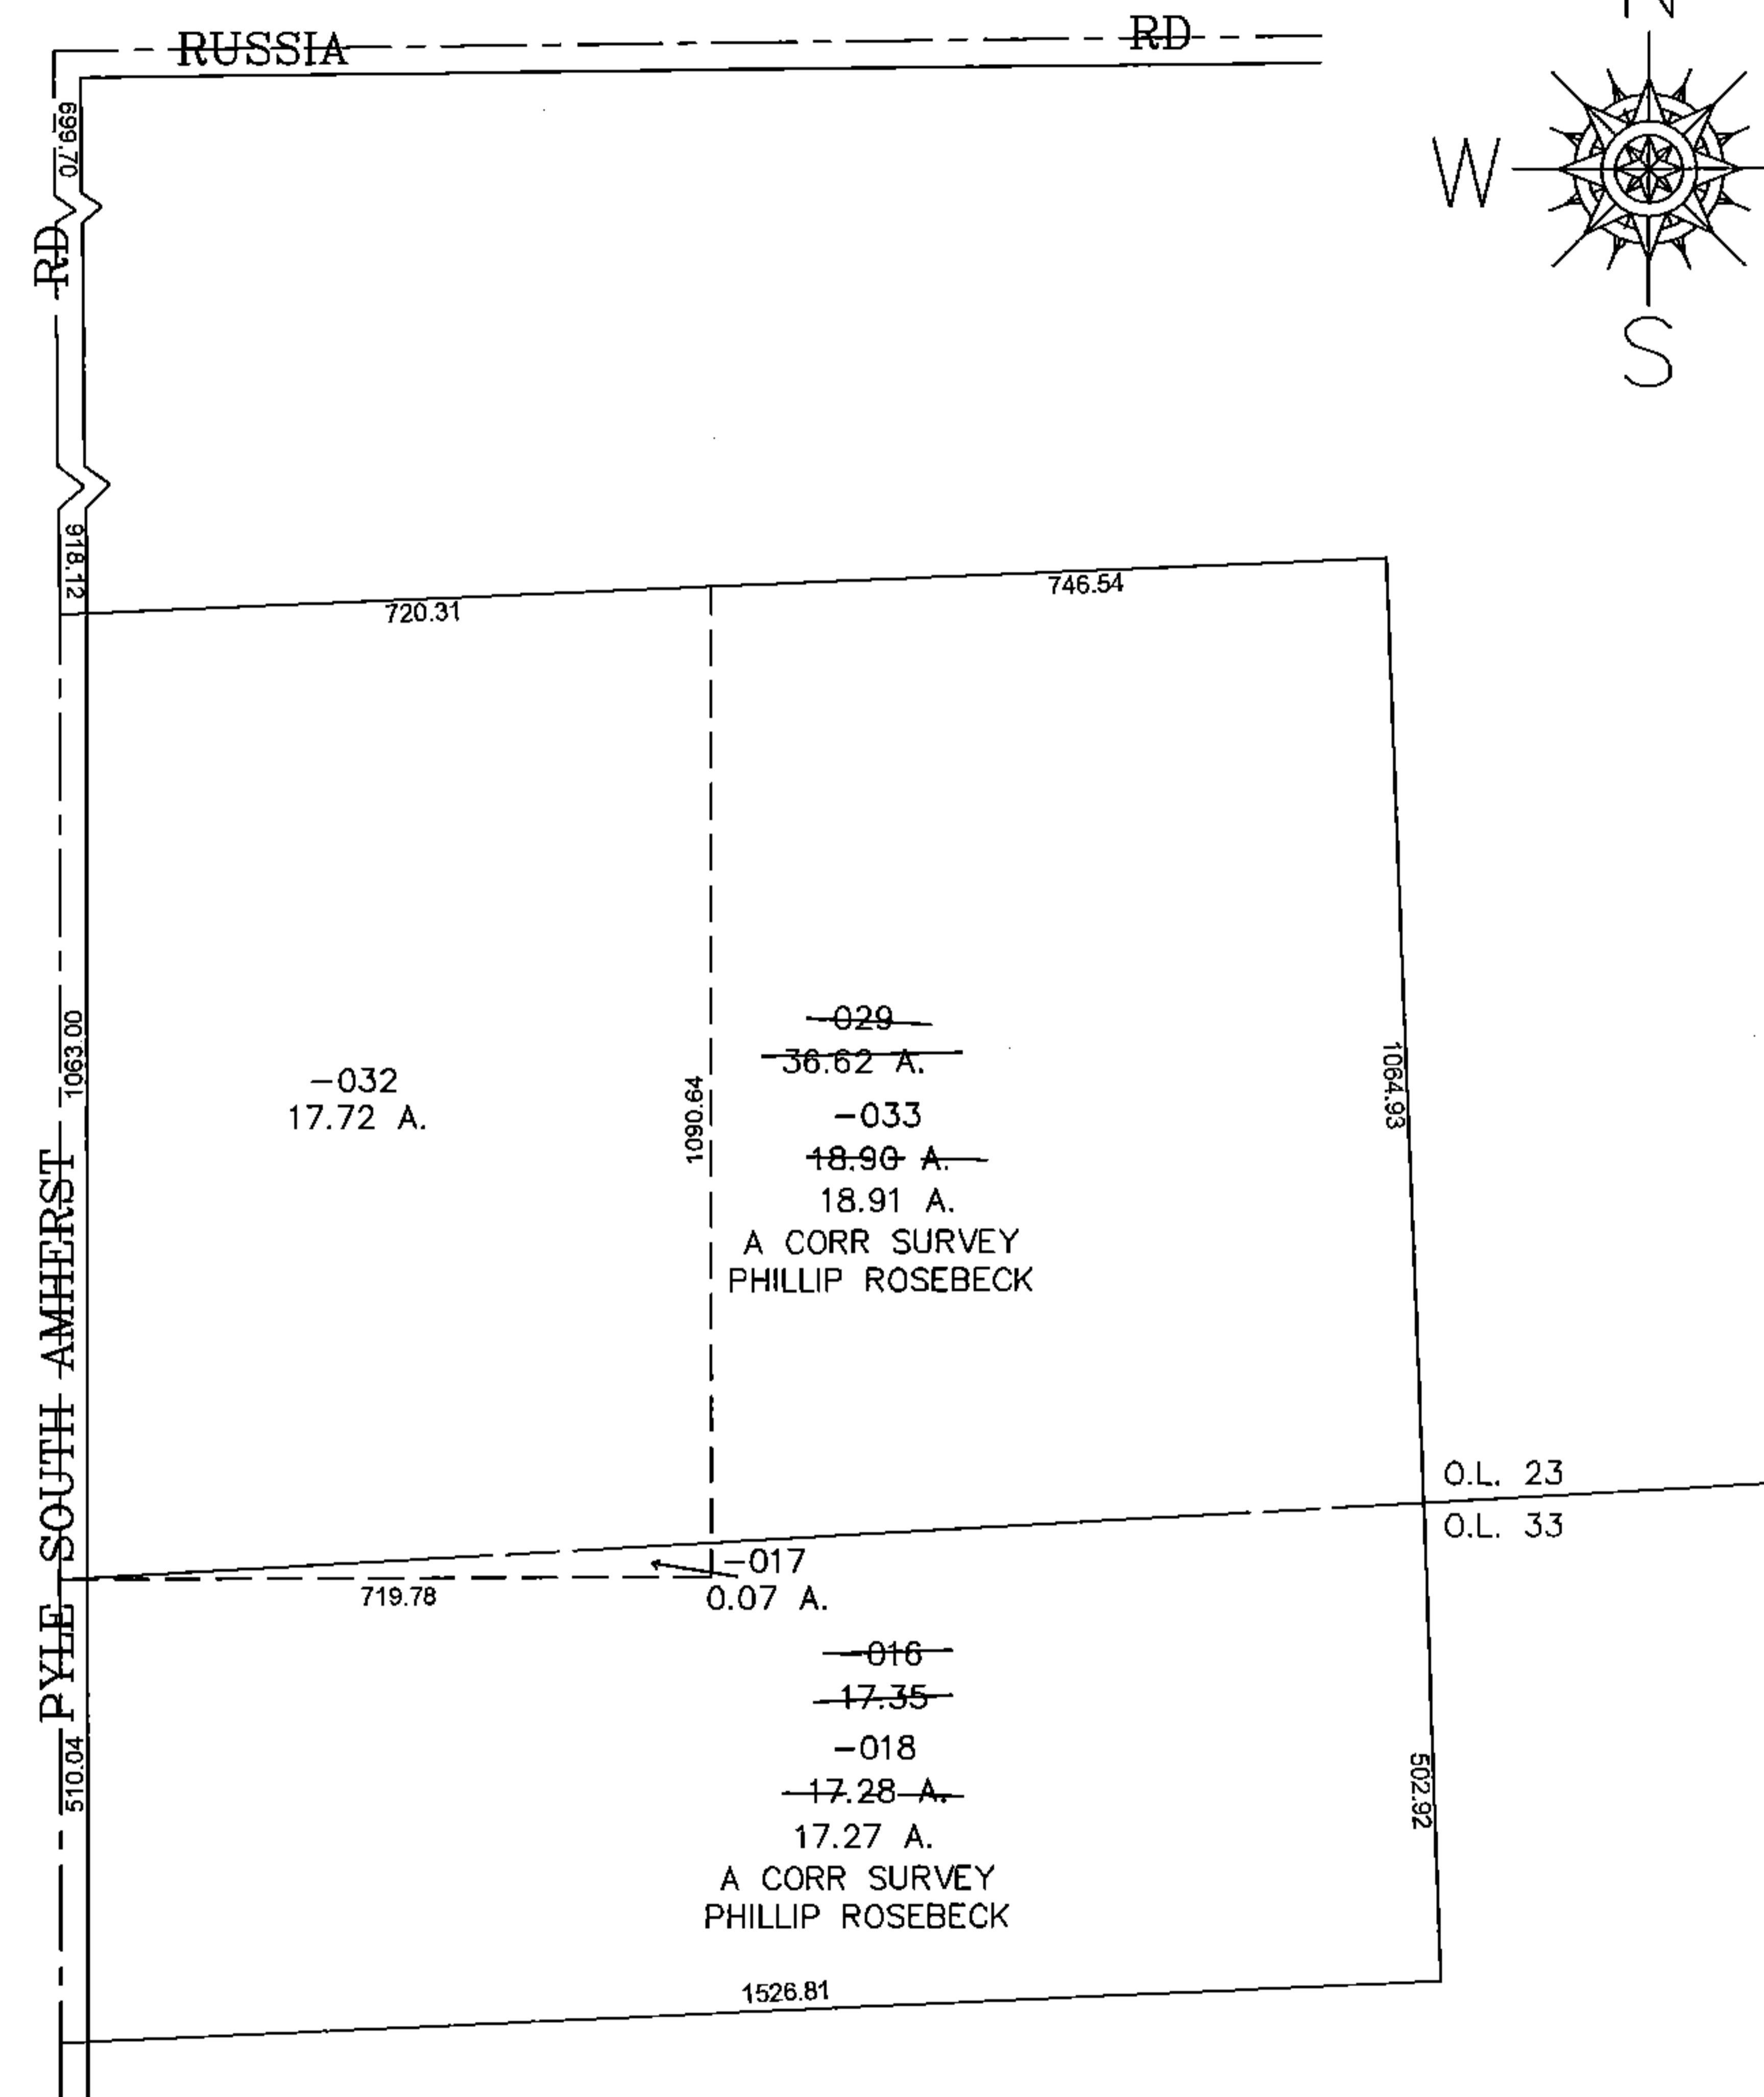


PARENT PARCEL: 09-00-023-102-029, 09-00-033-000-016
 CHILD PARCEL: 09-00-023-102-032, -033 09-00-033-000-017, -018
 STARTING POINT: CENTERLINE OF PYLE SOUTH AMHERST RD & RUSSIA RD

14-03331

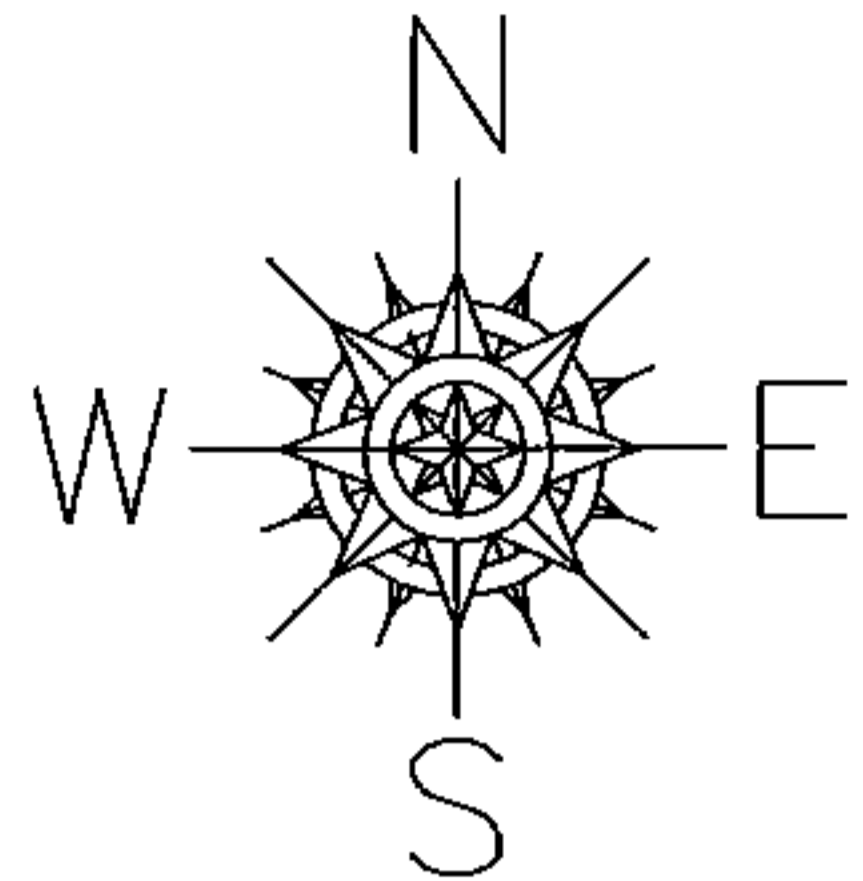

SPLITS/DEEDS PROCESSED
 LORAIN COUNTY TAX MAP DEPARTMENT
 226 MIDDLE AVE. ELYRIA, OHIO

SURVEYED BY: PHILLIP A ROSEBECK
 CLOSURE: 0.00 : 10,000
 MAP PAGE(S): 09-00-023-B
 APPROVED BY: JAH DATE: 12/29/2014
 SCALE: 1" = 300 PRIOR INSTRUMENT: 20010741978