
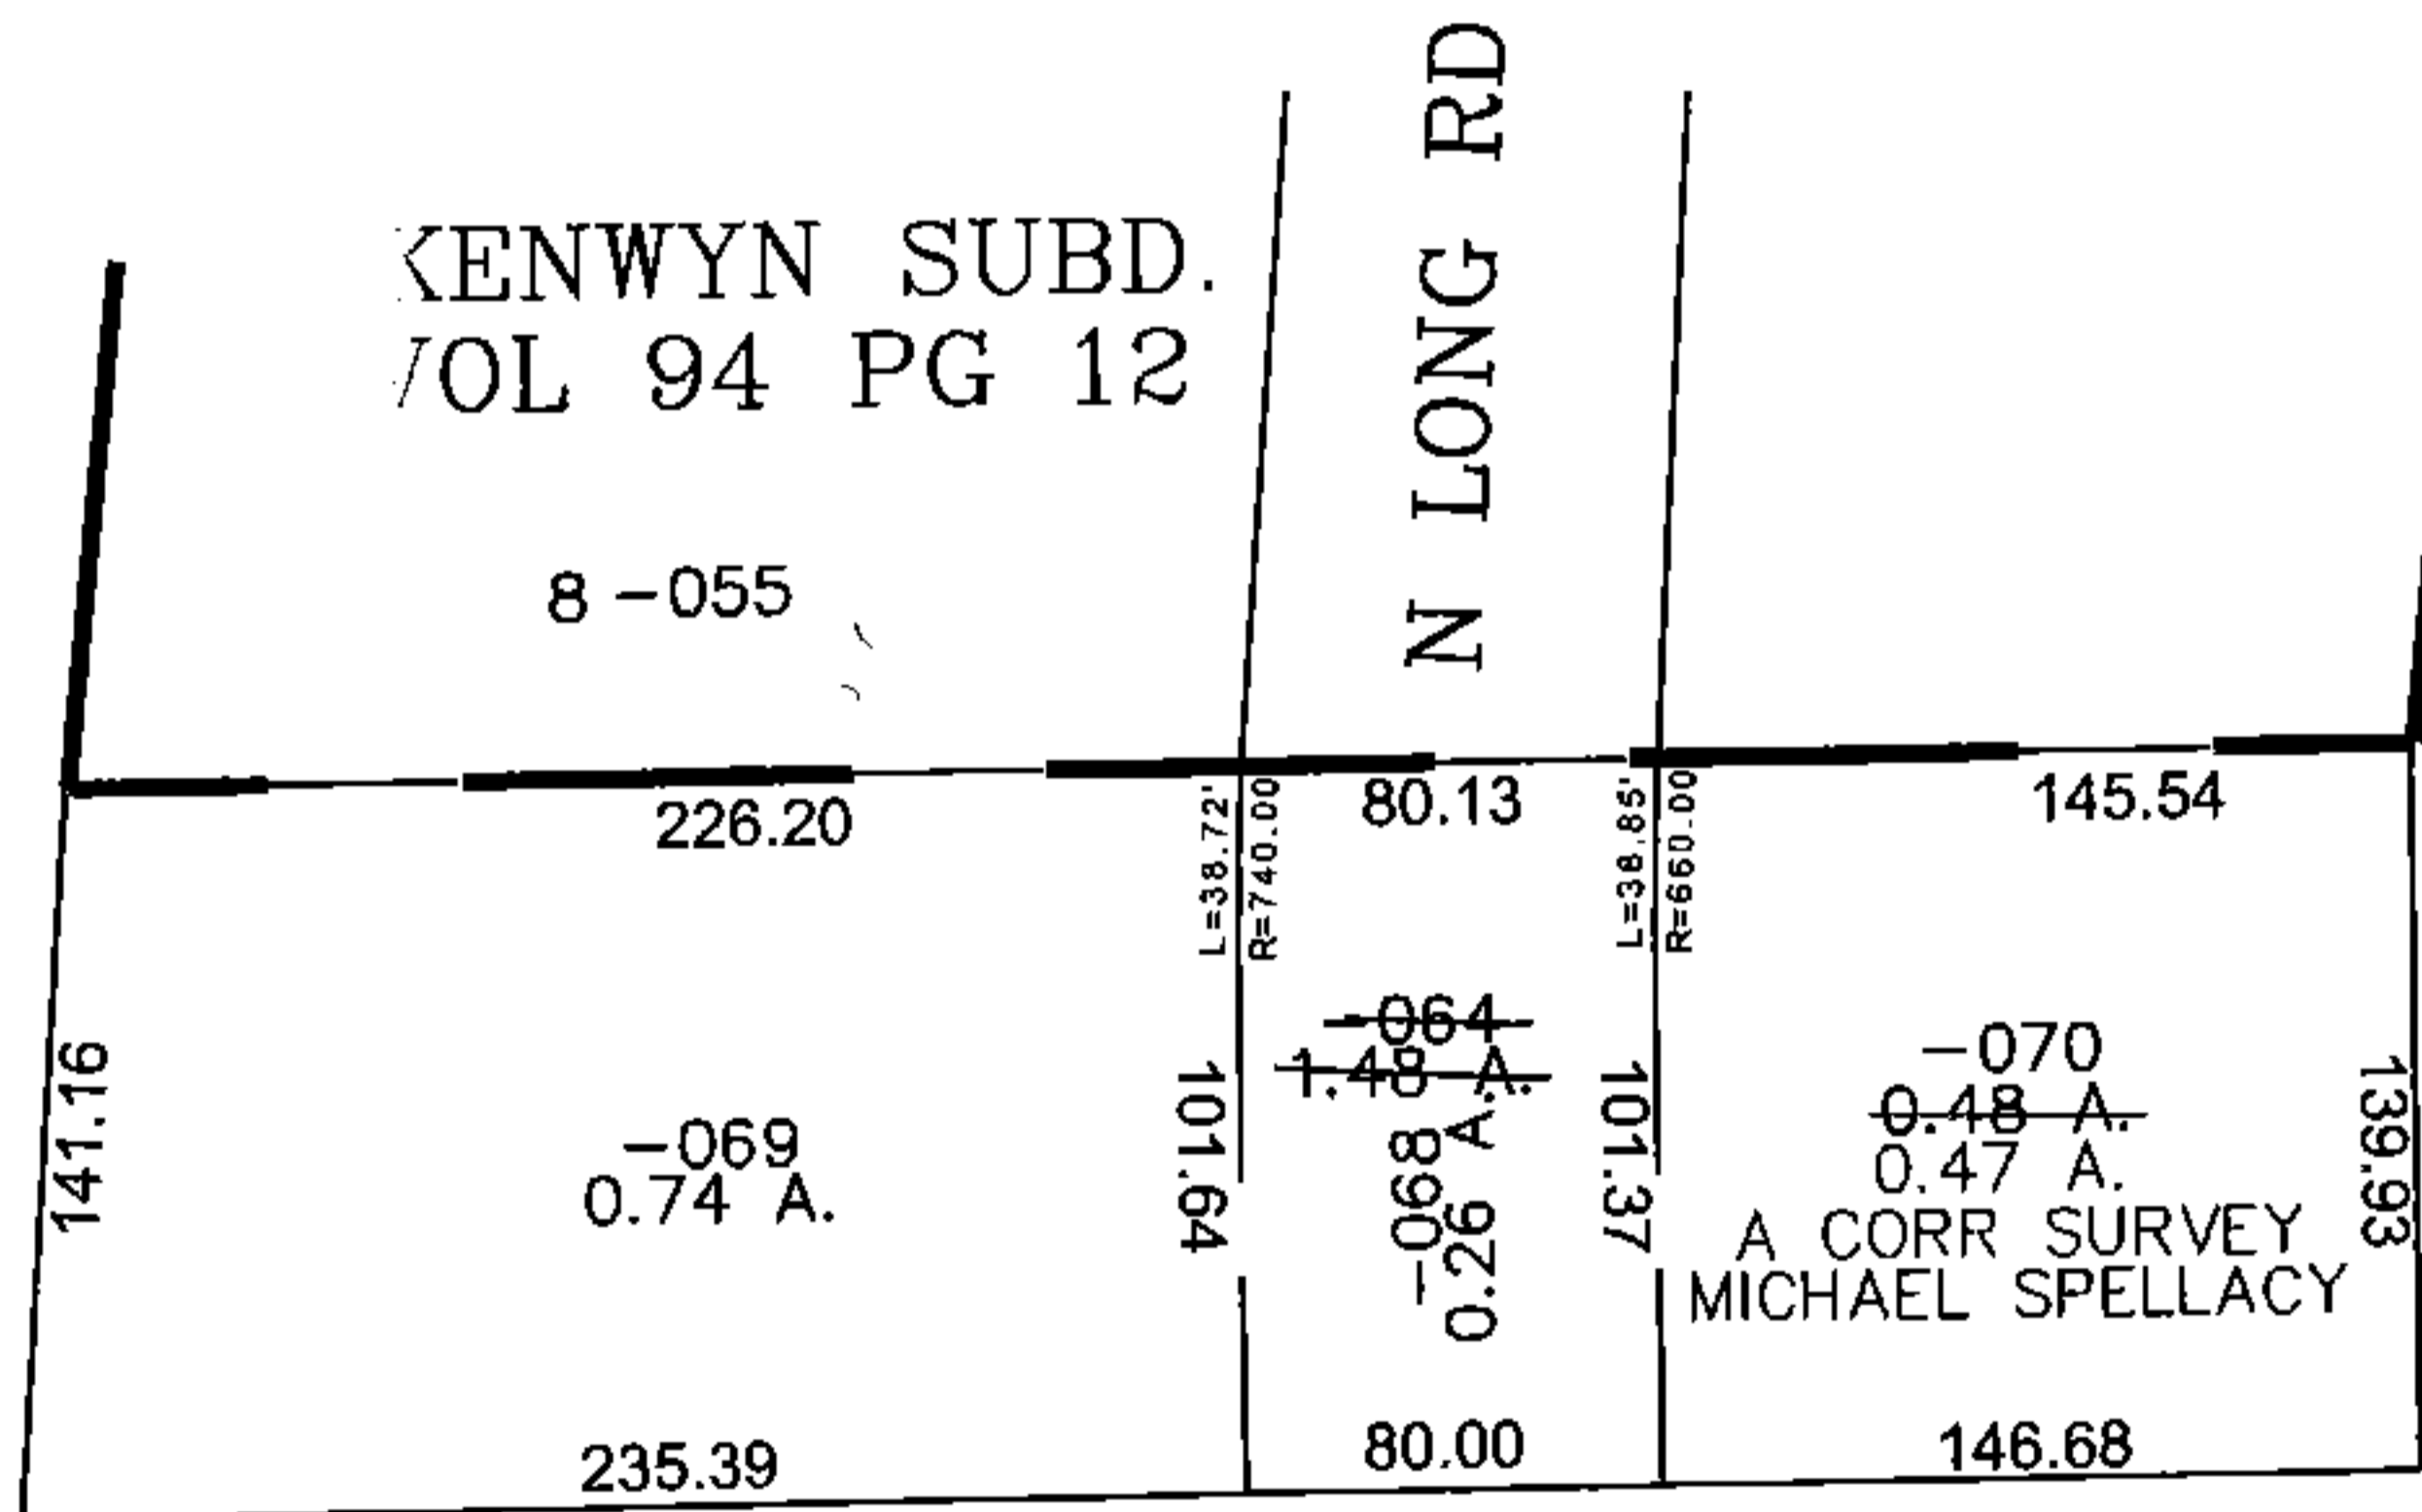


PARENT PARCEL: 04-00-003-103-064

CHILD PARCEL: 04-00-003-103-068, -069, -070

STARTING POINT: WEST RIGHT OF WAY LINE N LONG RD & SOUTHEASTERLY CORNER OF S/L 8

14-03332

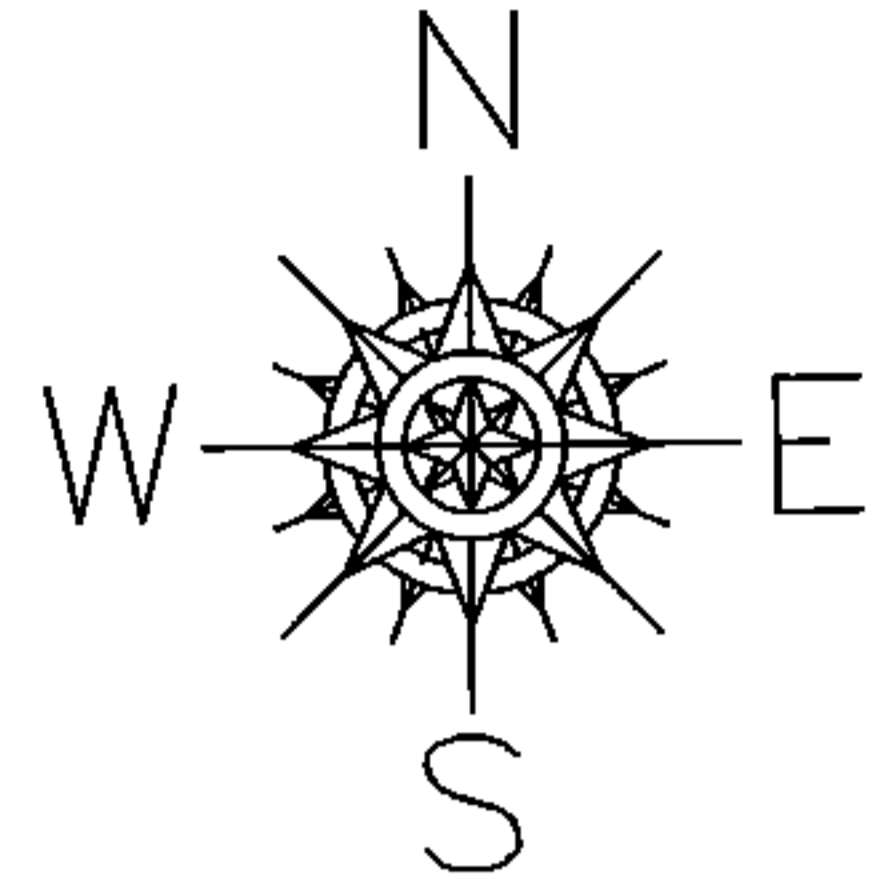

SPLITS/DEEDS PROCESSED

LORAIN COUNTY TAX MAP DEPARTMENT
226 MIDDLE AVE. ELYRIA, OHIO

SURVEYED BY: MICHAEL SPELLACCY

CLOSURE: 0.00 : 10.000

MAP PAGE(S): 04-00-003-H

APPROVED BY: JAH DATE: 12/30/2014

SCALE: 1" = 100 PRIOR INSTRUMENT: 20070197944