
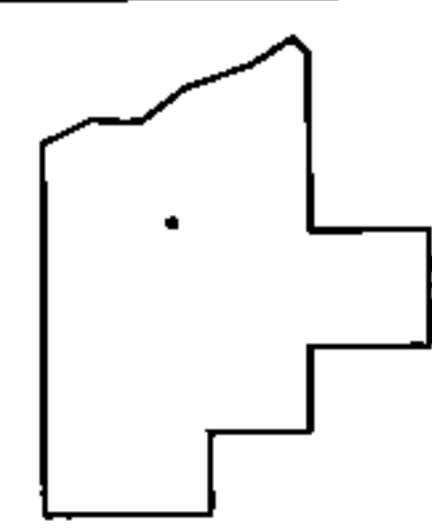
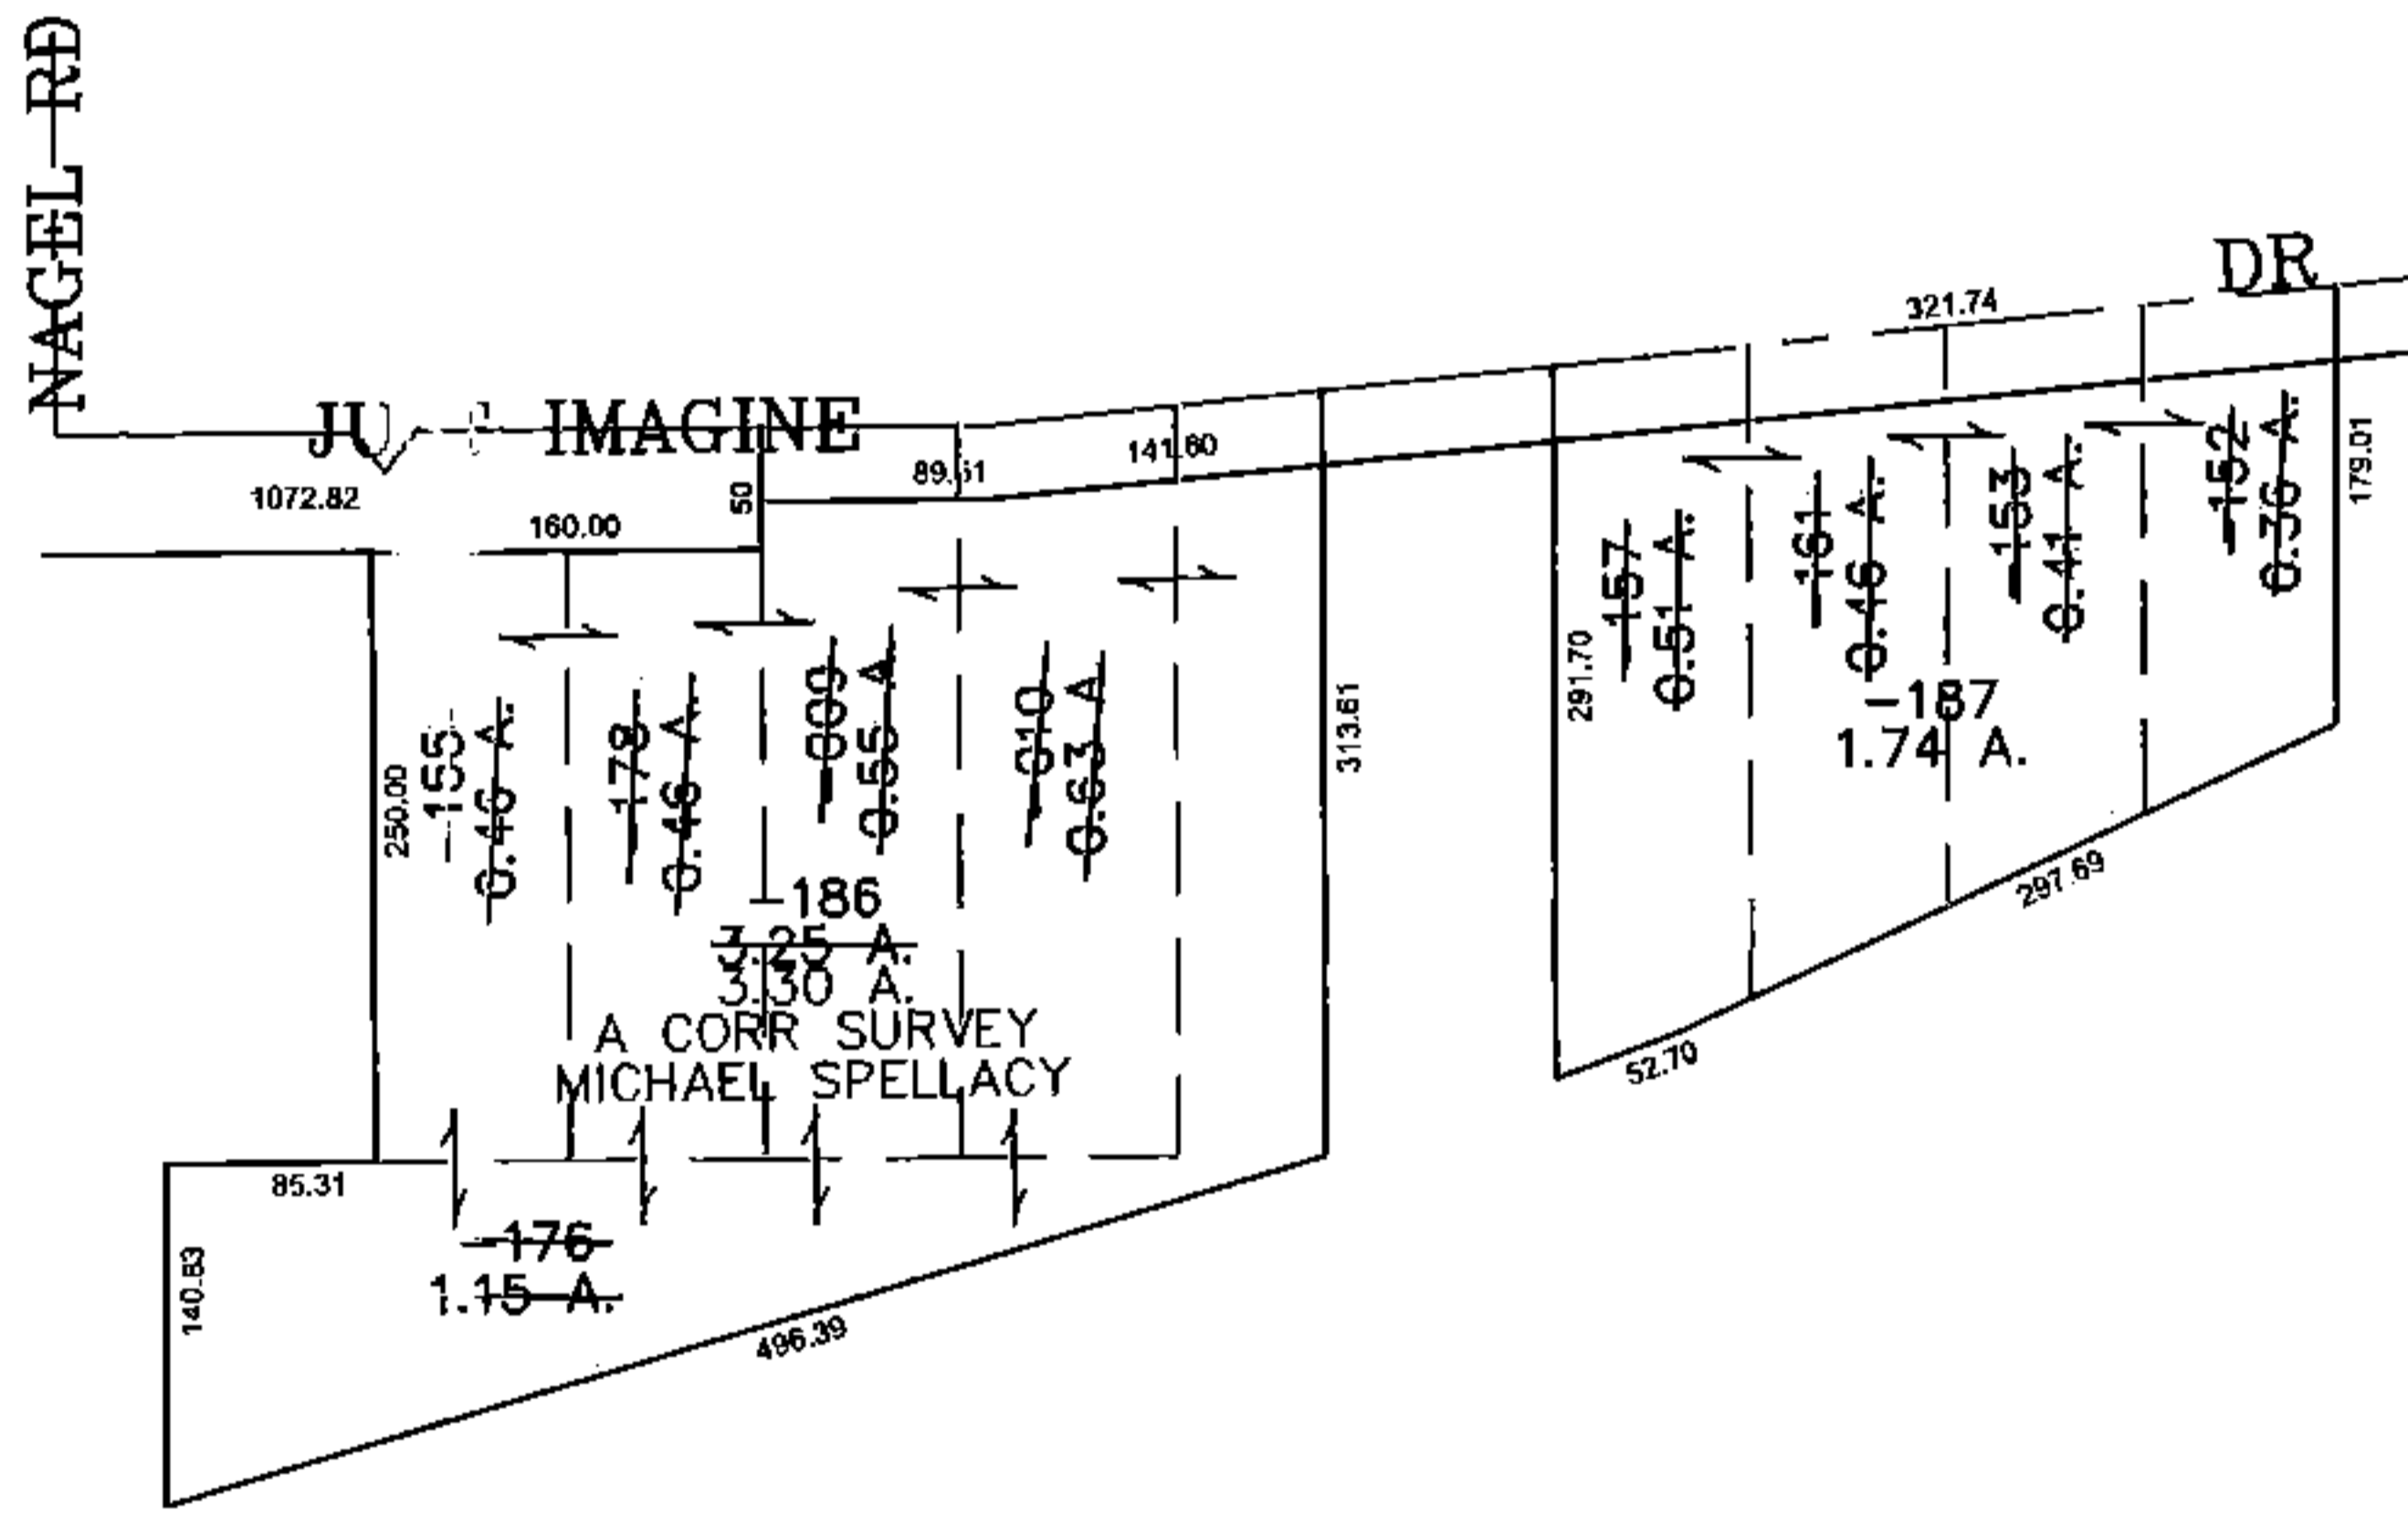


PARENT PARCEL: 04-00-028-102-009, -010, -178, -155, -176, -152, -153, -161, -157
 CHILD PARCEL: 04-00-028-102-186, -187
 STARTING POINT: CENTERLINE OF JUST IMAGINE DR & NAGEL RD

15-03337

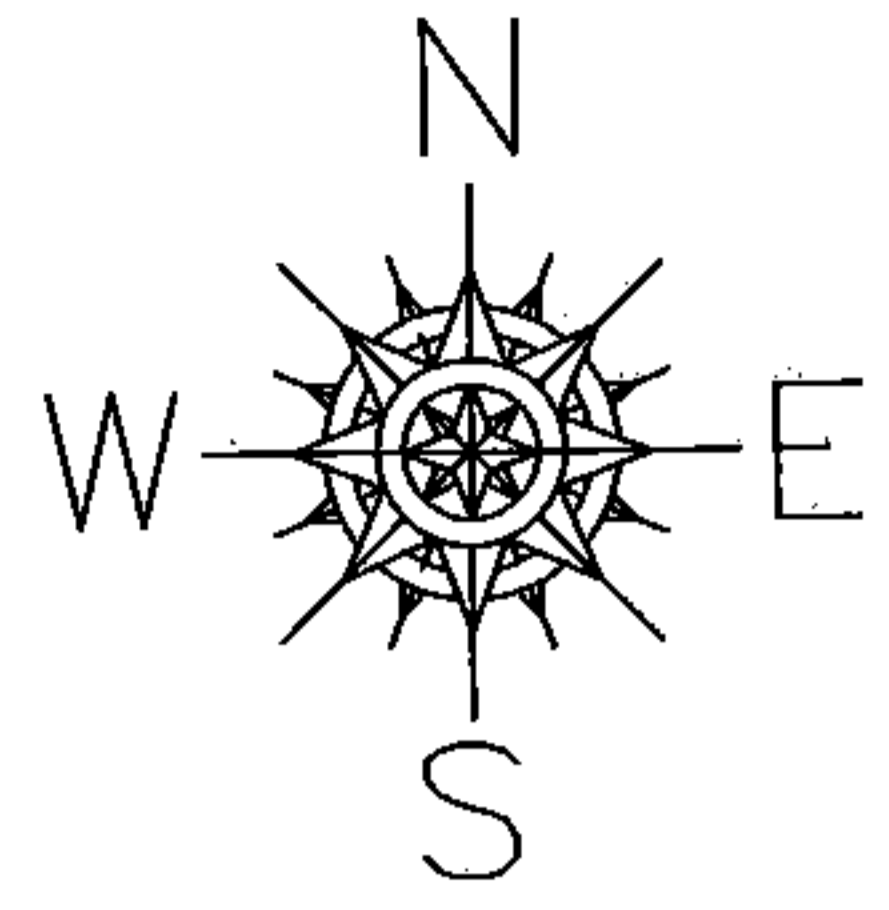

SPLITS/DEEDS PROCESSED
 LORAIN COUNTY TAX MAP DEPARTMENT
 226 MIDDLE AVE. ELYRIA, OHIO

SURVEYED BY: MICHAEL SPELLACY
 CLOSURE: 0.00 : 10.000
 MAP PAGE(S): 04-00-028-A
 APPROVED BY: JAH DATE: 1/15/2015
 SCALE: 1" = 200 PRIOR INSTRUMENT: 20130448455