


PARENT PARCEL: 12-00-046-000-005

CHILD PARCEL: 12-00-046-000-029, -030

STARTING POINT: CENTERLINE OF ELYRIA-TWINSBURG RD & COLUMBIA-WEST RIVER RD.

15-03338


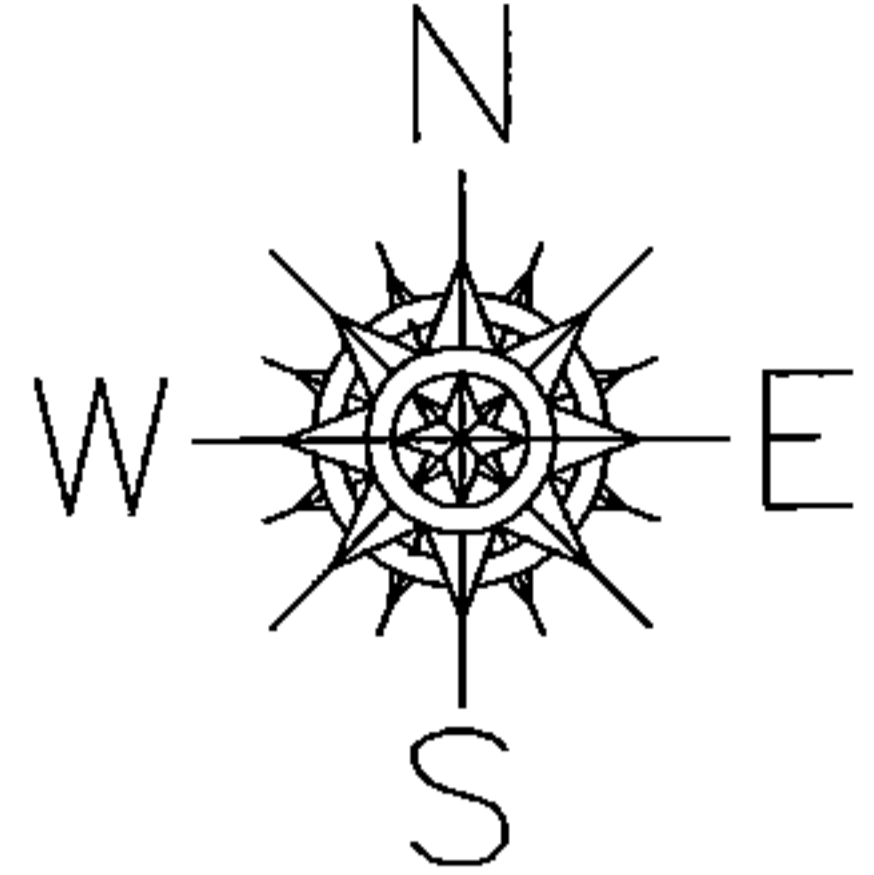


COLUMBIA-
WEST RIVER RD

29.70 233.50

O.L. 55
O.L. 46

E L Y R I A - T W I N S B U R G R D 639.04 66.75 185.00

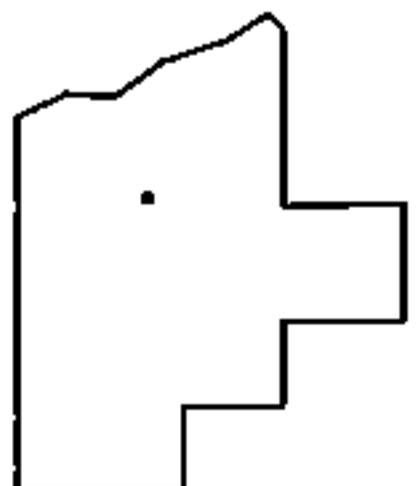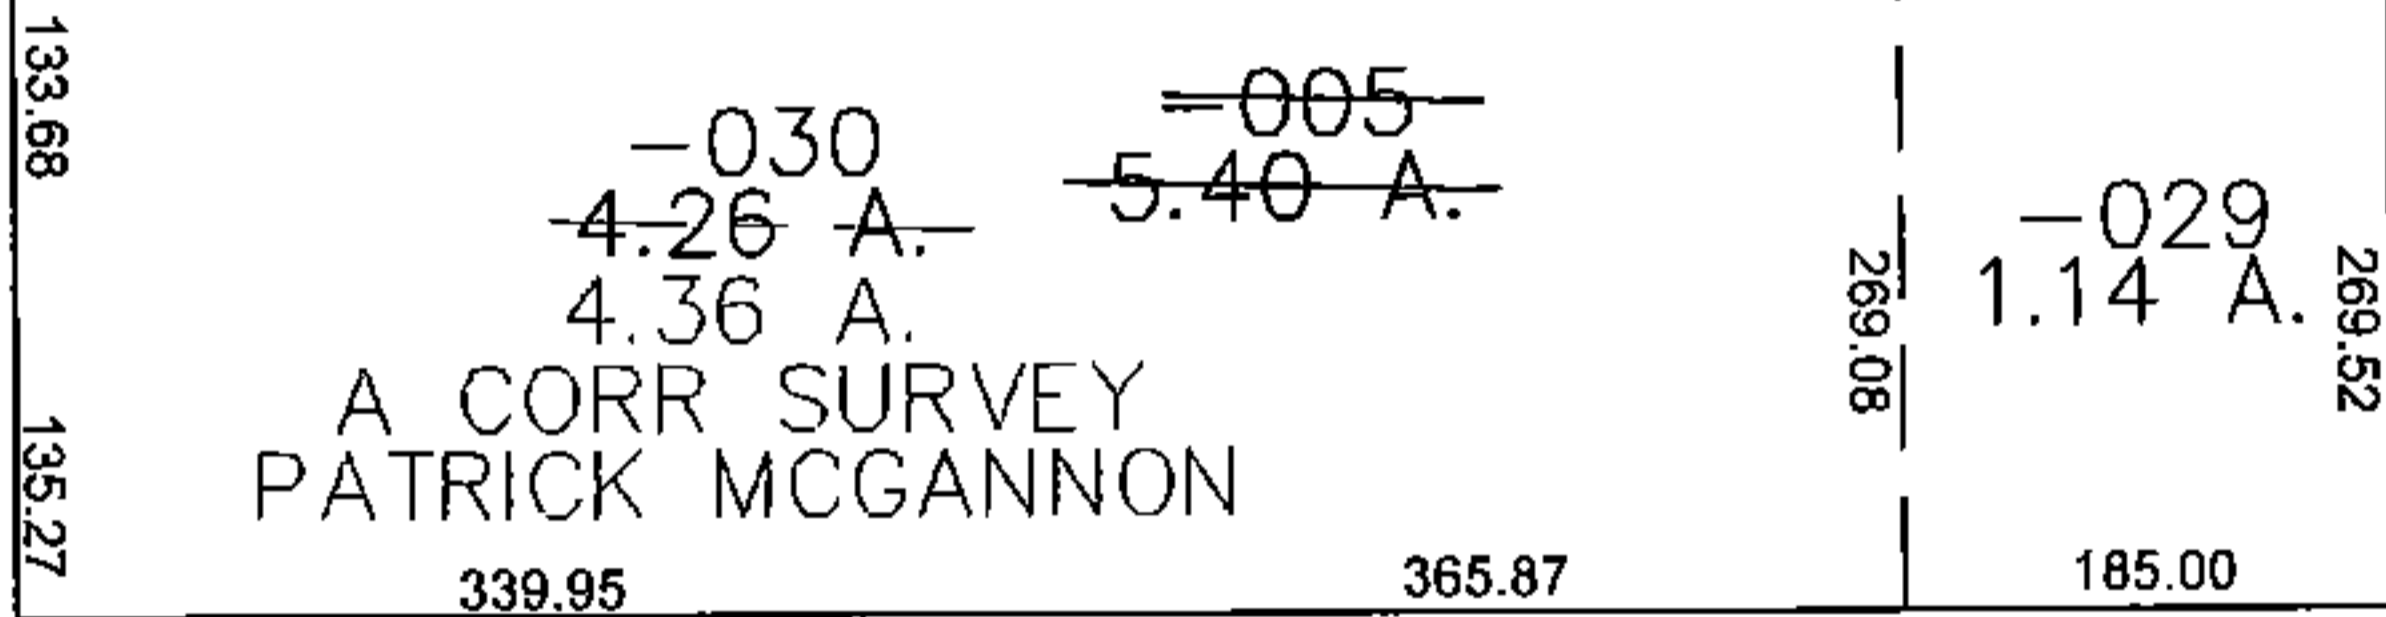

SPLITS/DEEDS PROCESSED
LORAIN COUNTY TAX MAP DEPARTMENT
226 MIDDLE AVE. ELYRIA, OHIO

SURVEYED BY: PATRICK MCGANNON
CLOSURE: 0.00 : 10.000
MAP PAGE(S): 12-00-046-A
APPROVED BY: JAH DATE: 1/20/2015
SCALE: 1" = 200 PRIOR INSTRUMENT: DV 766/100