
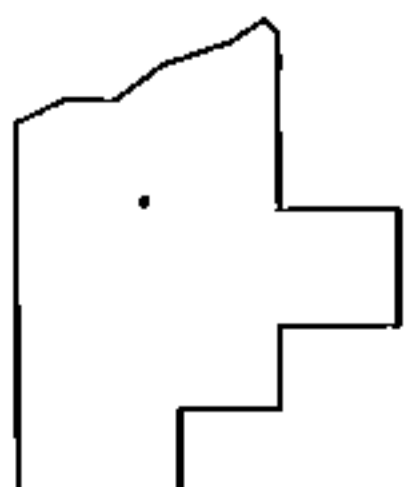
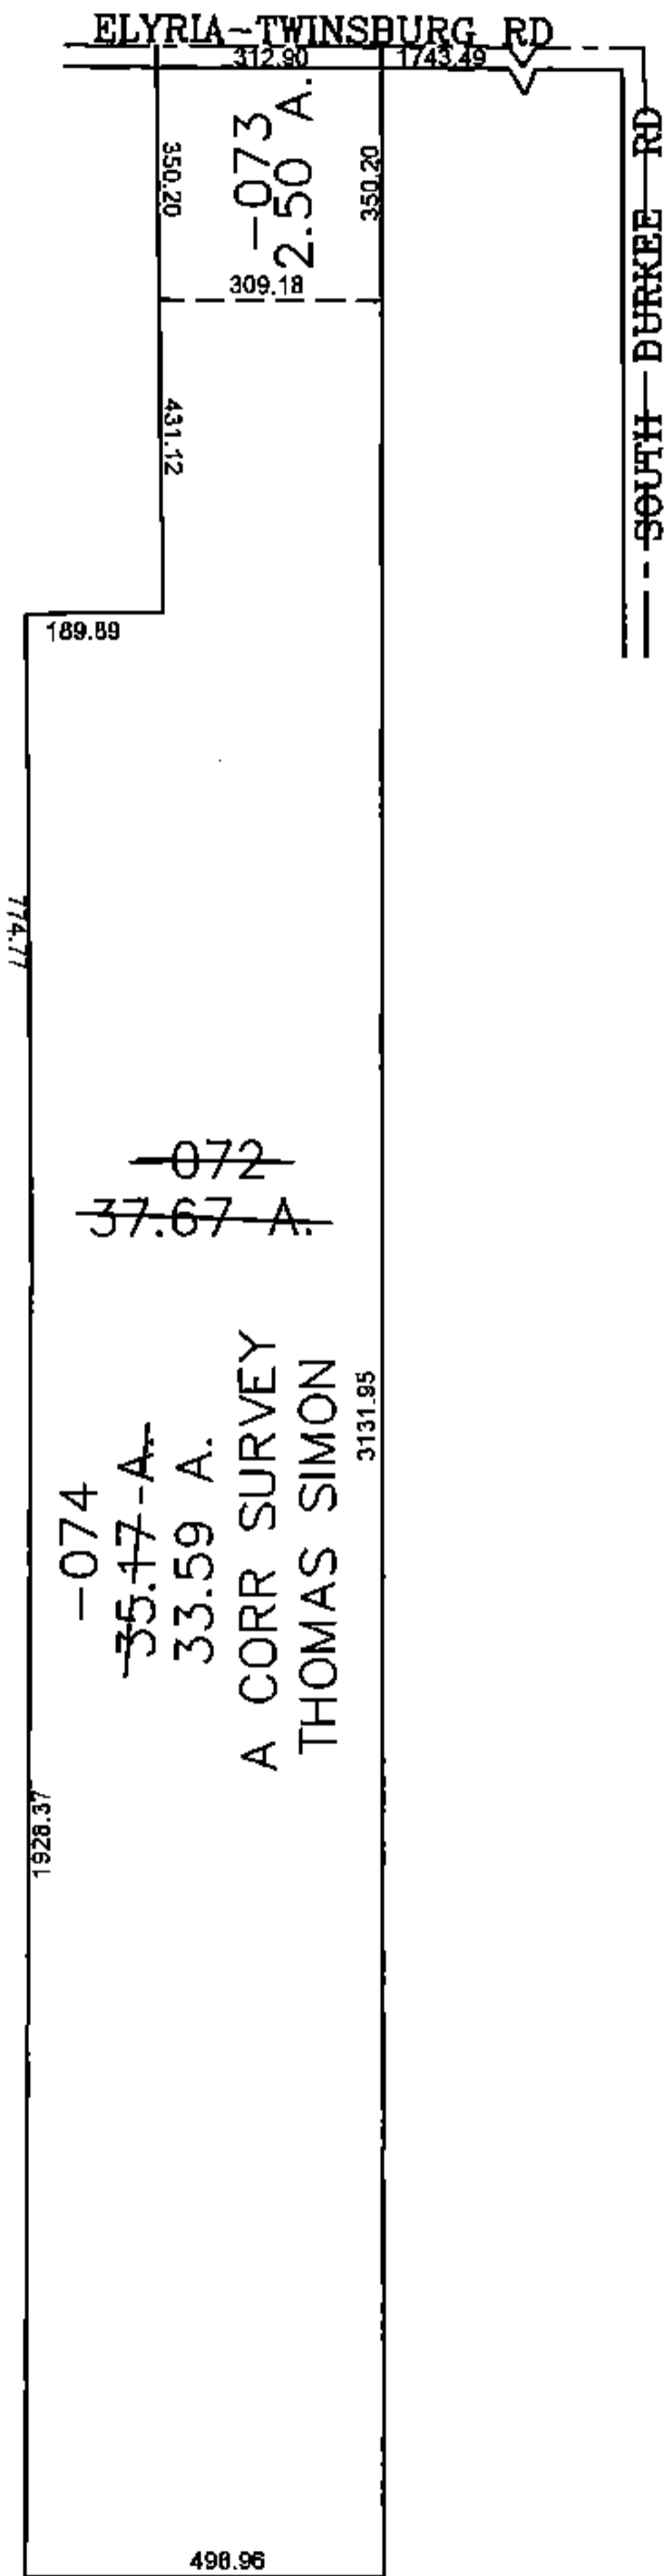


PARENT PARCEL: 11-00-085-000-072

CHILD PARCEL: 11-00-085-000-073, -074

STARTING POINT: CENTERLINE OF ELYRIA-TWINSBURG RD & SOUTH DURKEE RD

15-03339

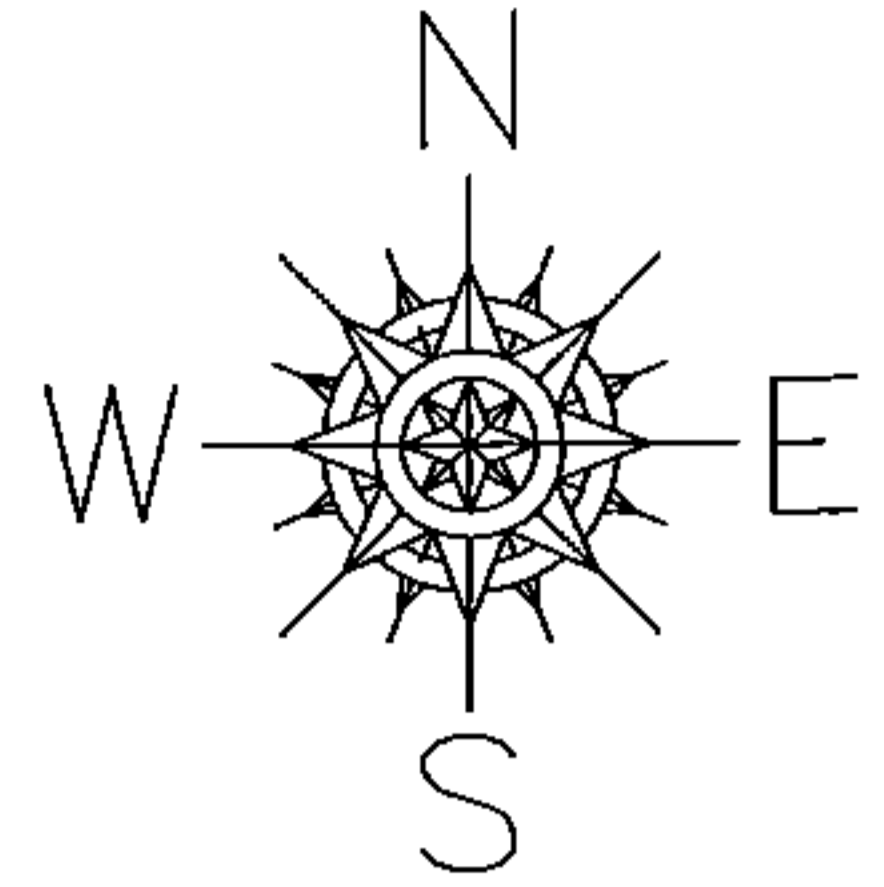

SPLITS/DEEDS PROCESSED

LORAIN COUNTY TAX MAP DEPARTMENT
226 MIDDLE AVE. ELYRIA, OHIO

SURVEYED BY: THOMAS SIMON

CLOSURE: 0.00 : 10.000

MAP PAGE(S): 11-00-085

APPROVED BY: JAH DATE: 1/23/2015

SCALE: 1"= 500 PRIOR INST.: 20020811297