
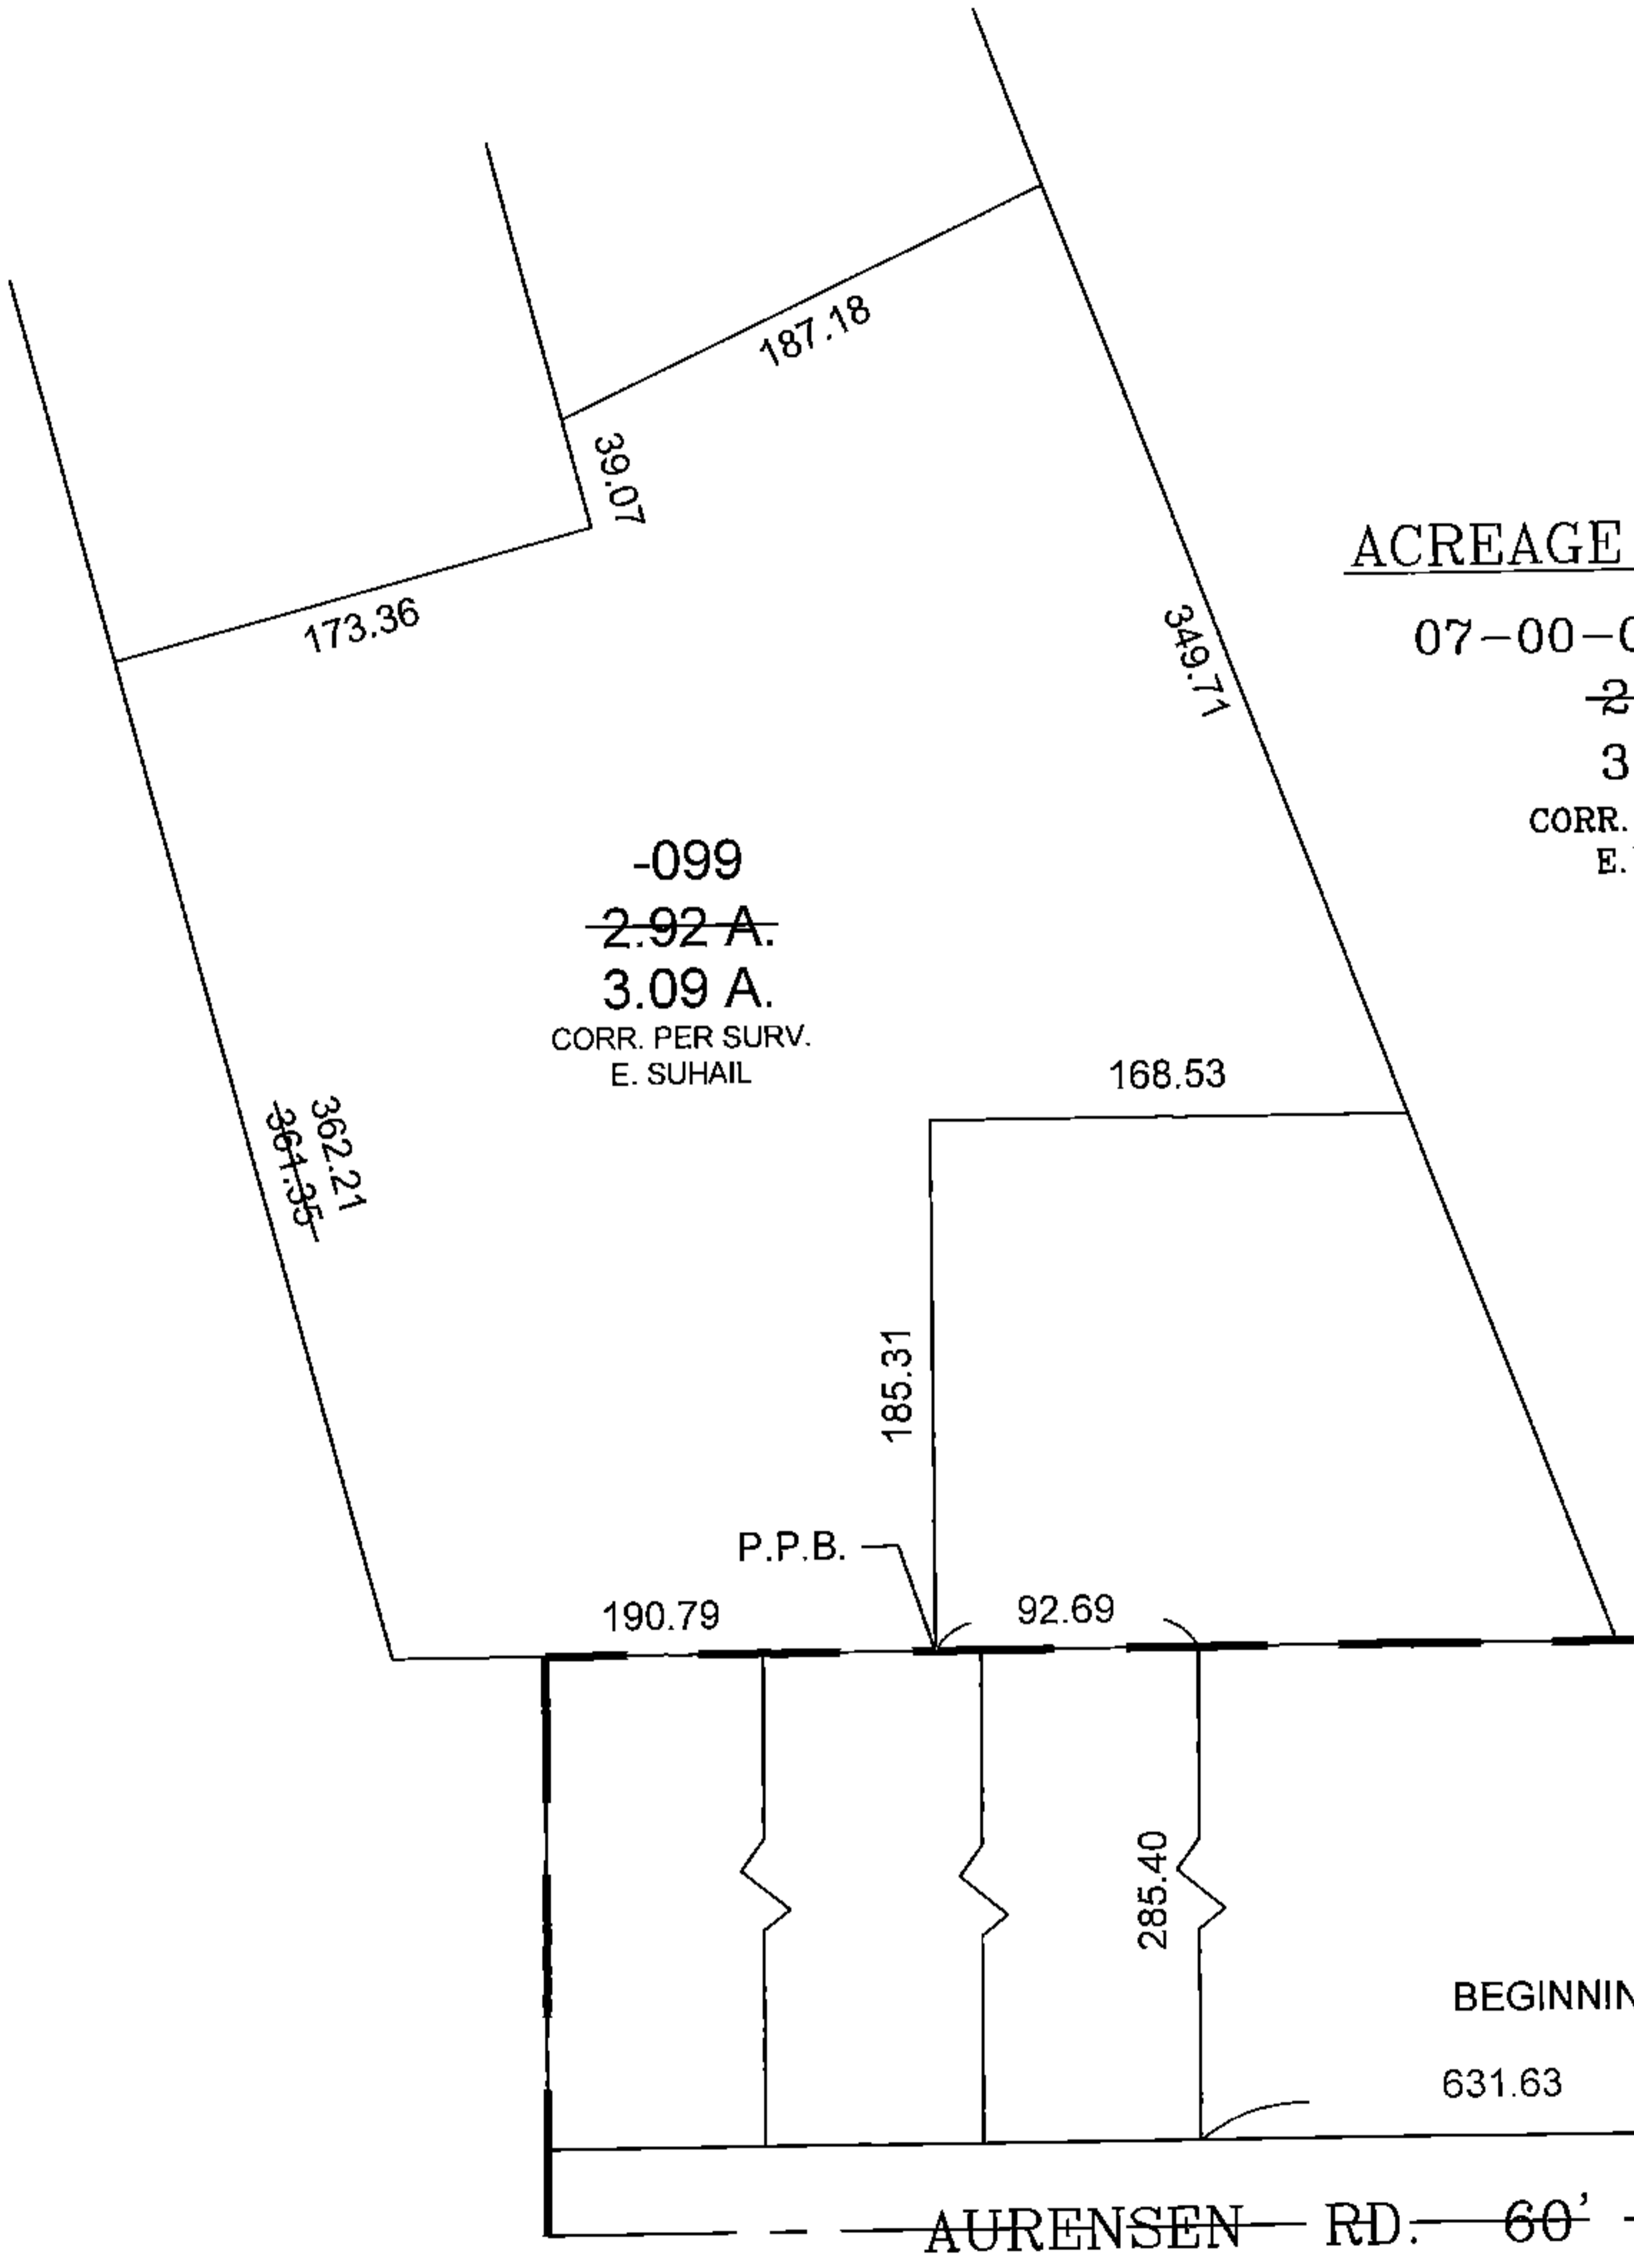


PARENT PARCEL: 07-00-028-103-099
 CHILD PARCEL: XX-XX-XXX-XXX-XXX
 STARTING POINT: NORTH R.O.W. OF AUTENSEN RD. & WEST R.O.W. OF NOLL DR.


15-03342-D

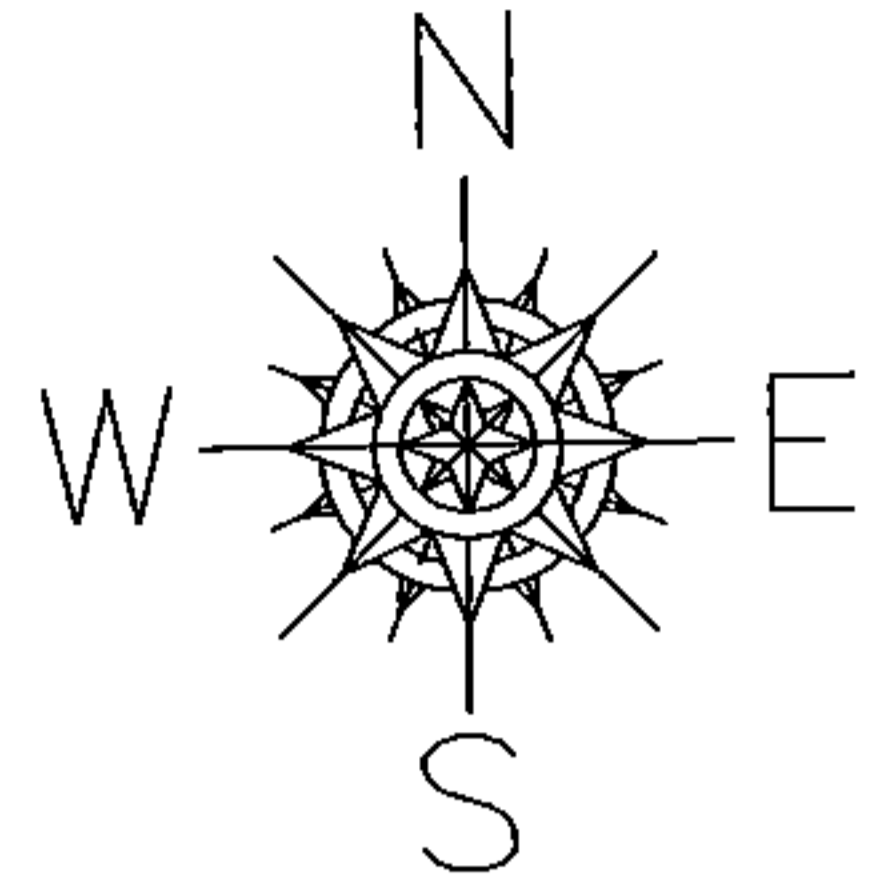

ACREAGE CORRECTION

07-00-028-103-099
~~2.92 A.~~
 3.09 A.
 CORR. PER SURV.
 E. SUHAIL

-099
~~2.92 A.~~
 3.09 A.
 CORR. PER SURV.
 E. SUHAIL

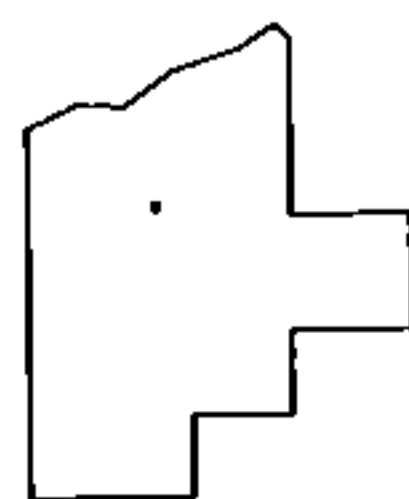

SPLITS/DEEDS PROCESSED

LORAIN COUNTY TAX MAP DEPARTMENT
 226 MIDDLE AVE. ELYRIA, OHIO

SURVEYED BY: EHTESHAM M. SUHAIL
 CLOSURE: 0.01 : 10,000
 MAP PAGE(S): 07-00-028
 APPROVED BY: TJS DATE: 12/22/15
 SCALE: 1"= 100 PRIOR INST.: 20110366228