
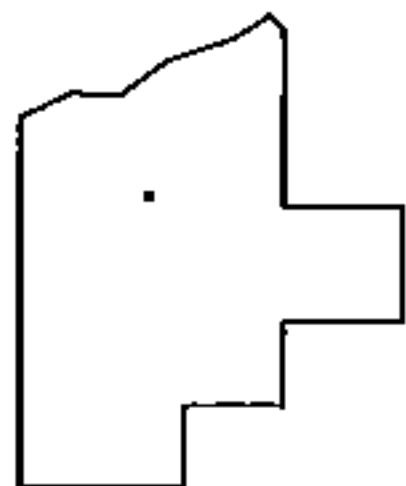
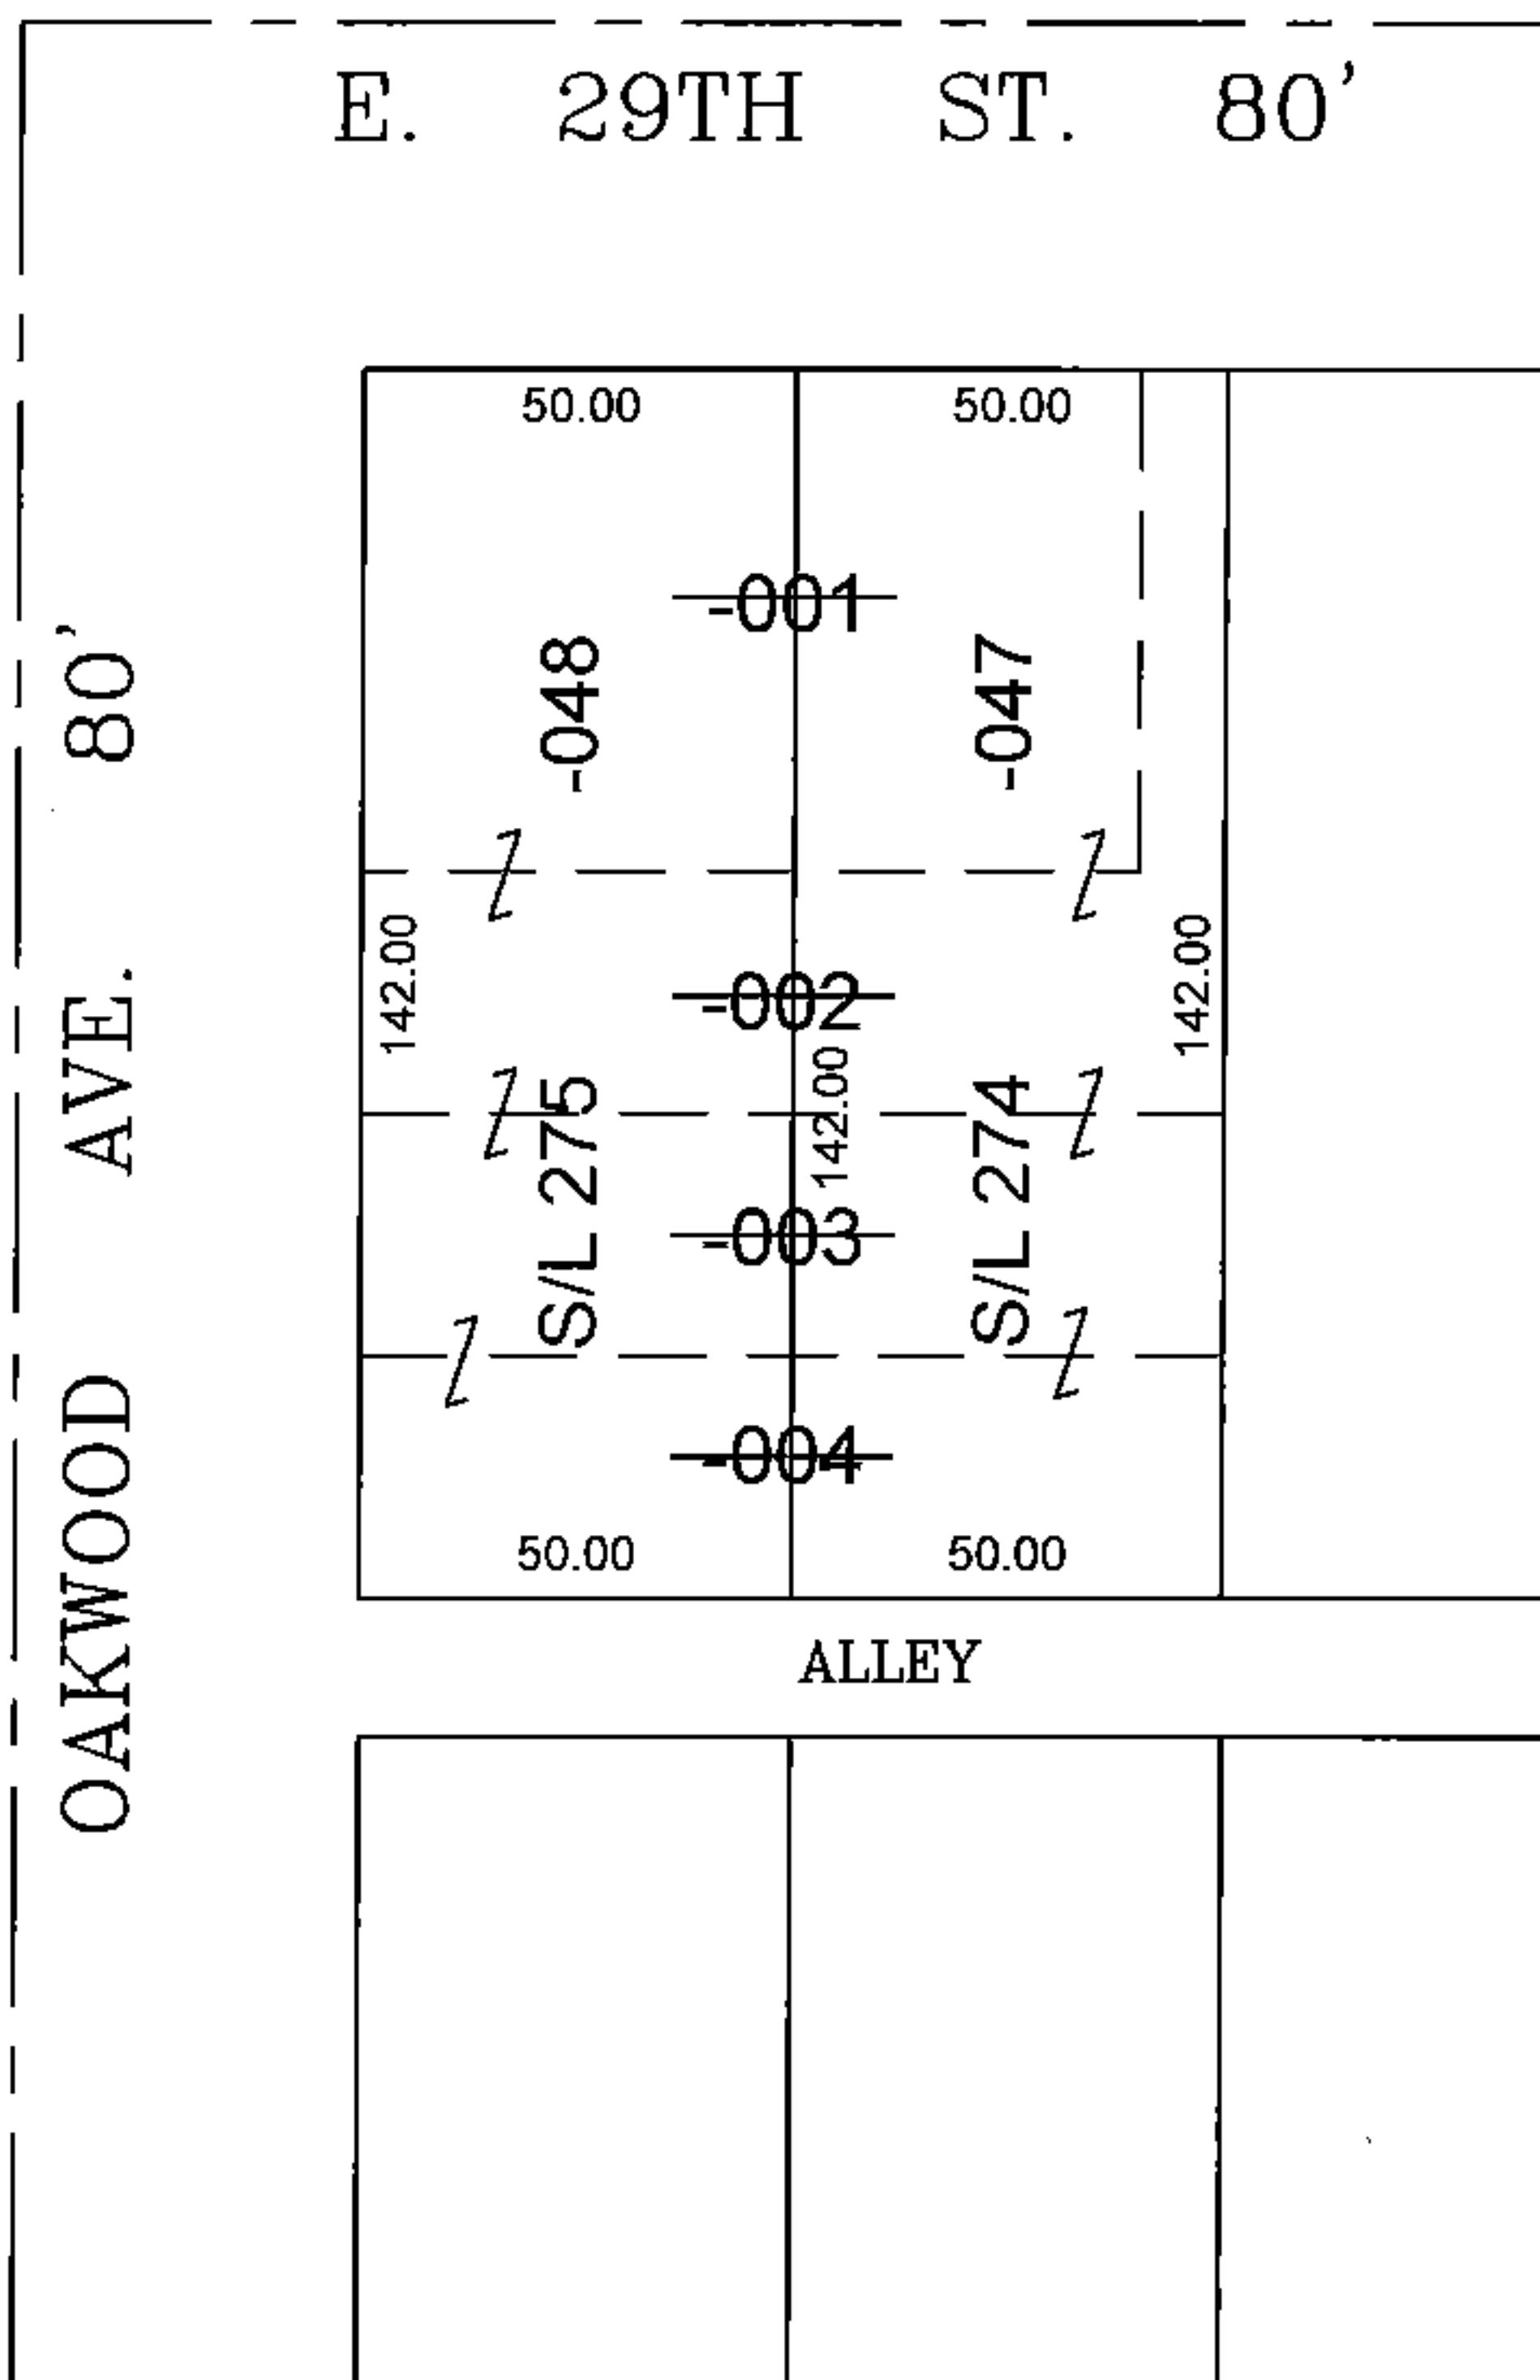


PARENT PARCEL: 03-00-094-105-001 THRU -004

CHILD PARCEL: 03-00-094-105-047 & -048

STARTING POINT: S/L 274 & S/L 275

15-03344

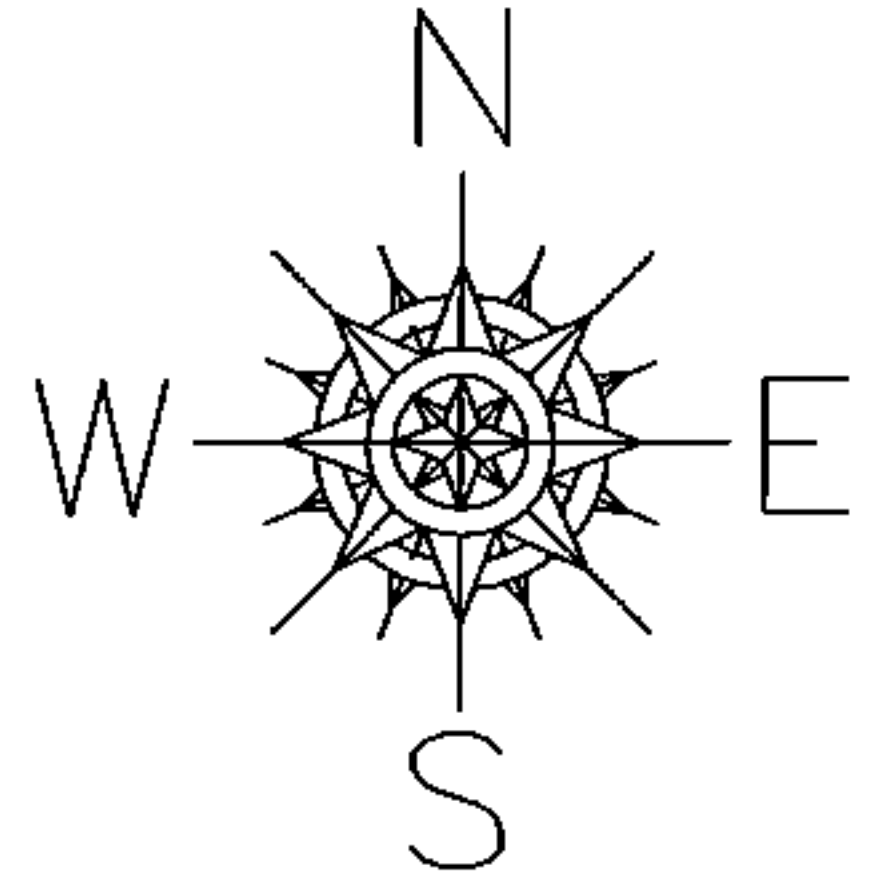

**SPLITS/DEEDS PROCESSED**  
 LORAIN COUNTY TAX MAP DEPARTMENT  
 226 MIDDLE AVE. ELYRIA, OHIO

SURVEYED BY: PLAT VOL. 7 PG. 44  
 CLOSURE: 0.00 : 10,000  
 MAP PAGE(S): 03-00-094  
 APPROVED BY: TJS DATE: 2/5/15  
 SCALE: 1"= 50' PRIOR INST.: 20020843037