
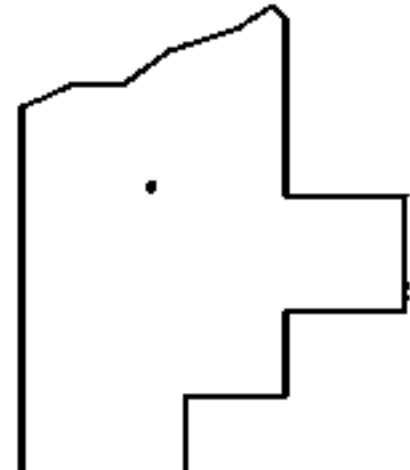
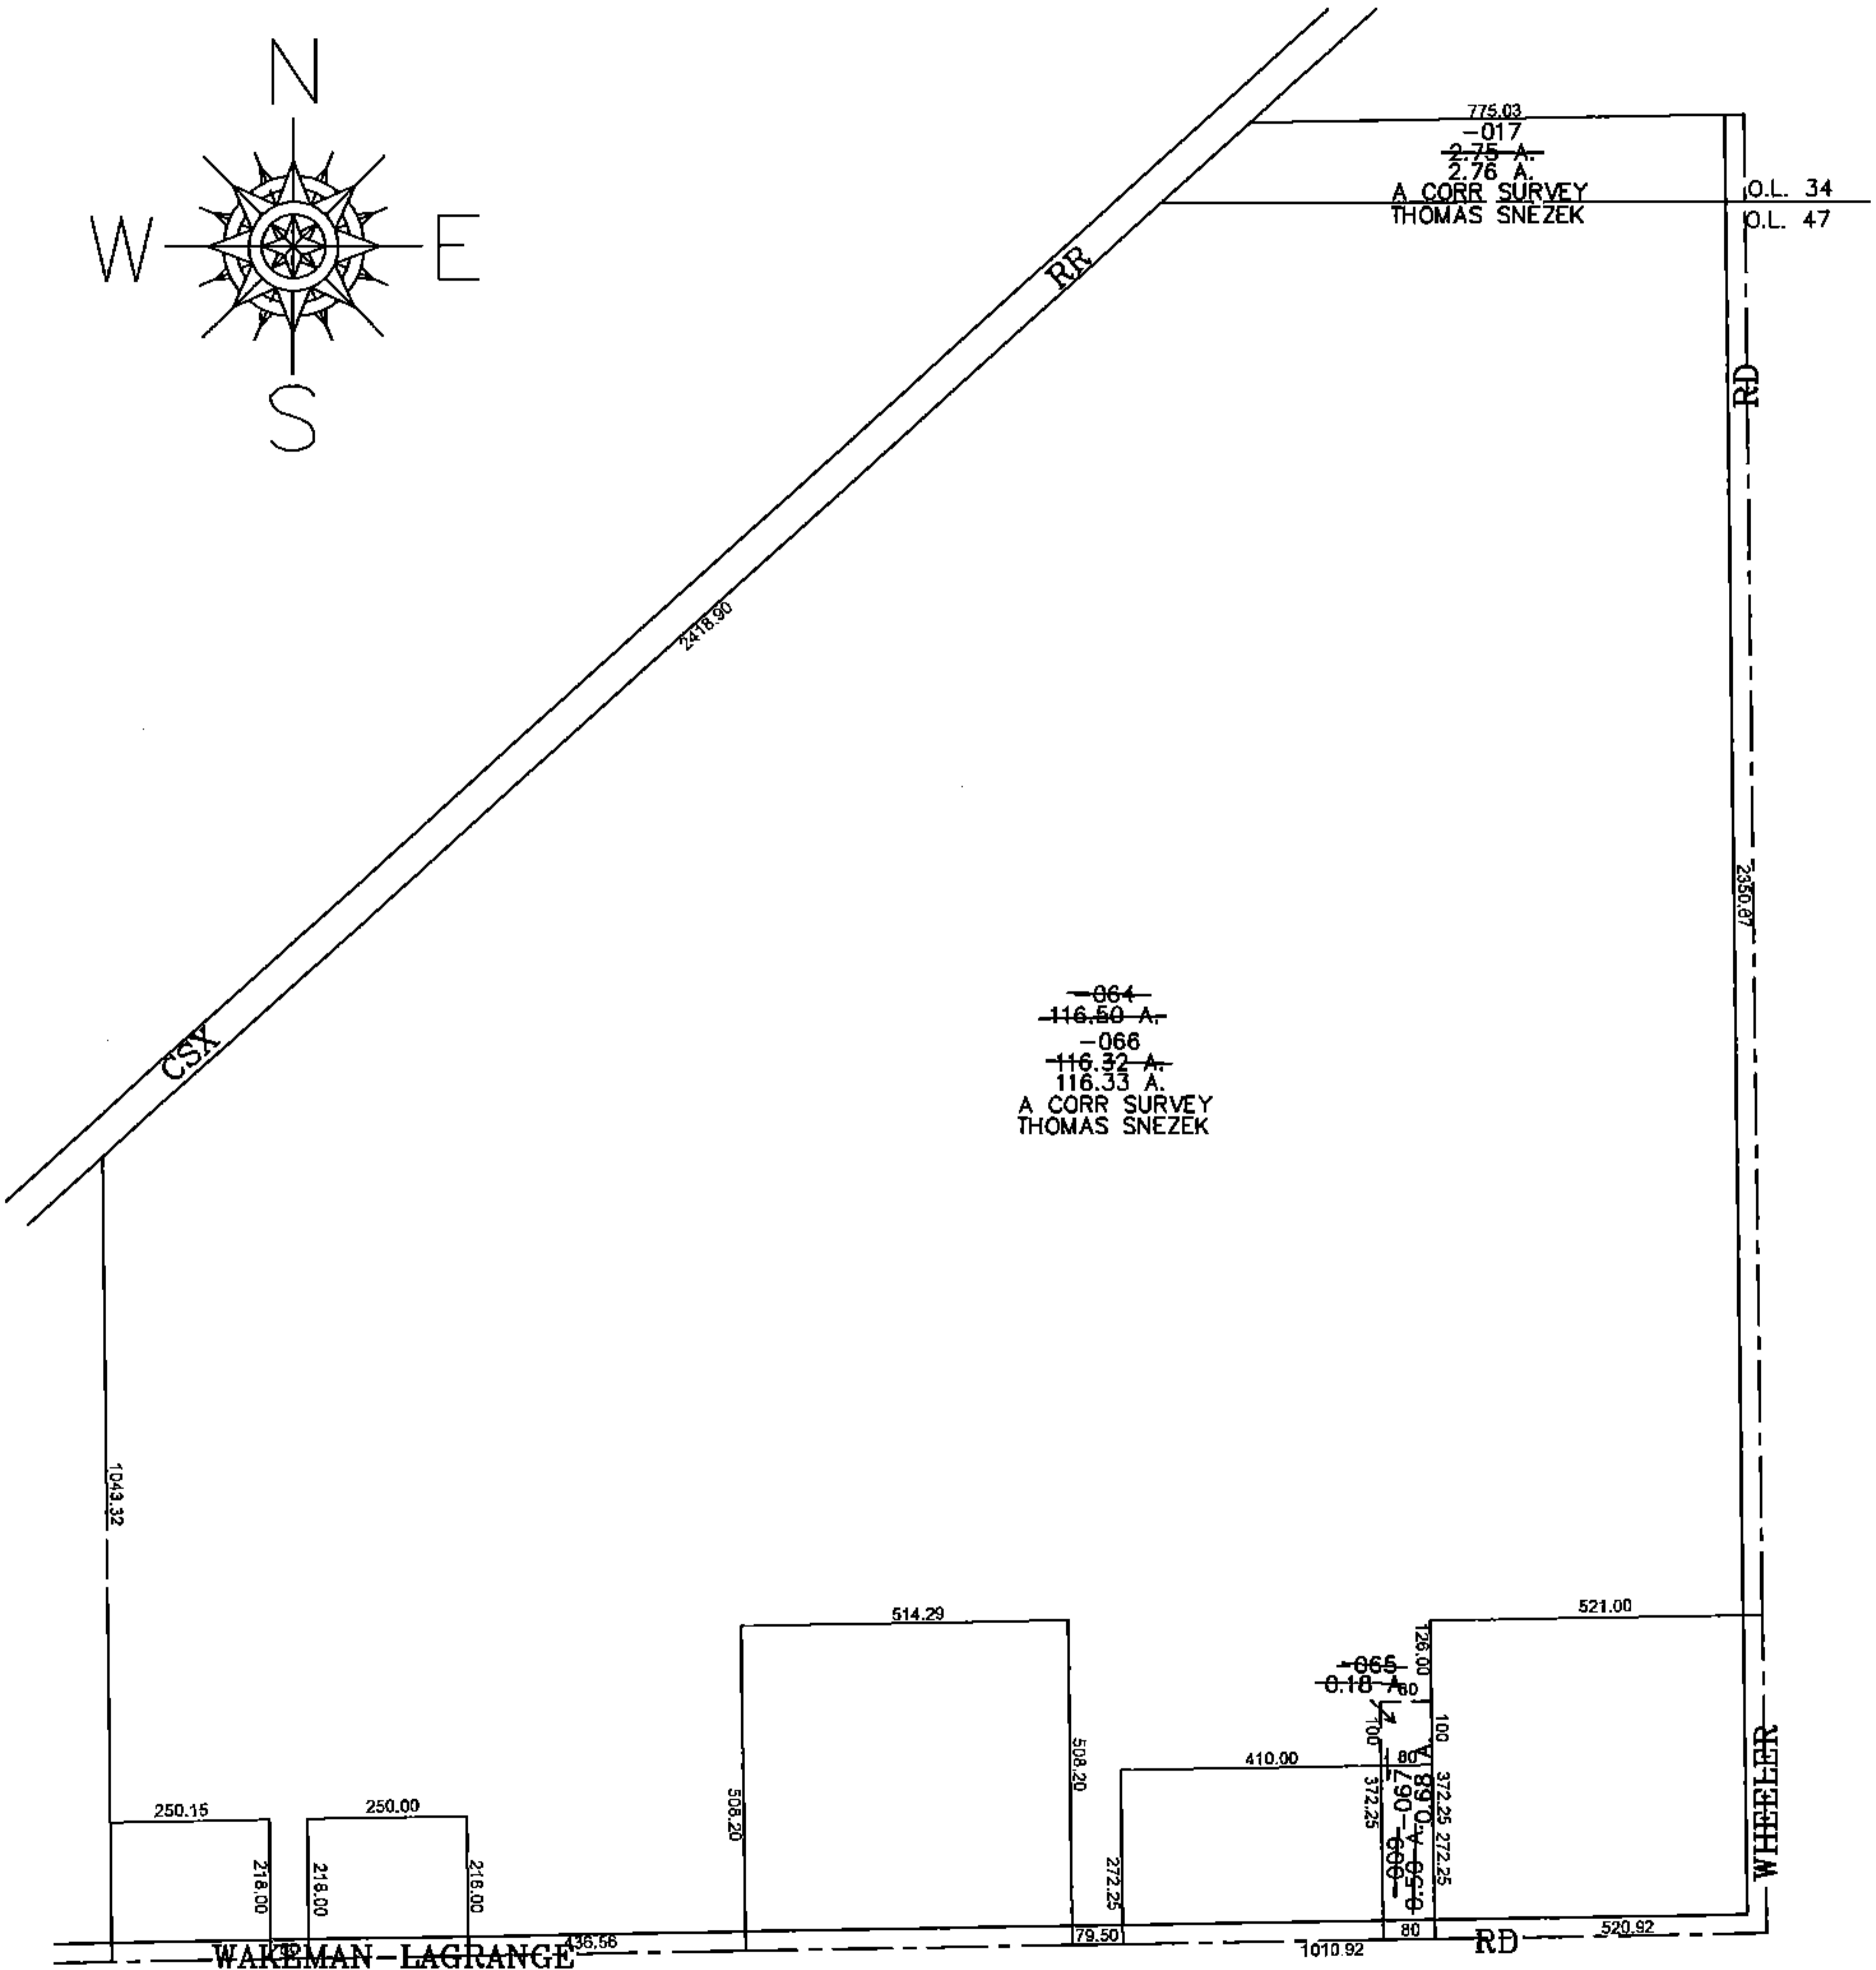


PARENT PARCEL: 15-00-047-000-064, -009 15-00-034-000-017

CHILD PARCEL: 15-00-047-000-065, -066, -067

STARTING POINT: CENTERLINE OF WHEELER RD & WAKEMAN-LAGRANGE RD

15-03345

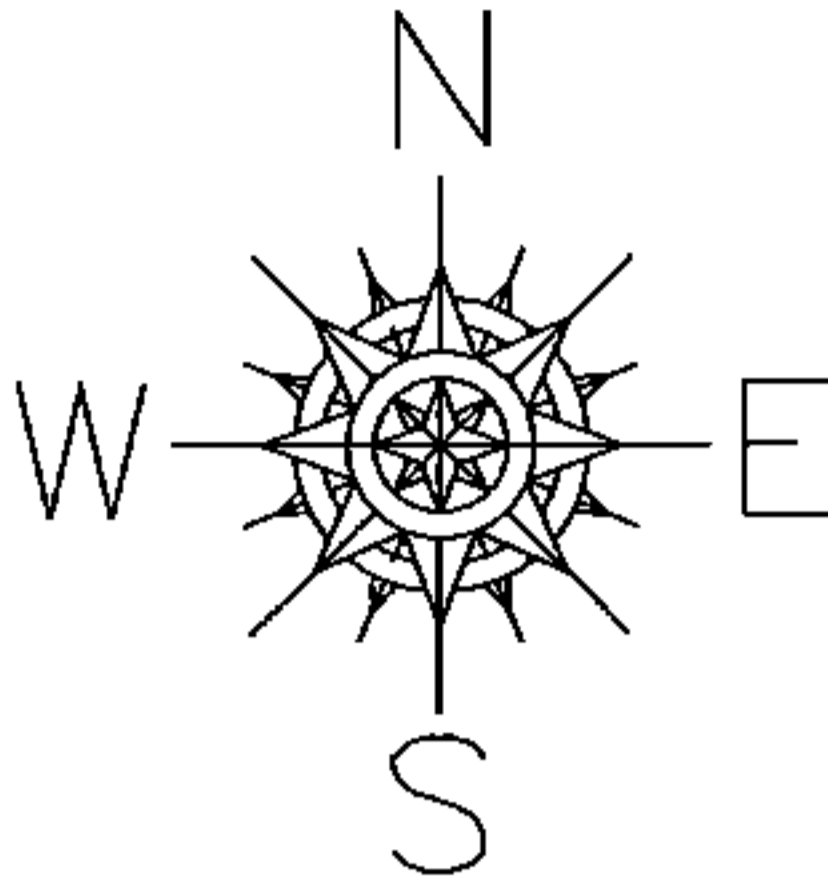

SPLITS/DEEDS PROCESSED

LORAIN COUNTY TAX MAP DEPARTMENT
226 MIDDLE AVE. ELYRIA, OHIO

SURVEYED BY: THOMAS SNEZEK
 CLOSURE: 0.00 : 10,000
 MAP PAGE(S): 15-00-047-A
 APPROVED BY: JAH DATE: 2-6-2015
 SCALE: 1" = 400 PRIOR INST.: 20060174503