
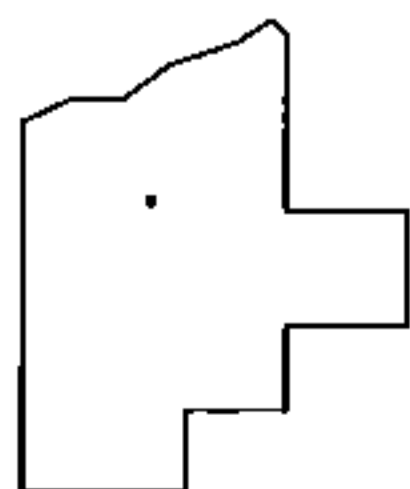
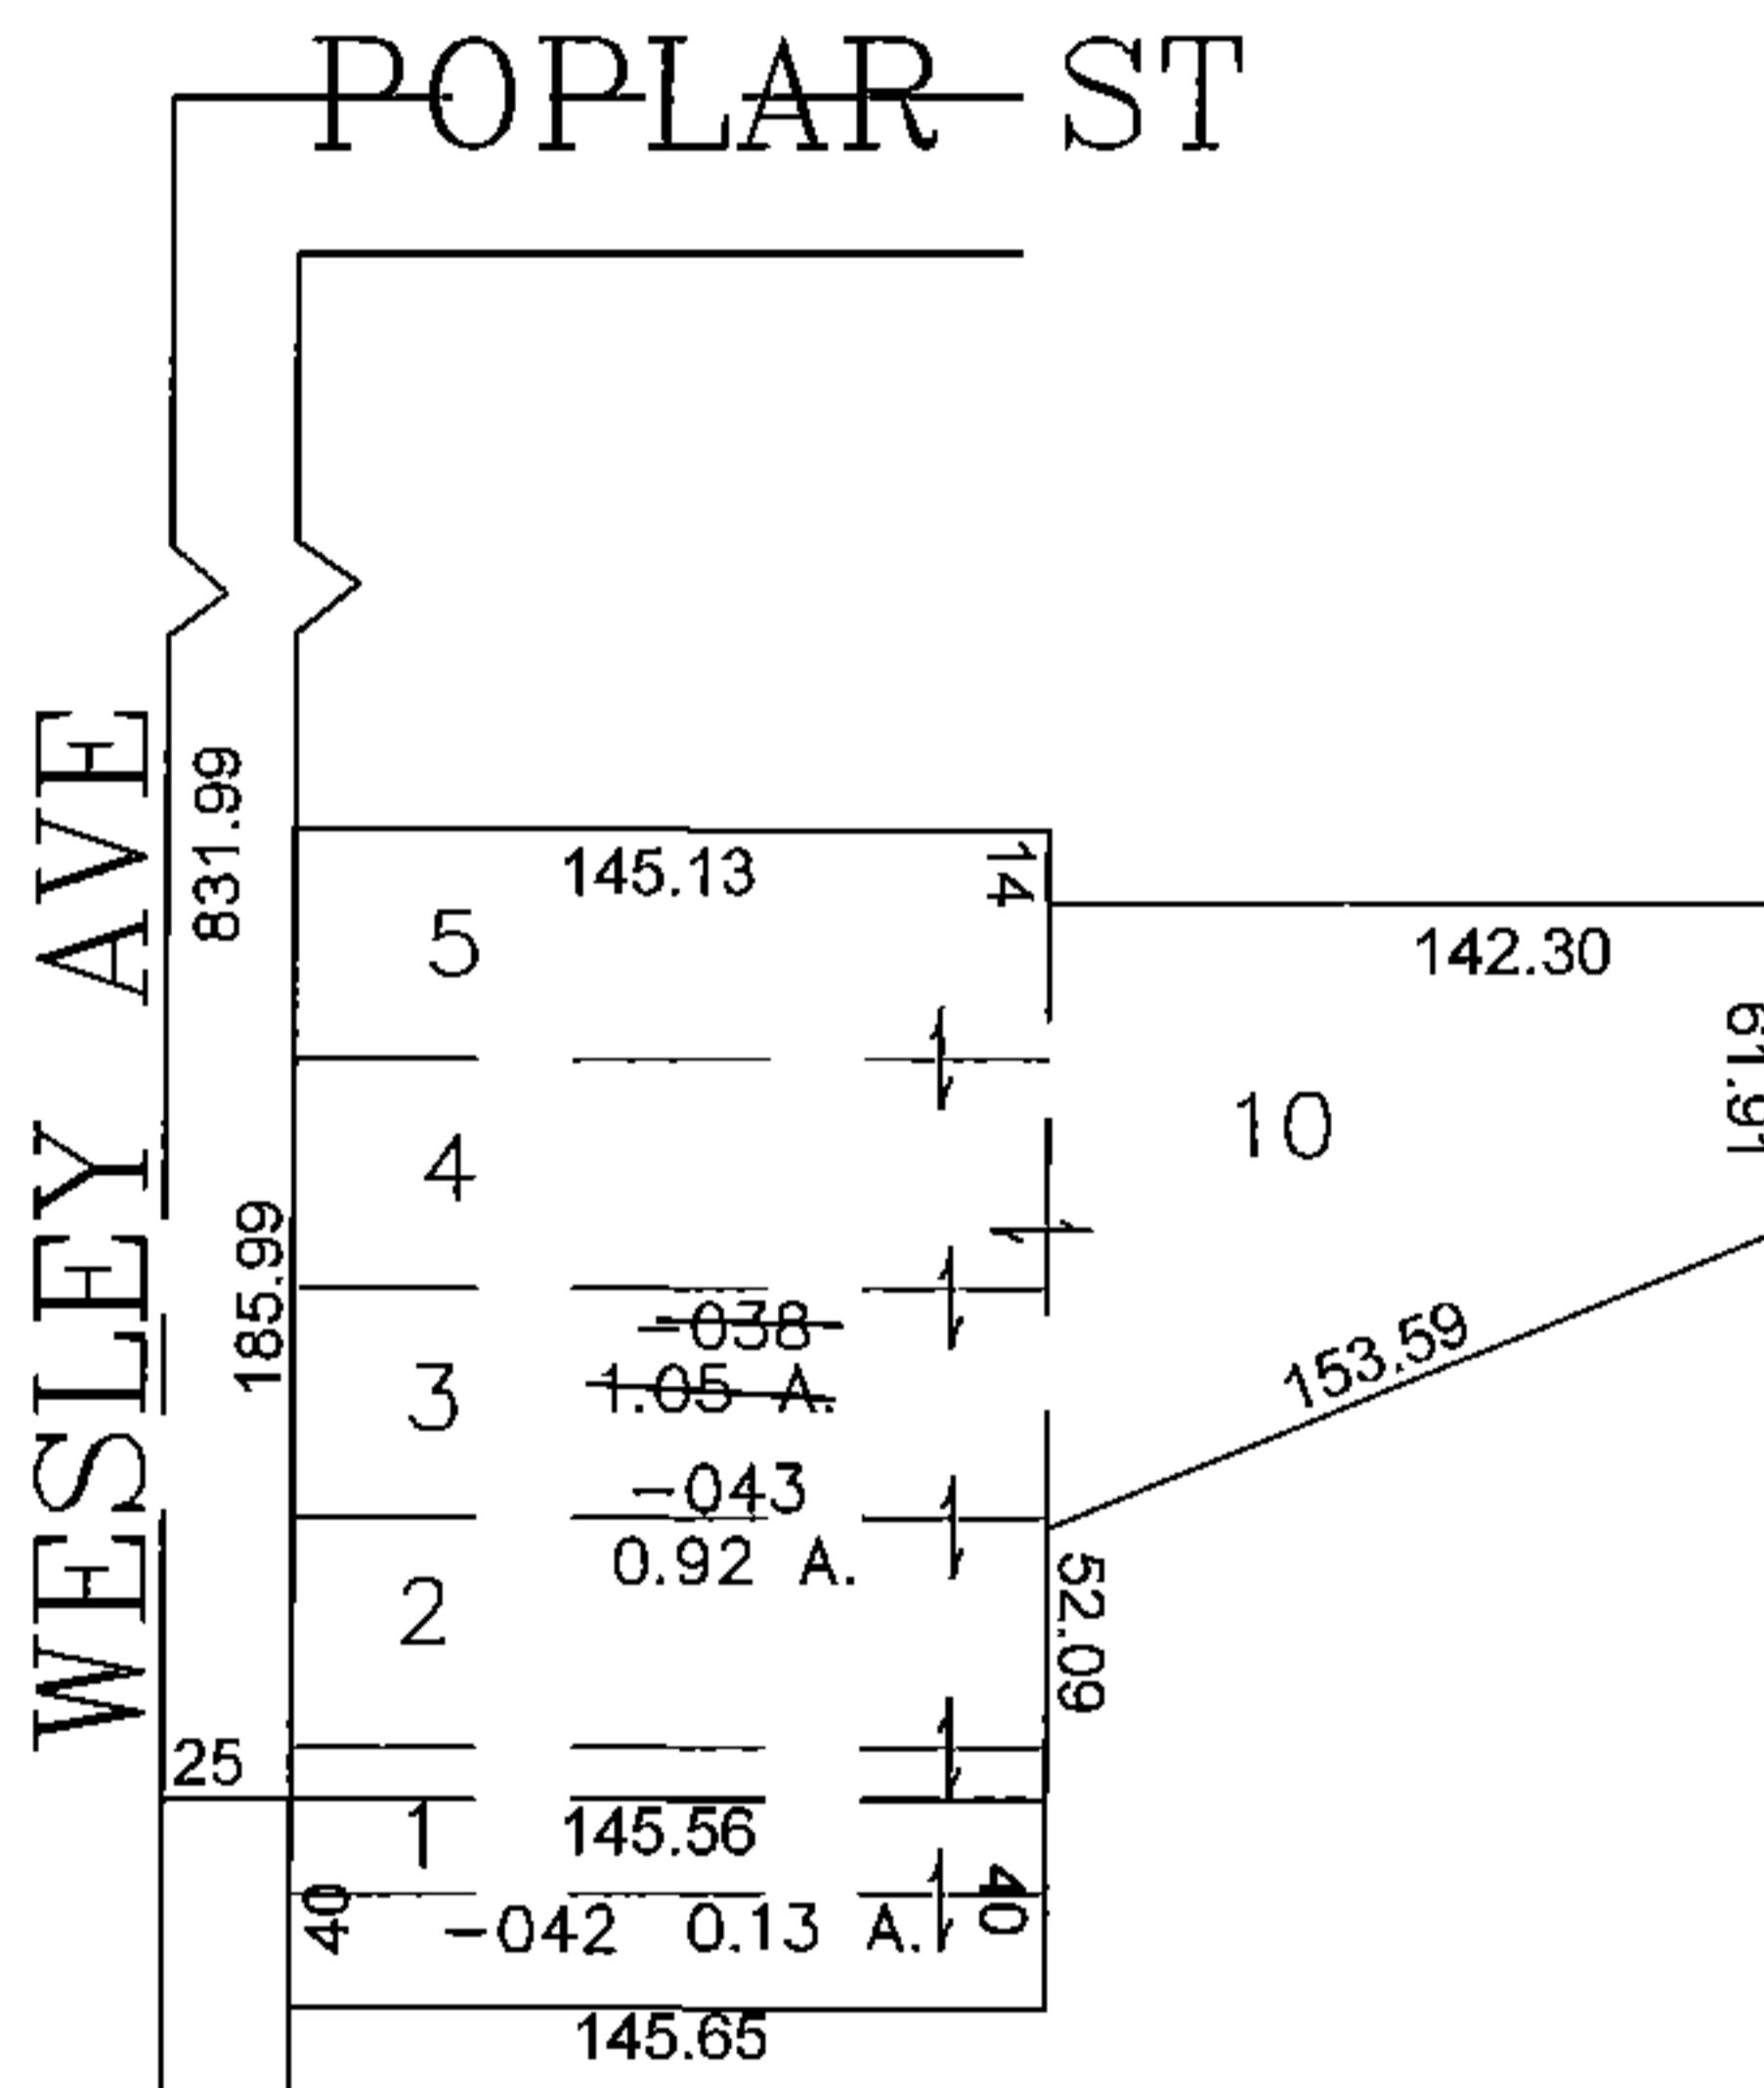


PARENT PARCEL: 06-25-023-105-038

CHILD PARCEL: 06-25-023-105-042, -043

STARTING POINT: CENTERLINE OF WESLEY AVE & POPLAR ST

15-03346

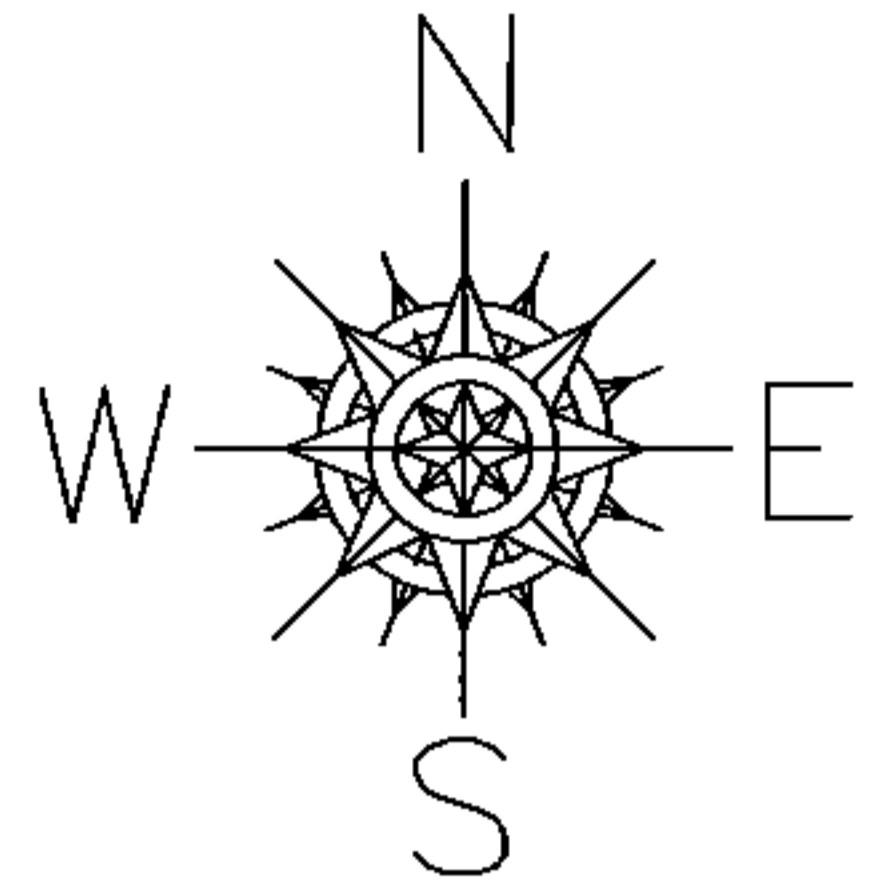

SPLITS/DEEDS PROCESSED

LORAIN COUNTY TAX MAP DEPARTMENT
226 MIDDLE AVE. ELYRIA, OHIO

SURVEYED BY: THOMAS SIMON

CLOSURE: 0.00 : 10.000

MAP PAGE(S): 6-89

APPROVED BY: JAH DATE: 2-10-2015

SCALE: 1" = 100 PRIOR INSTRUMENT: 20100330809