
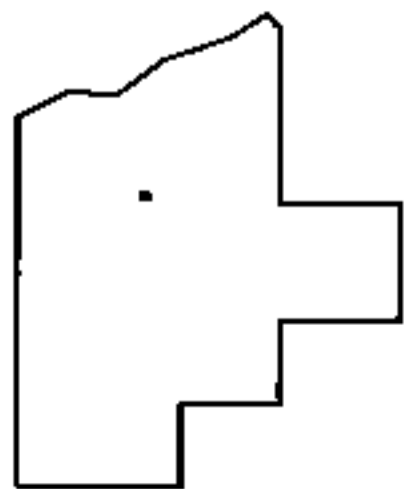
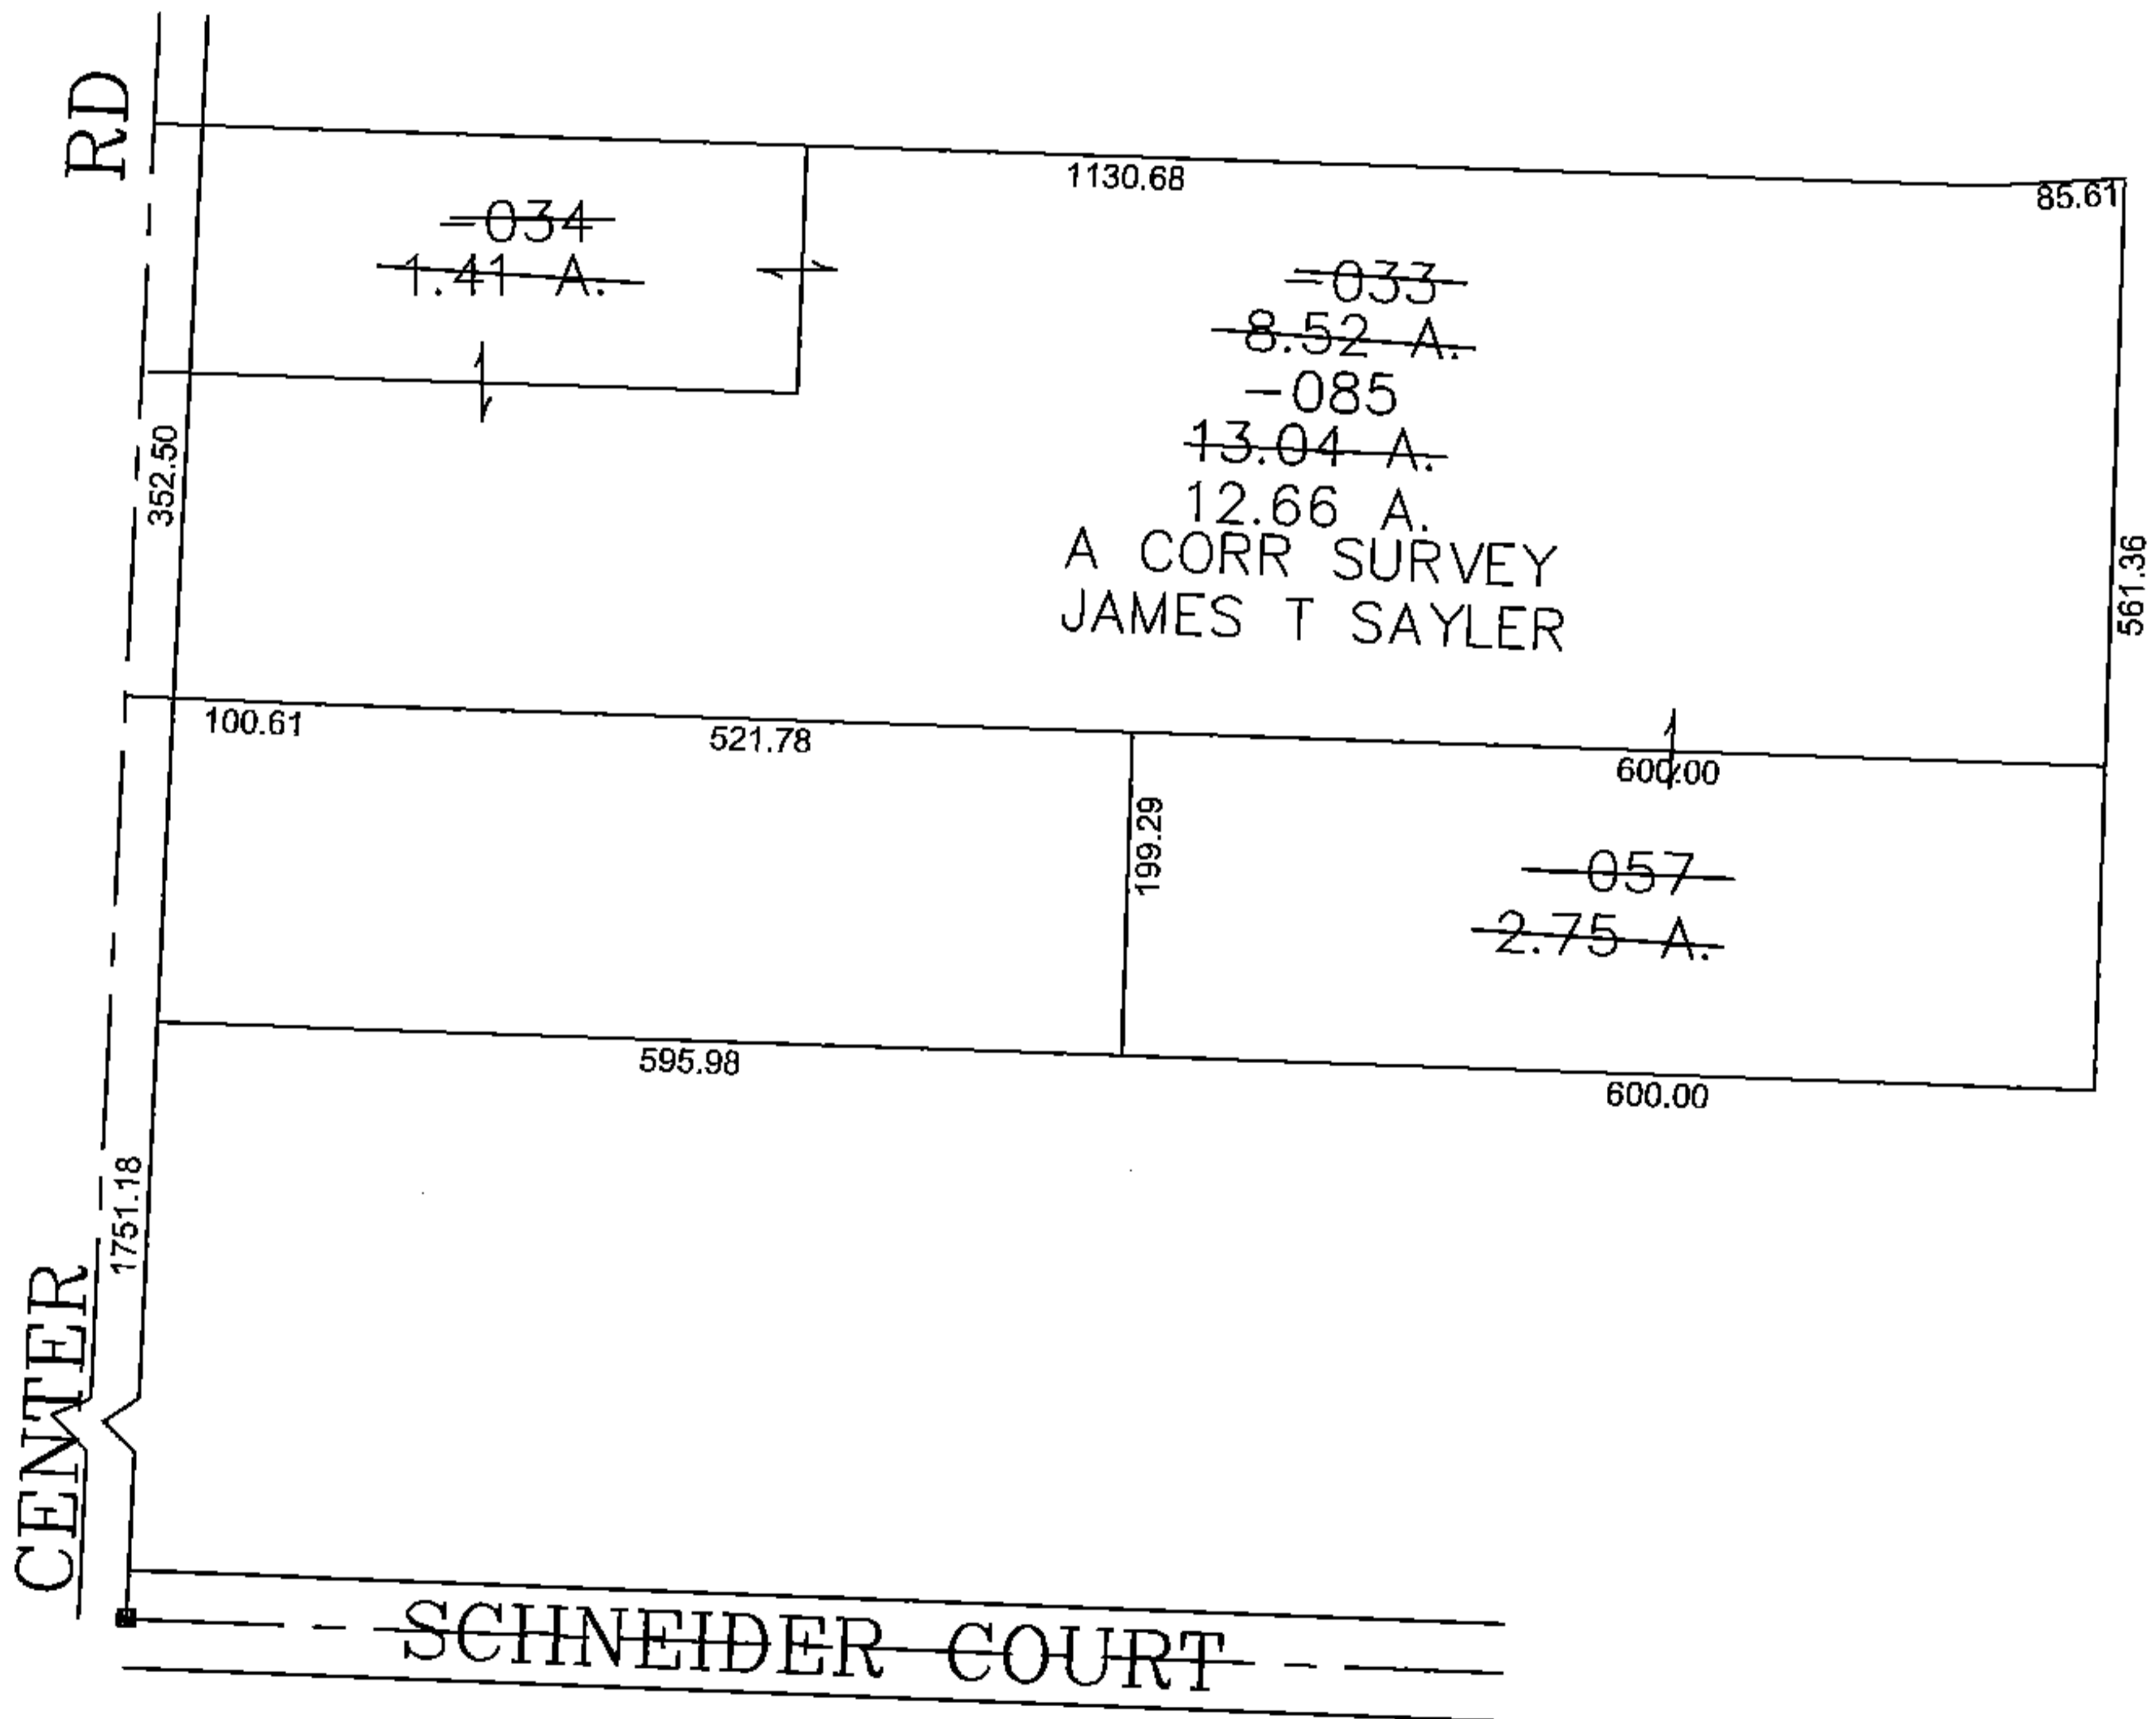


PARENT PARCEL: 04-00-016-102-057, 033, -034

CHILD PARCEL: 04-00-016-102-085

STARTING POINT: SIDELING OF CENTER RD & CENTERLINE OF SCHNEIDER COURT

15-03349

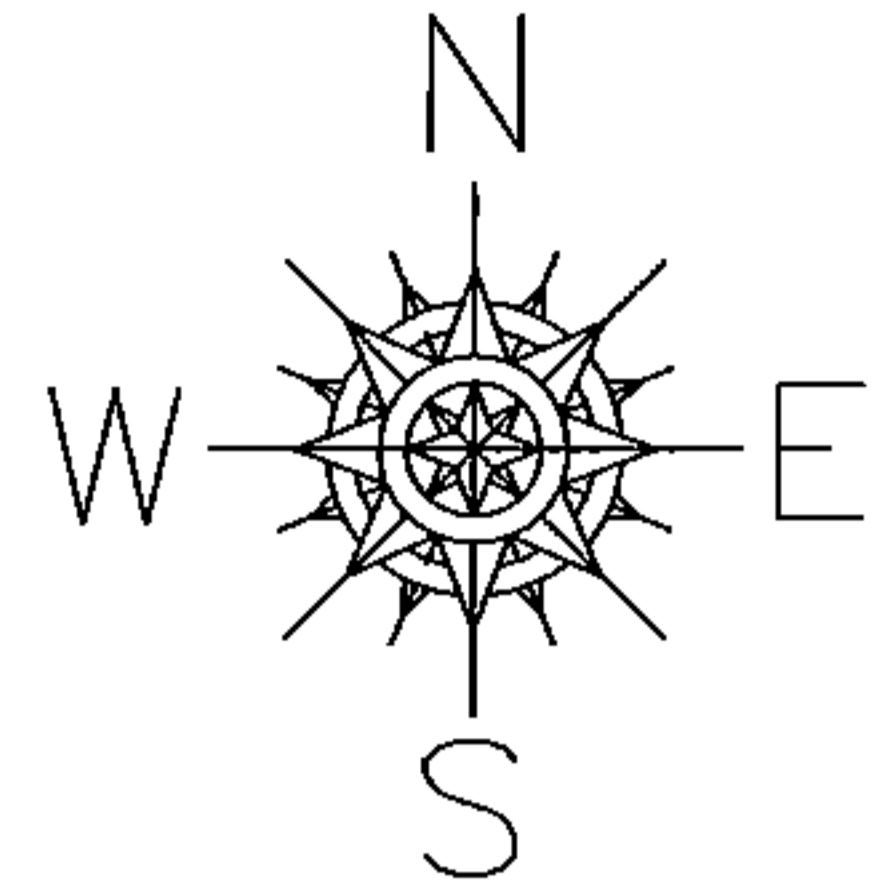

**SPLITS/DEEDS PROCESSED**  
 LORAIN COUNTY TAX MAP DEPARTMENT  
 226 MIDDLE AVE. ELYRIA, OHIO

SURVEYED BY: JAMES T SAYLER  
 CLOSURE: 0.00 : 10.000  
 MAP PAGE(S): 04-00-016  
 APPROVED BY: JAH DATE: 2/19/2015  
 SCALE: 1" = 200' PRIOR INSTRUMENT: 20100345225