
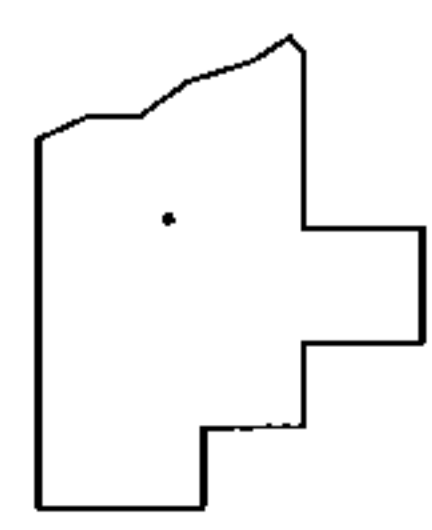
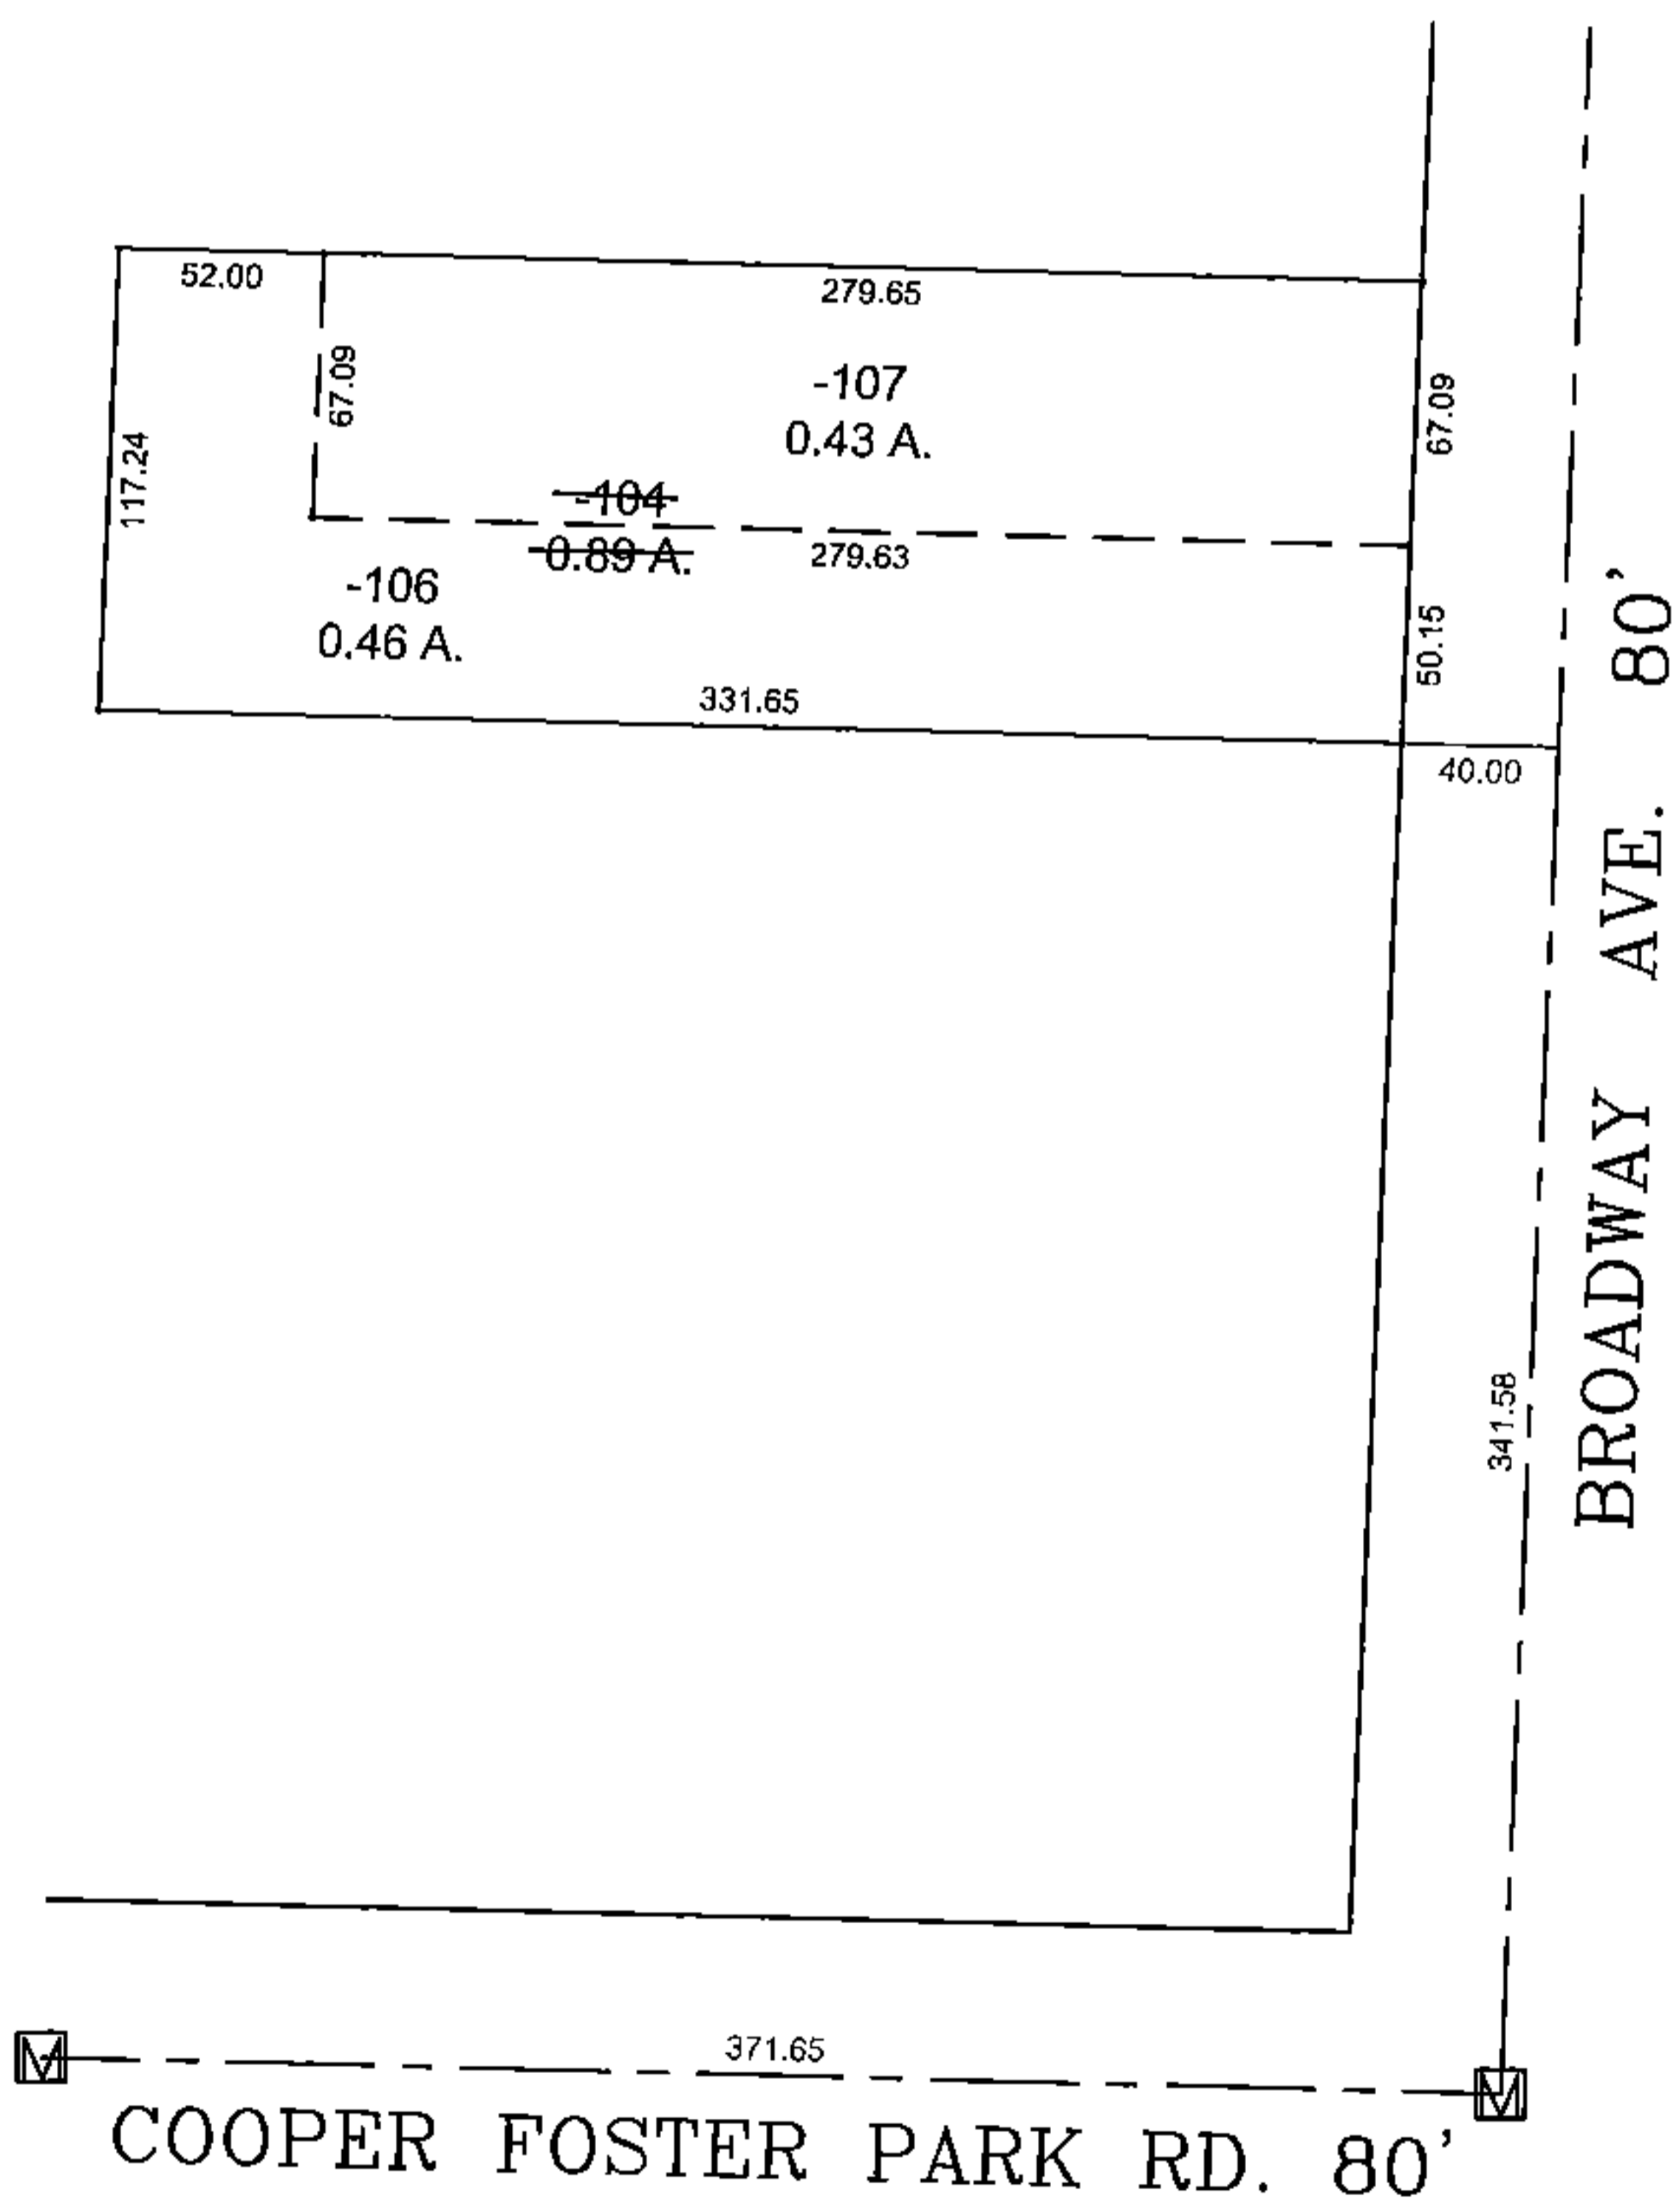


PARENT PARCEL: 03-00-113-102-104  
CHILD PARCEL: 03-00-113-102-106 & -107  
STARTING POINT: I.P. MON. BOX, CL OF COOPER FOSTER PARK RD. & CL OF BROADWAY AVE.

**15-03350**

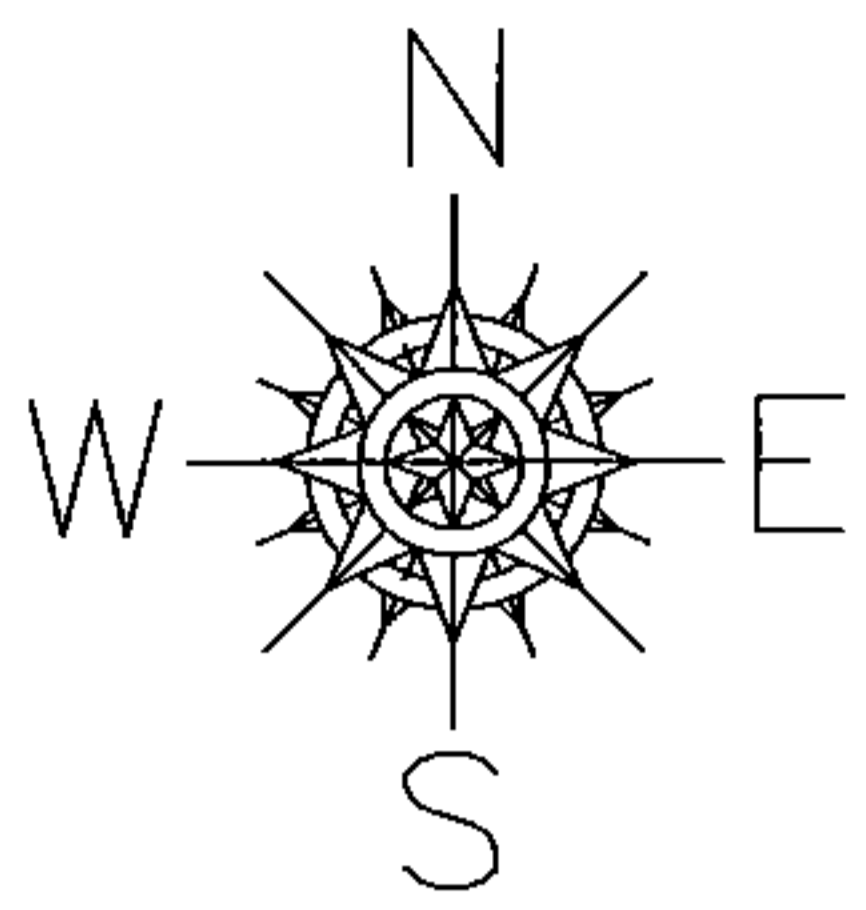

**SPLITS/DEEDS PROCESSED**  
LORAIN COUNTY TAX MAP DEPARTMENT  
226 MIDDLE AVE. ELYRIA, OHIO

SURVEYED BY: MICHAEL P. SPELLACY  
CLOSURE: 1 : 44,000  
MAP PAGE(S): 3-00-113  
APPROVED BY: TJS DATE: 3/23/15  
SCALE: 1" = 100 PRIOR INST.: 20020828141