
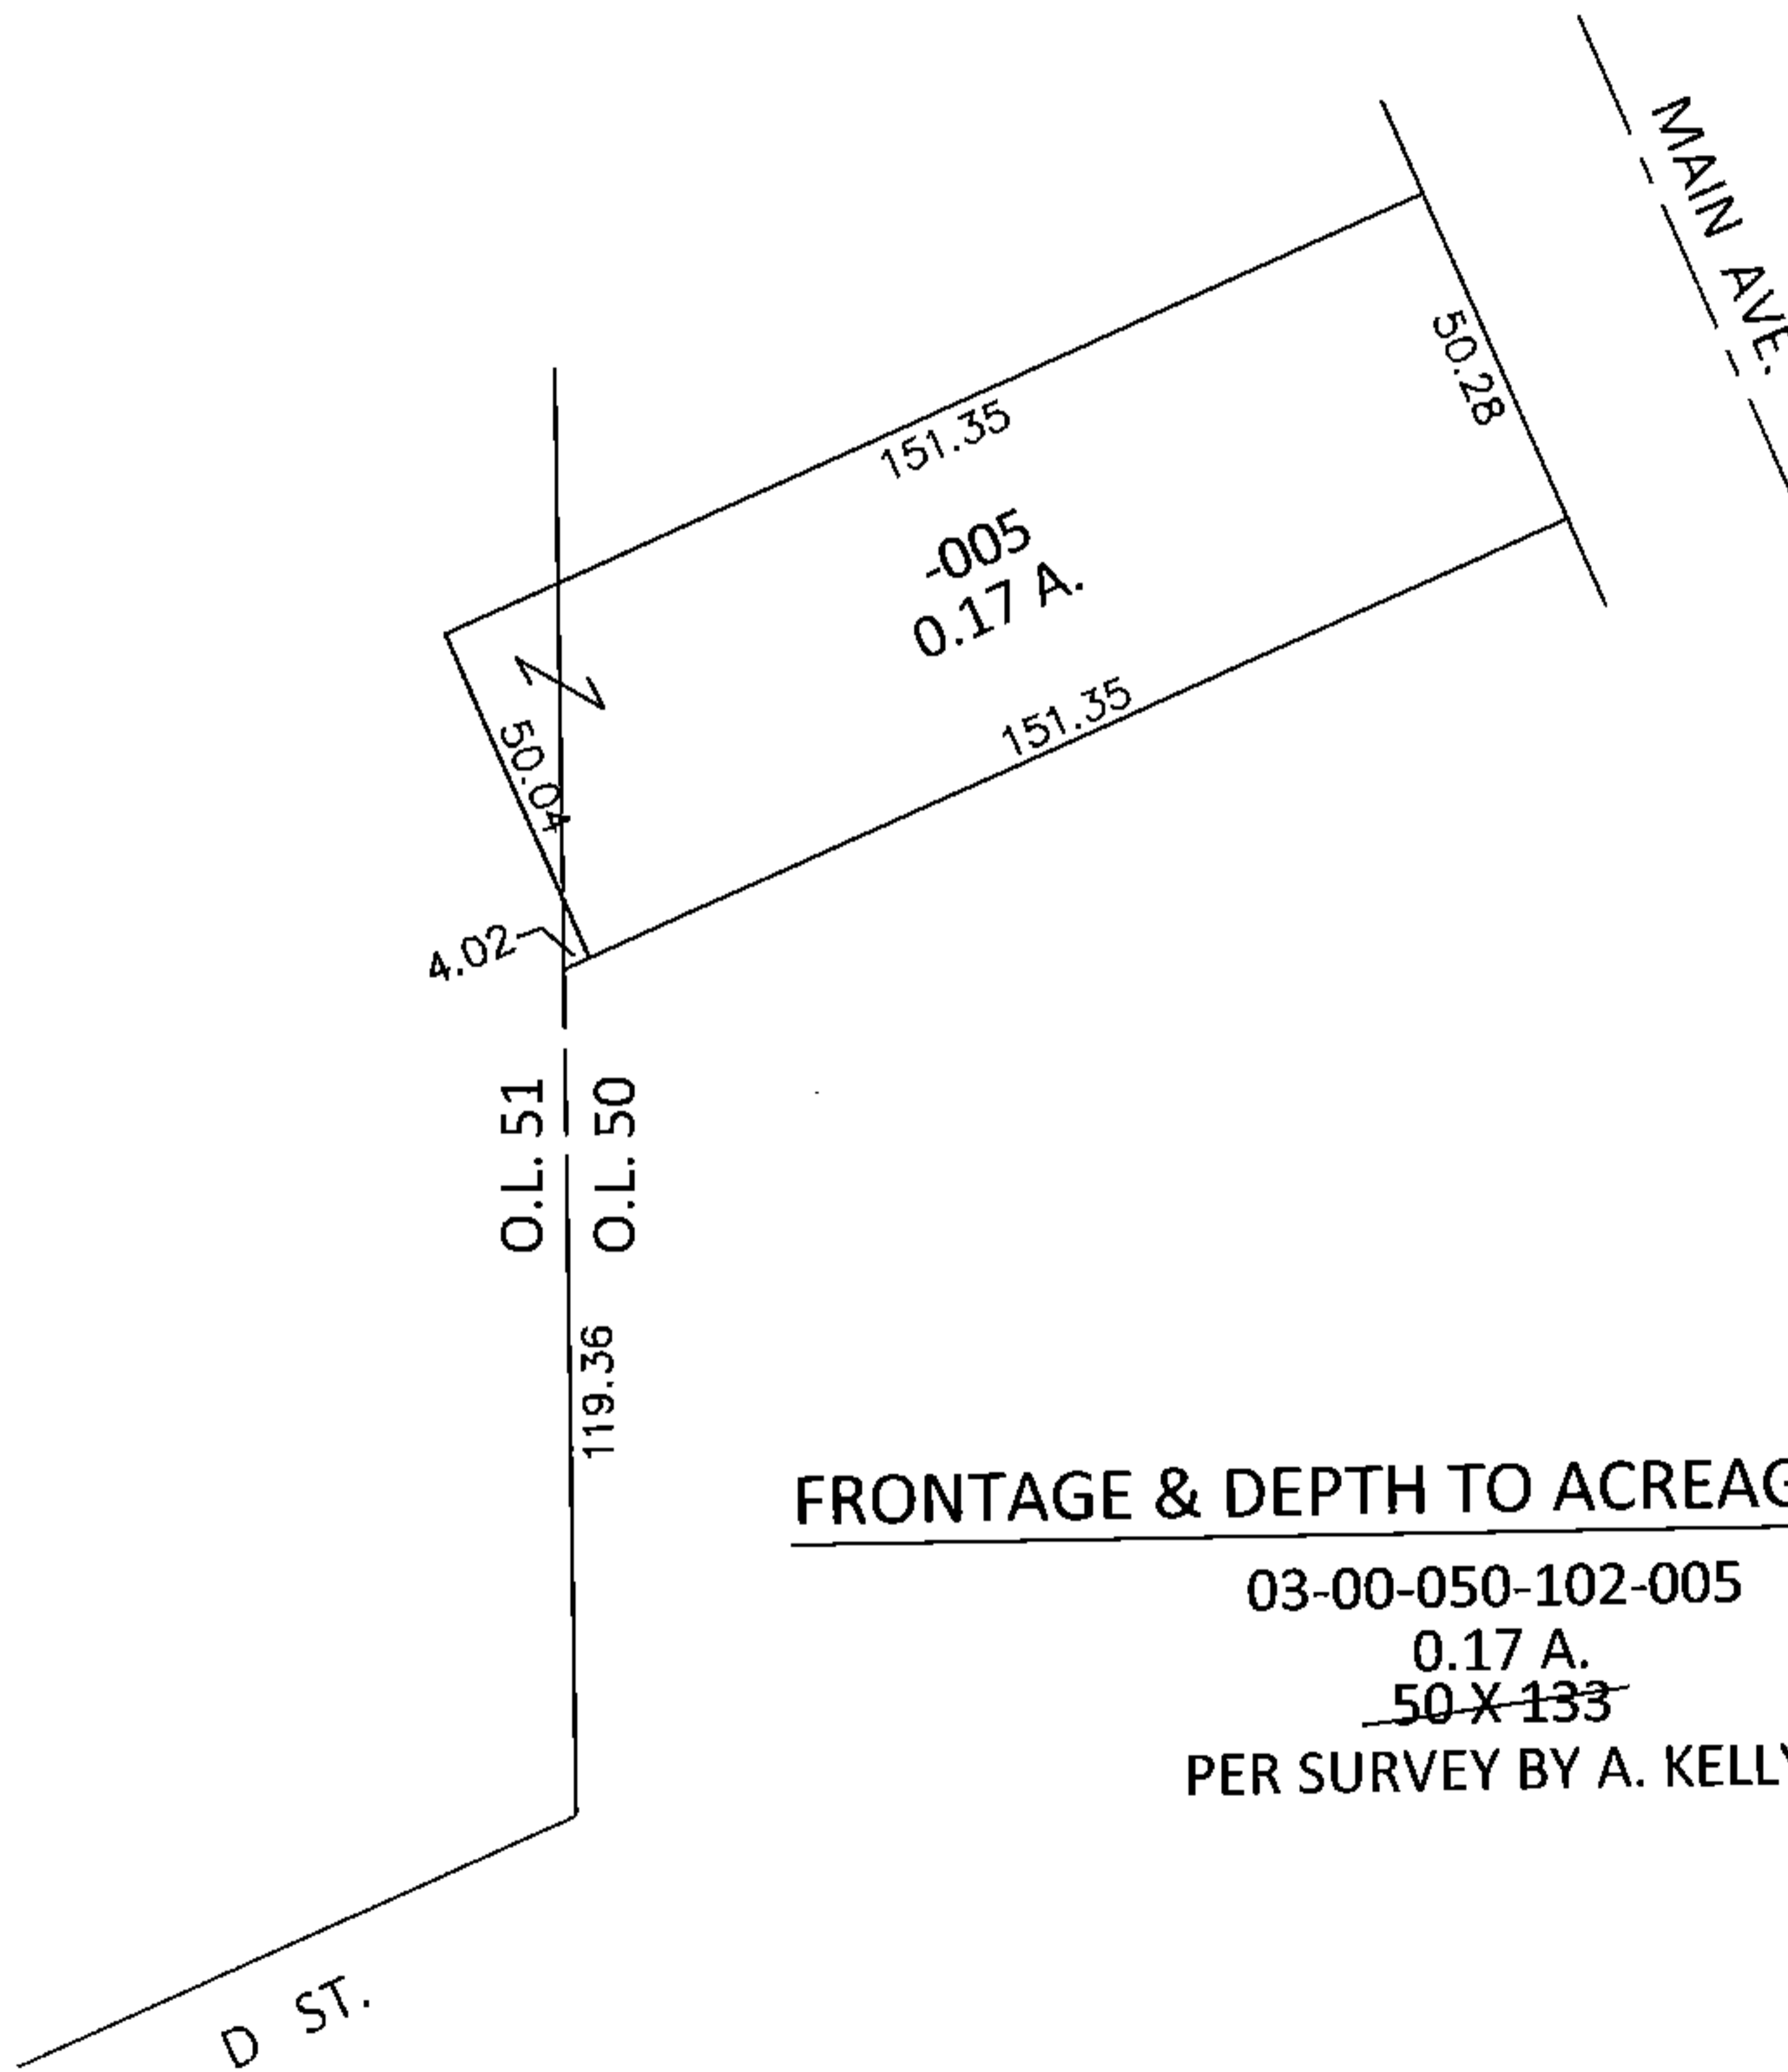


PARENT PARCEL: 03-00-050-102-005

CHILD PARCEL: _____

STARTING POINT: INTERSECTION OF WEST LINE OF O.L.50 AND NORTH LINE OF D ST.

15-03351-X

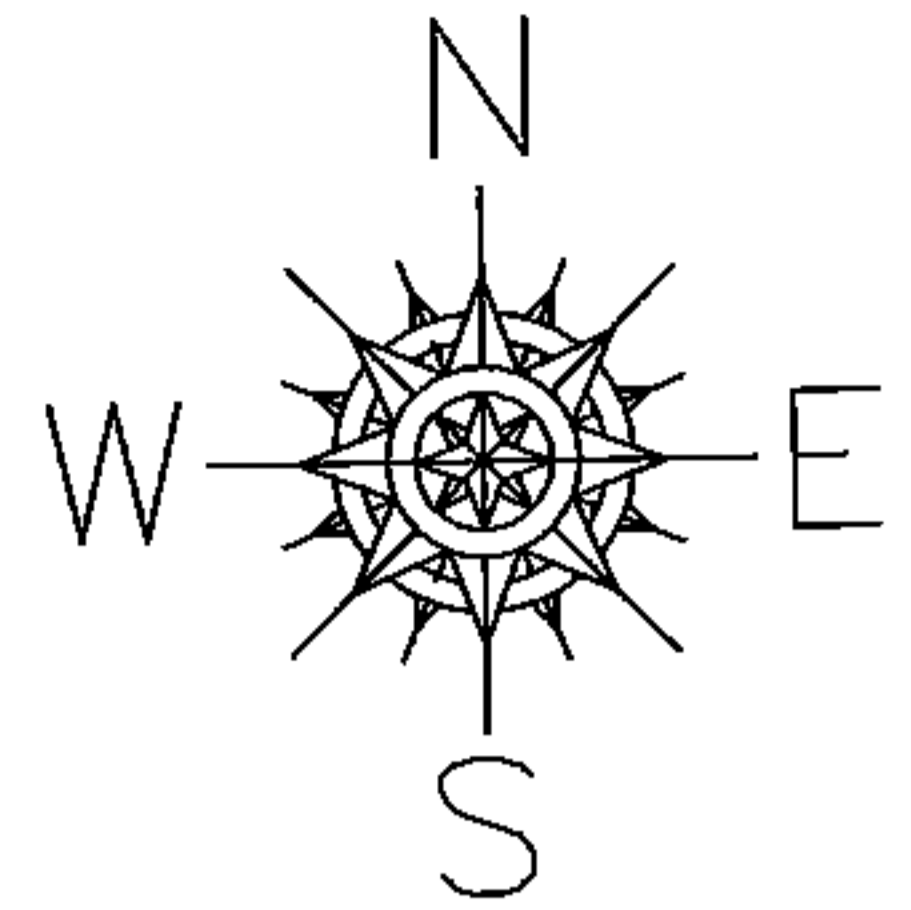


FRONTAGE & DEPTH TO ACREAGE CORRECTION

03-00-050-102-005

0.17 A.

~~50 X 133~~

PER SURVEY BY A. KELLY

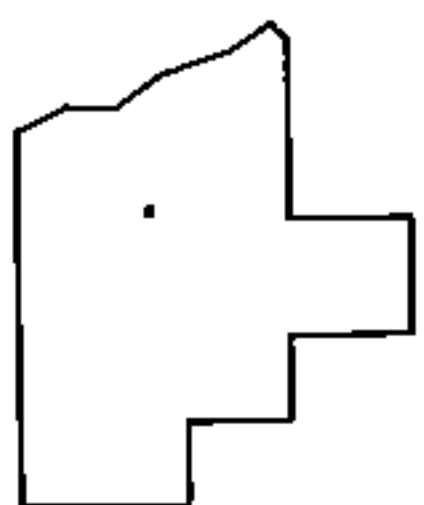

SPLITS/DEEDS PROCESSED

LORAIN COUNTY TAX MAP DEPARTMENT
226 MIDDLE AVE. ELYRIA, OHIO

SURVEYED BY: AMY M. KELLY

CLOSURE: .01:10,000

MAP PAGE(S): 3-00-050

APPROVED BY: RRM DATE: 12-29-15

SCALE: 1"= 50' PRIOR INST.: 20120433358