
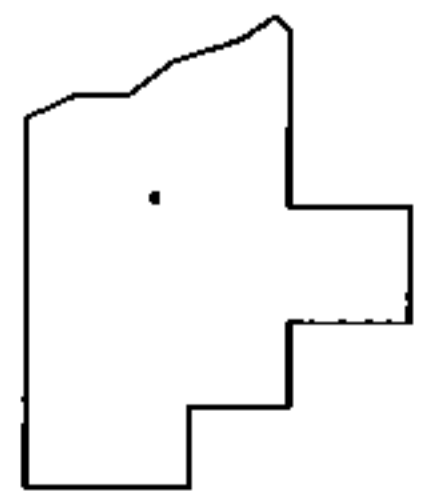
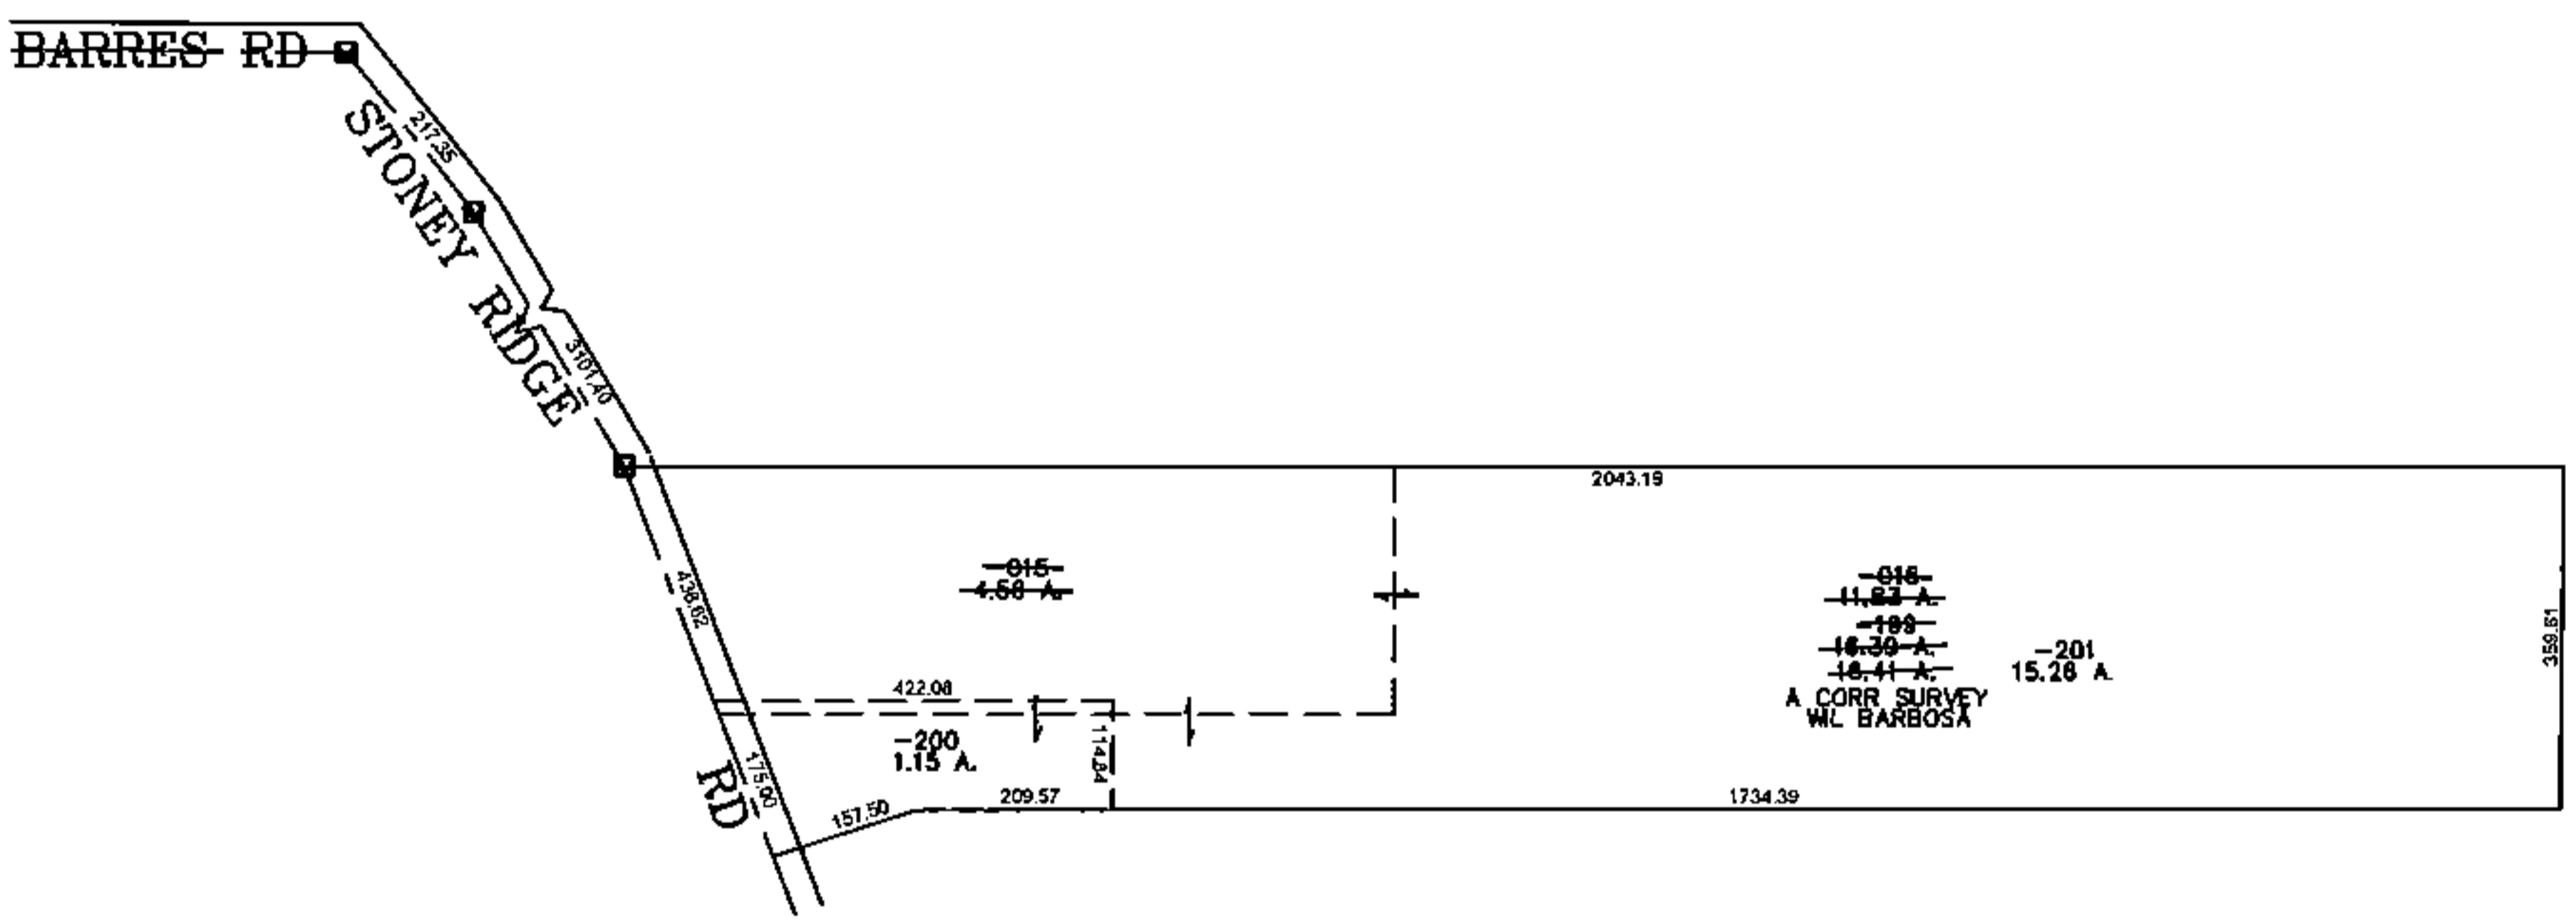


PARENT PARCEL: 07-00-029-000-015, -016
CHILD PARCEL: 07-00-029-000-199 THRU -201
STARTING POINT: CENTERLINE OF BARRES RD & STONEY RIDGE RD

15-03351

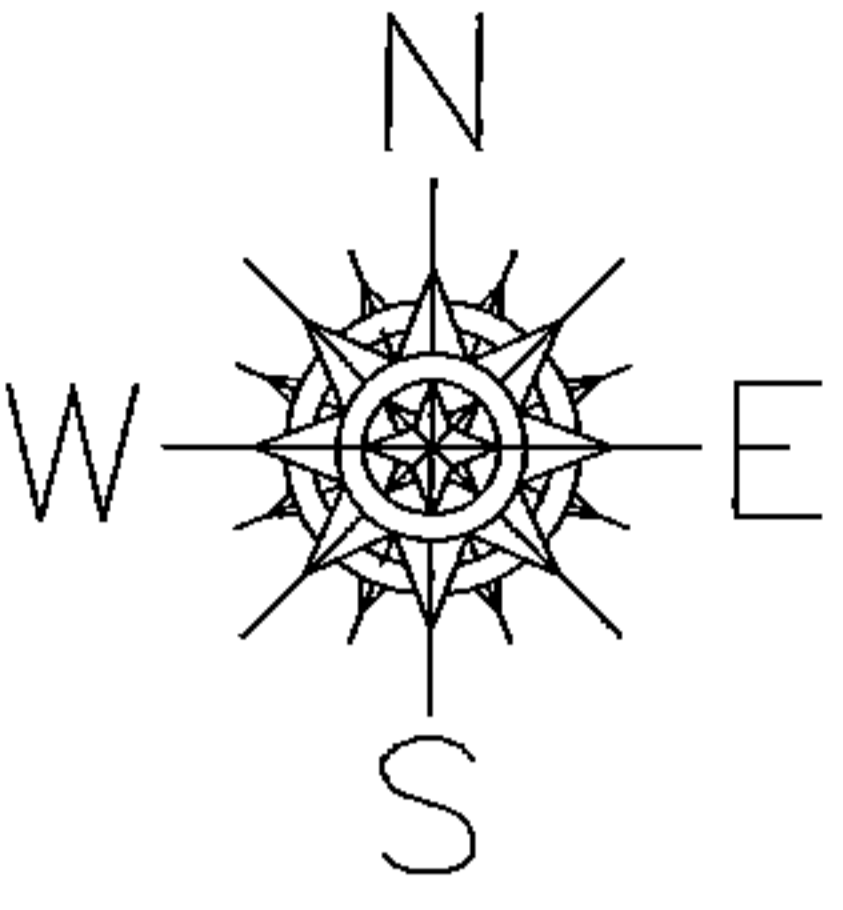

SPLITS/DEEDS PROCESSED
LORAIN COUNTY TAX MAP DEPARTMENT
226 MIDDLE AVE. ELYRIA, OHIO

SURVEYED BY: WIL BARBOSA
CLOSURE: 0.00 : 10,000
MAP PAGE(S): 07-00-029-C
APPROVED BY: JAH DATE: 3-9-2015
SCALE: 1"= 400 PRIOR INST.: 20000672794