
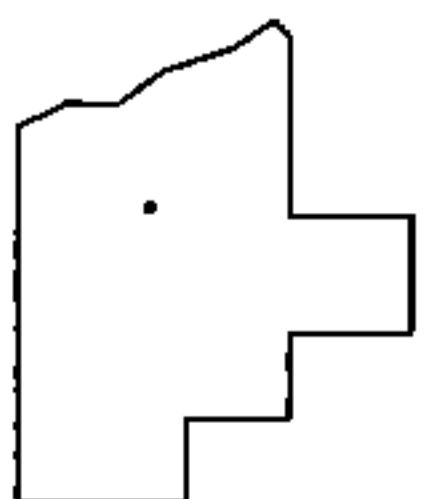
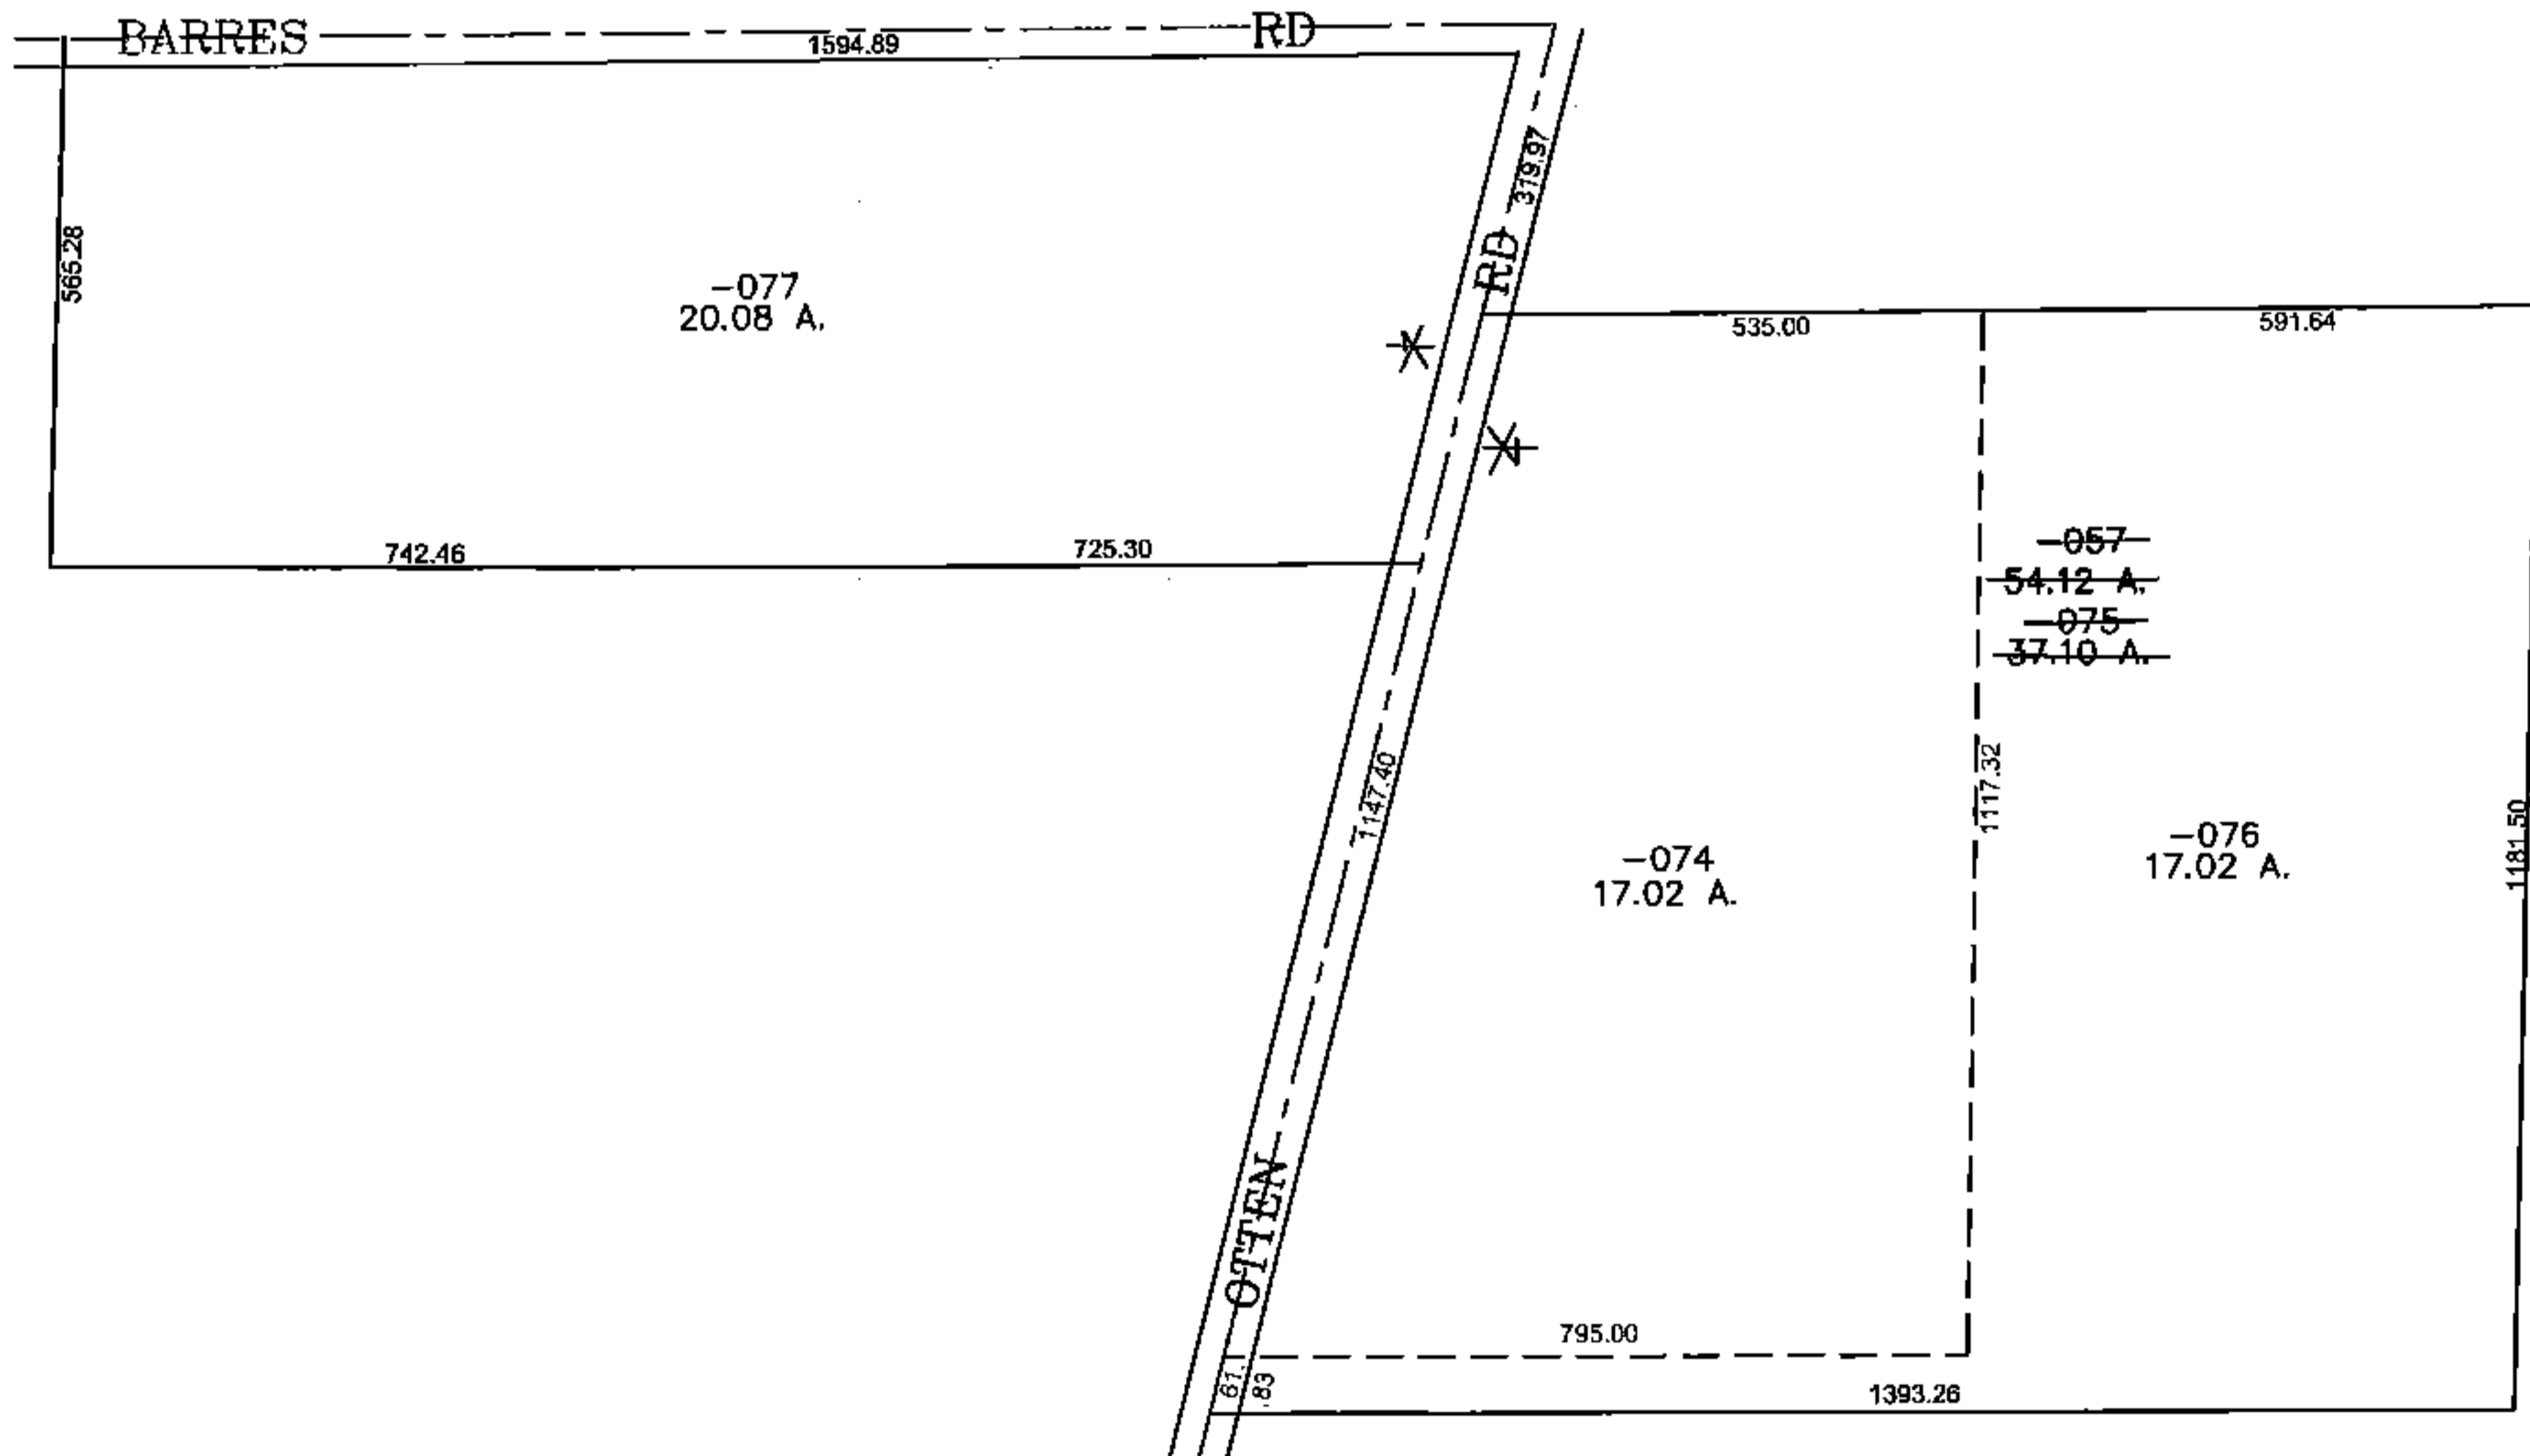


PARENT PARCEL: 07-00-041-000-057

CHILD PARCEL: 07-00-041-000-074 THRU -077

STARTING POINT: CENTERLINE OF BARRES RD & OTTEN RD

15-03352

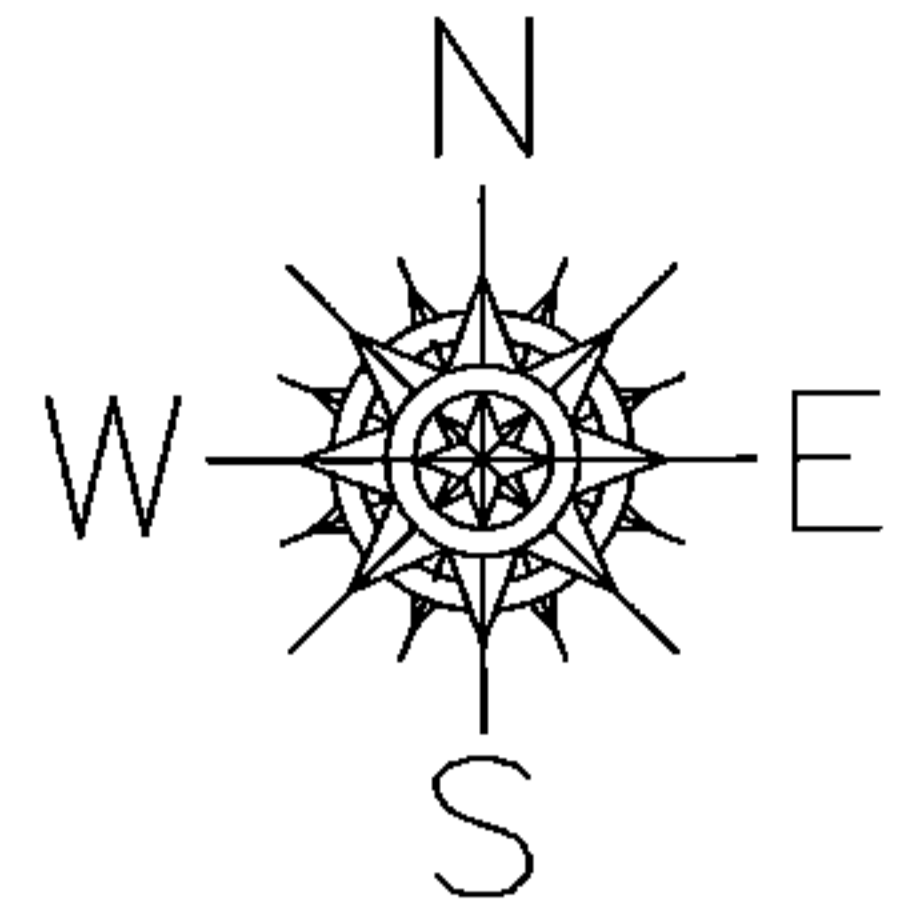

SPLITS/DEEDS PROCESSED

LORAIN COUNTY TAX MAP DEPARTMENT
226 MIDDLE AVE. ELYRIA, OHIO

SURVEYED BY: DANE HAPONEK

CLOSURE: 0.00 : 10,000

MAP PAGE(S): 7-A

APPROVED BY: JAH DATE: 3-12-2015

SCALE: 1"= 400 PRIOR INST.: 20150530705