

PARENT PARCEL: 07-00-032-000-041, -049




CHILD PARCEL: 07-00-032-000-672

STARTING POINT: CENTERLINE OF BARRES RD & STONEY RIDGE RD

15-03353

BARRES RD

STONEY RIDGE

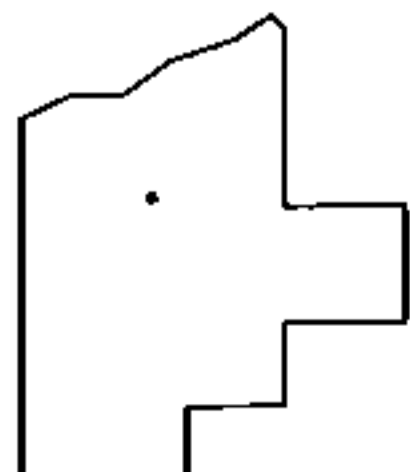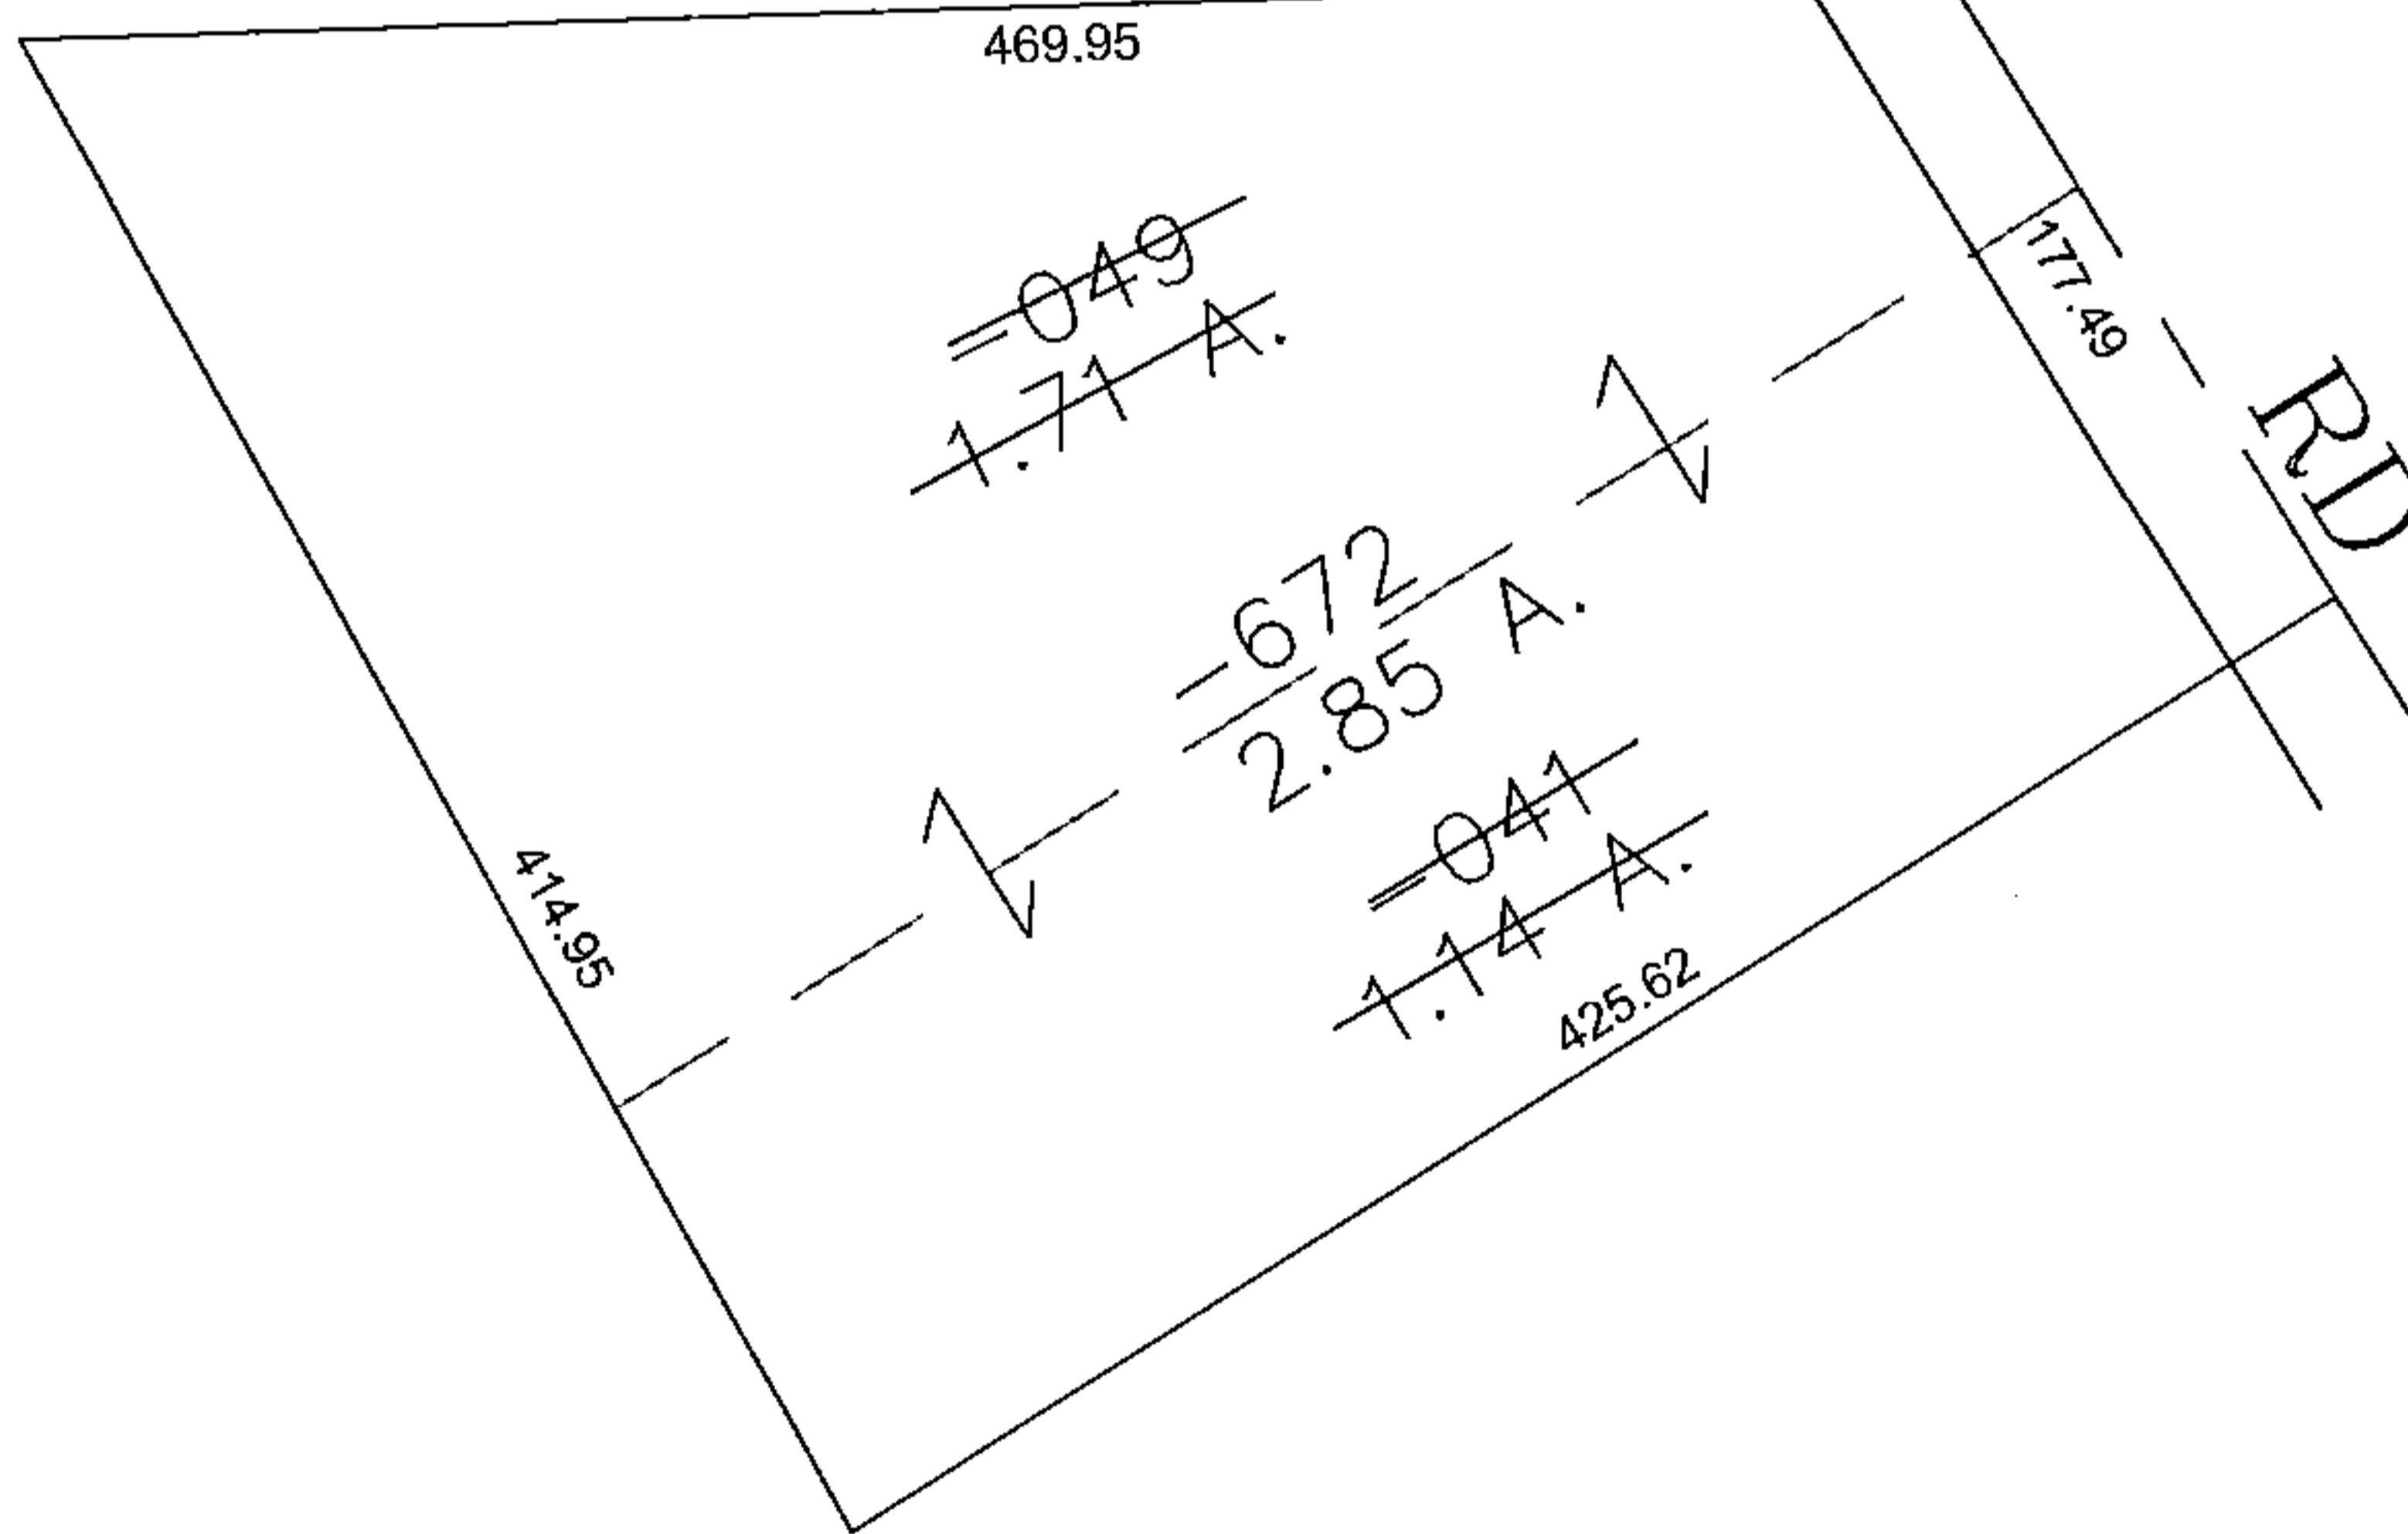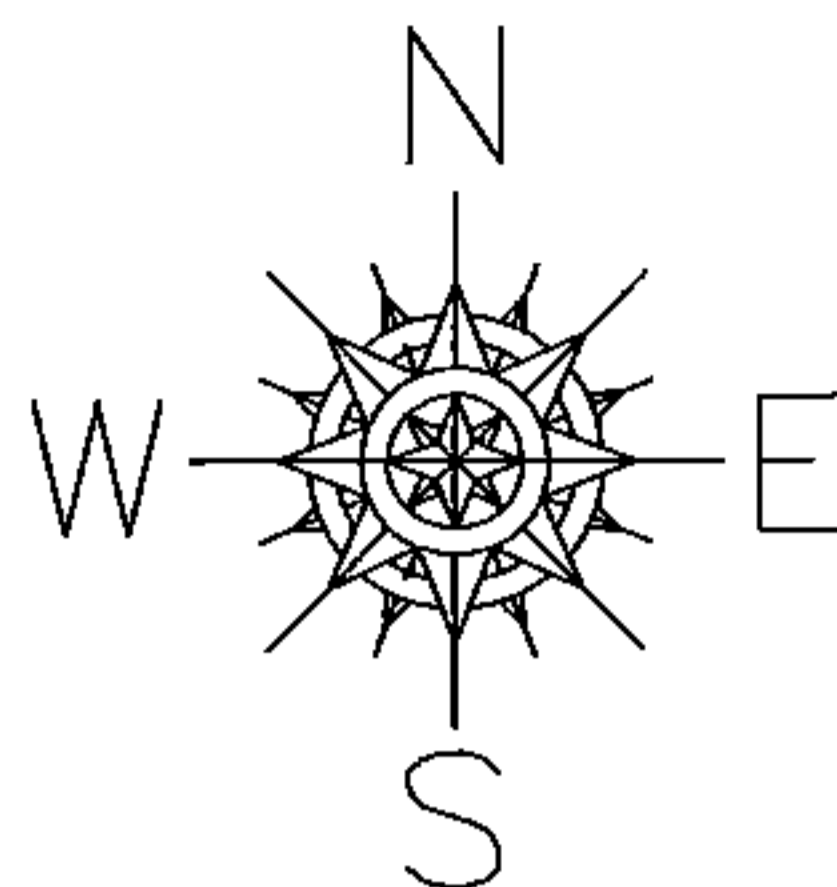

SPLITS/DEEDS PROCESSED

LORAIN COUNTY TAX MAP DEPARTMENT  
226 MIDDLE AVE. ELYRIA, OHIO

SURVEYED BY: HOWARD SEELEY

CLOSURE: 0.00 : 10.000

MAP PAGE(S): 07-00-032-D

APPROVED BY: JAH DATE: 3-12-2015

SCALE: 1" = 100 PRIOR INSTRUMENT: 20140527687