
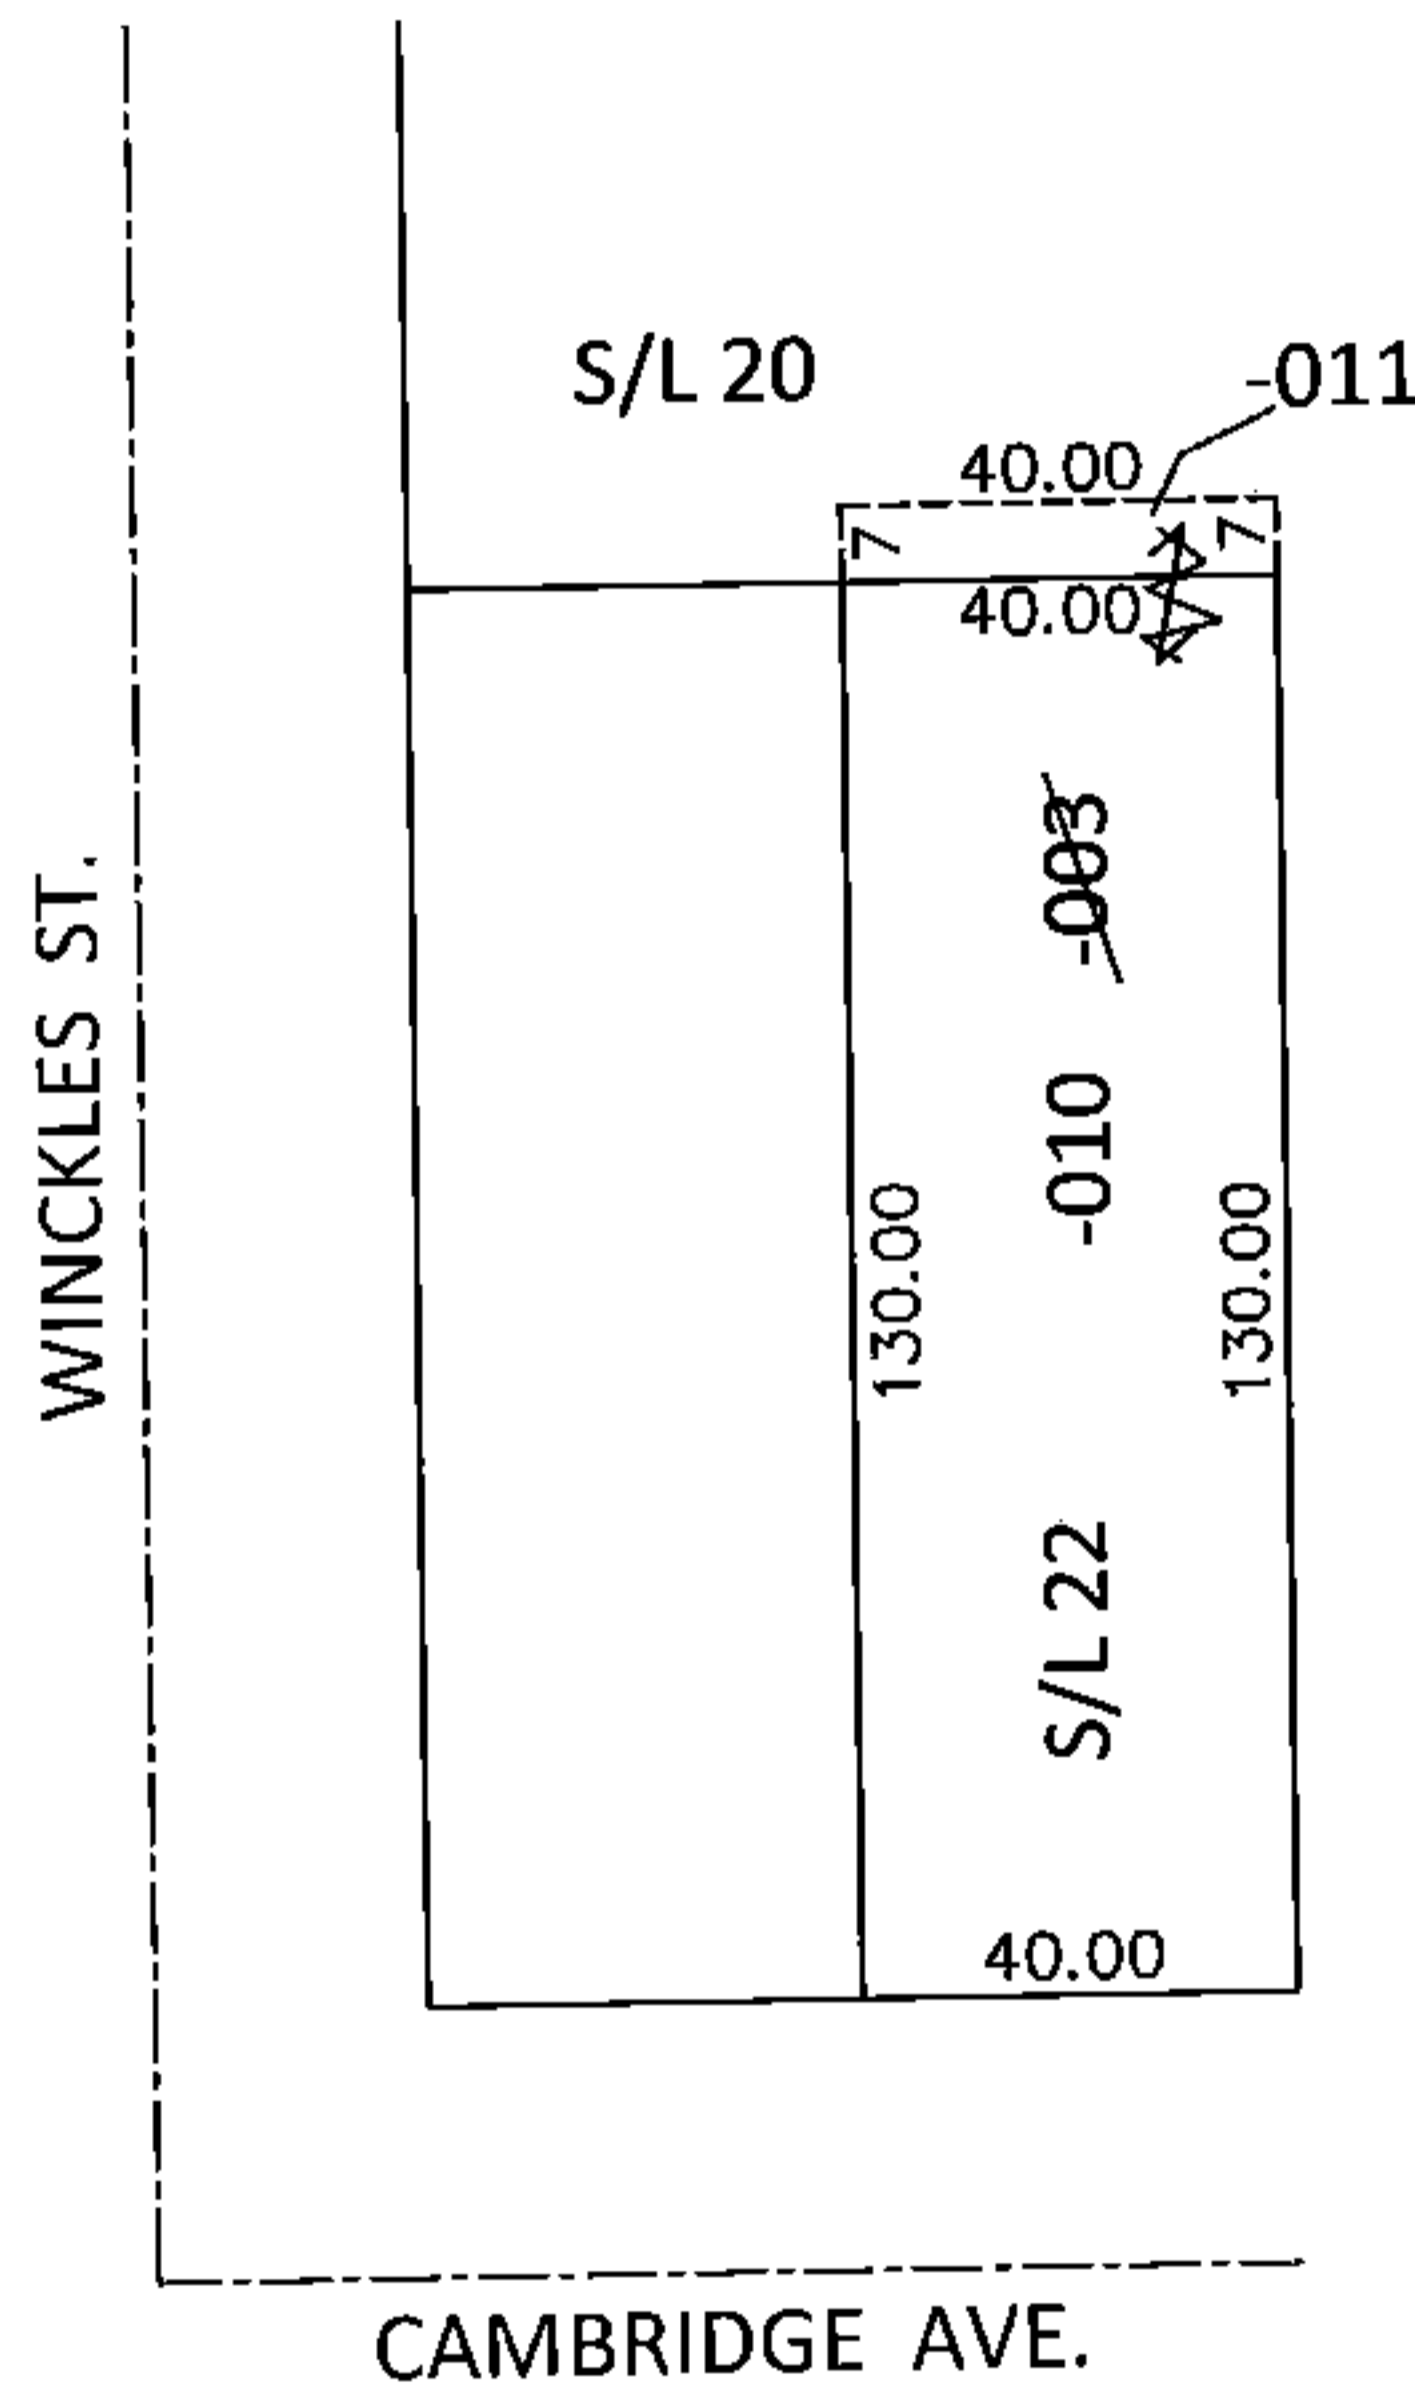


PARENT PARCEL: 06-25-006-102-003

CHILD PARCEL: 06-25-006-102-010, -011

STARTING POINT:

16-03354-U

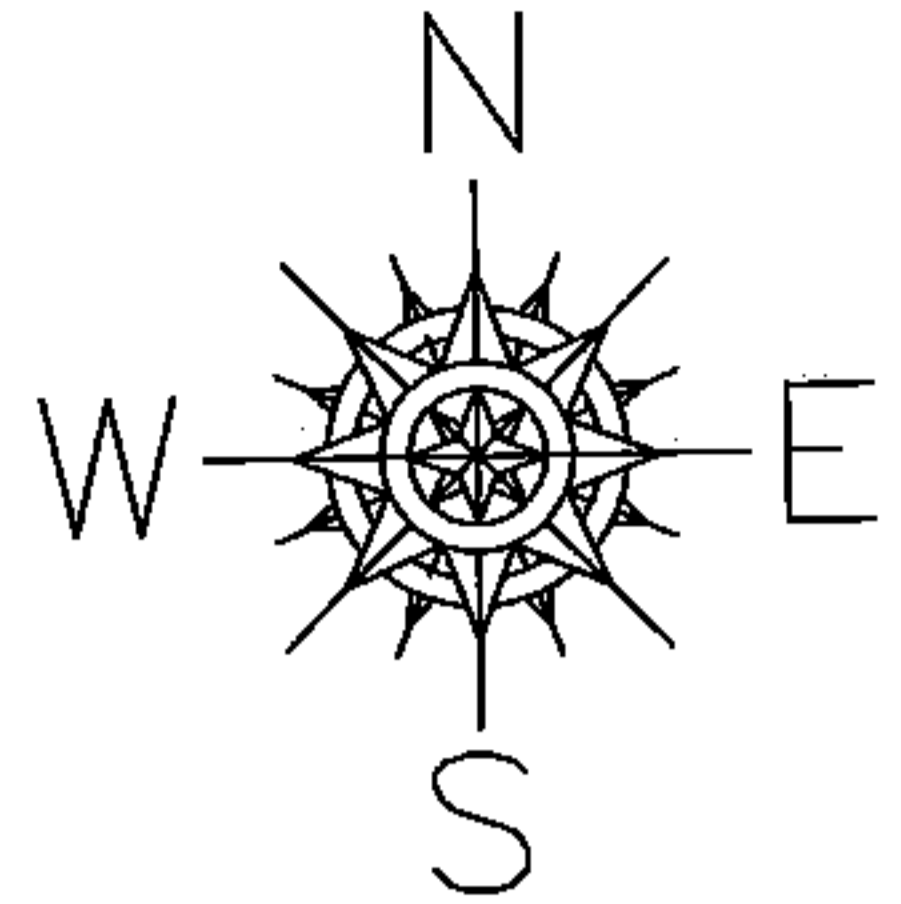


UNCOMBINATION

~~06-25-006-102-003~~
~~40 X 137~~

06-25-006-102-010
40 X 130

06-25-006-102-011
7 X 40

PER PRIOR DEEDS

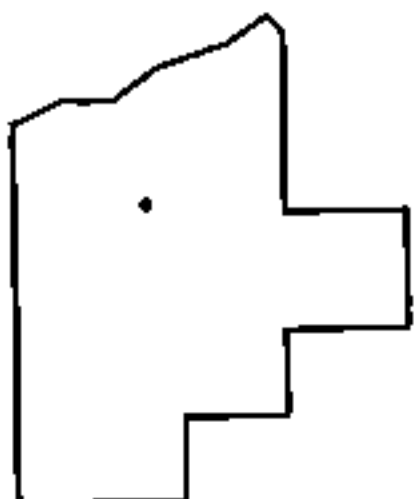

SPLITS/DEEDS PROCESSED

LORAIN COUNTY TAX MAP DEPARTMENT
226 MIDDLE AVE. ELYRIA, OHIO

SURVEYED BY: N/A

CLOSURE: N/A

MAP PAGE(S): 6-123

APPROVED BY: RRM DATE: 1-5-16

SCALE: 1"= 50' PRIOR INST.: 20060129000