
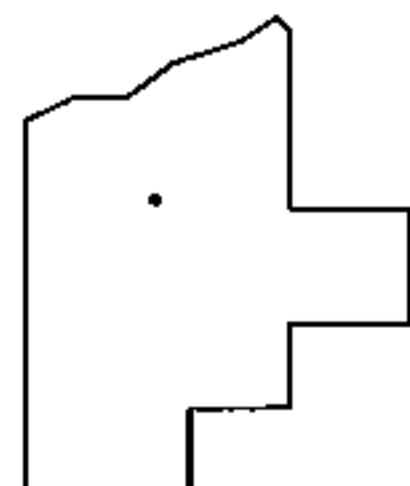
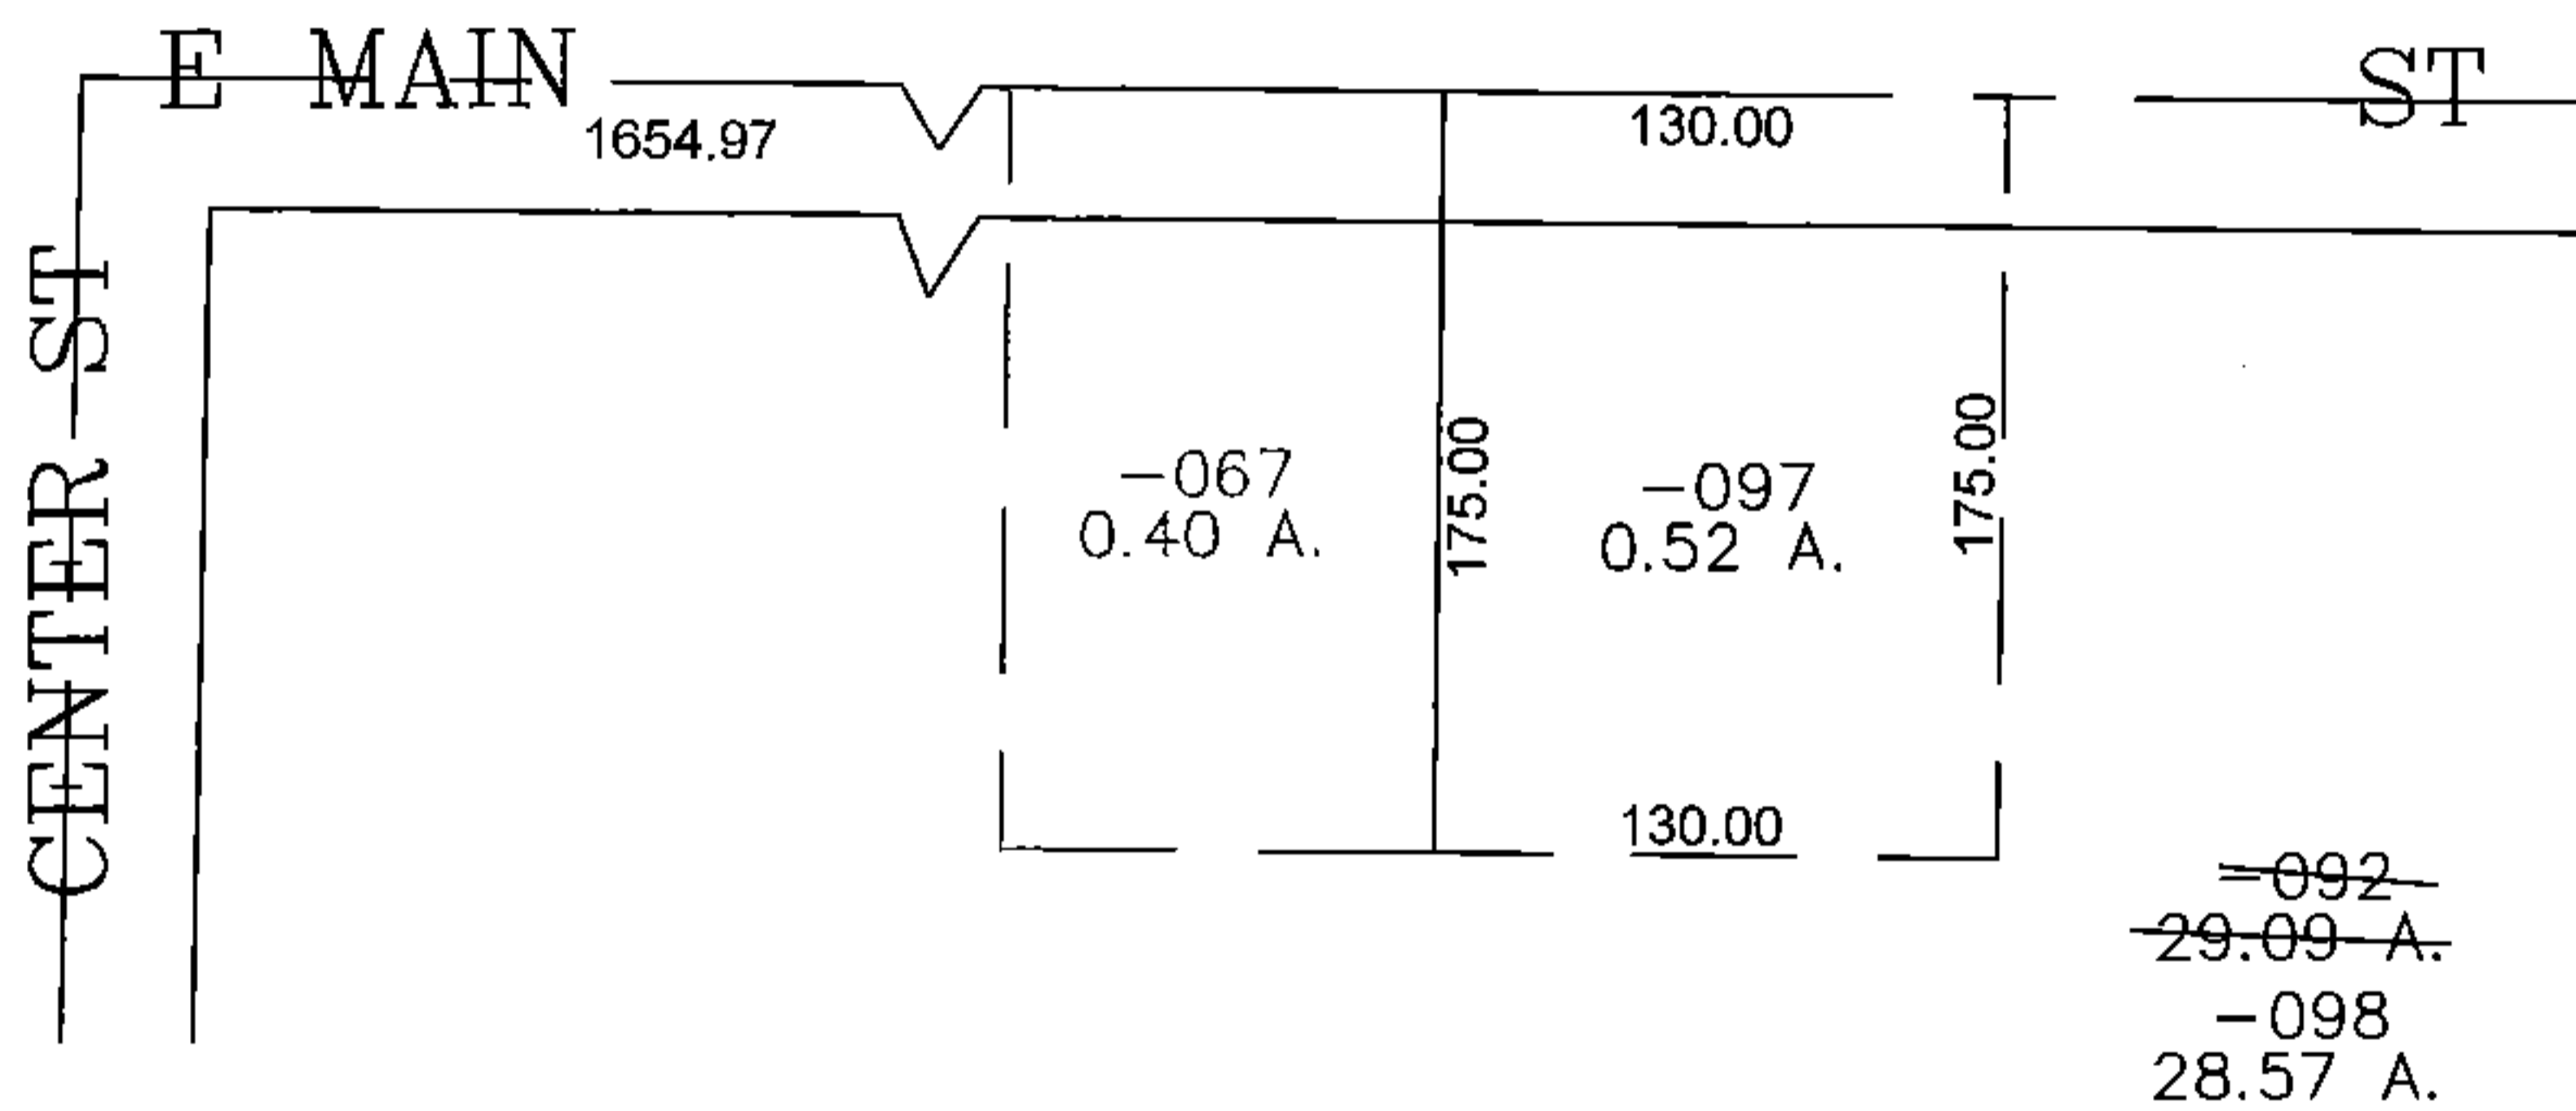


PARENT PARCEL: 15-00-055-104-092

CHILD PARCEL: 15-00-055-104-097, -098

STARTING POINT: CENTERLINE OF CENTER ST & E MAIN ST

15-03354

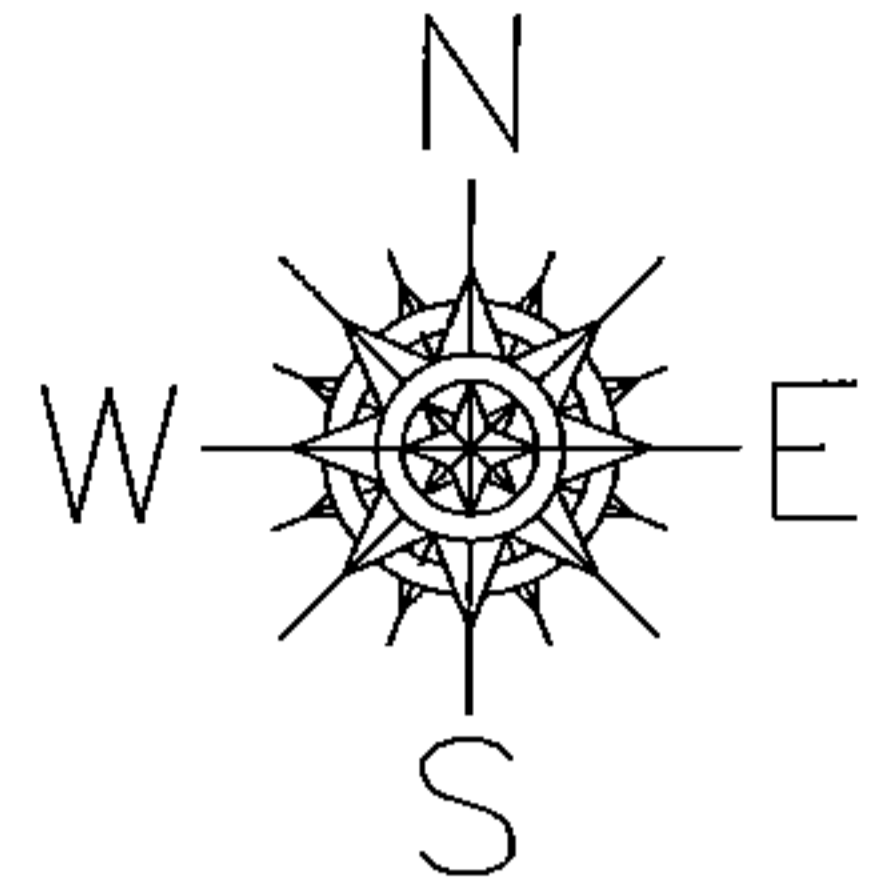

SPLITS/DEEDS PROCESSED

LORAIN COUNTY TAX MAP DEPARTMENT
226 MIDDLE AVE. ELYRIA, OHIO

SURVEYED BY: THOMAS SIMON
 CLOSURE: 0.00 : 10.000
 MAP PAGE(S): 15-00-055-A
 APPROVED BY: JAH DATE: 3/13/2015
 SCALE: 1" = 100 PRIOR INSTRUMENT: 20060139598