
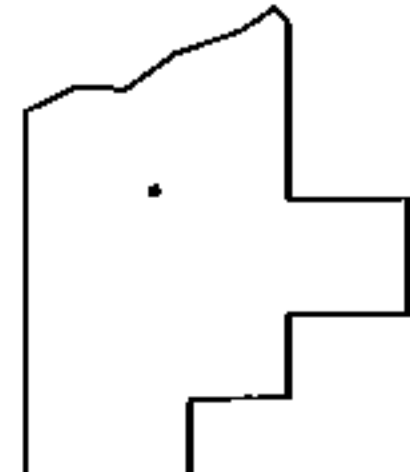
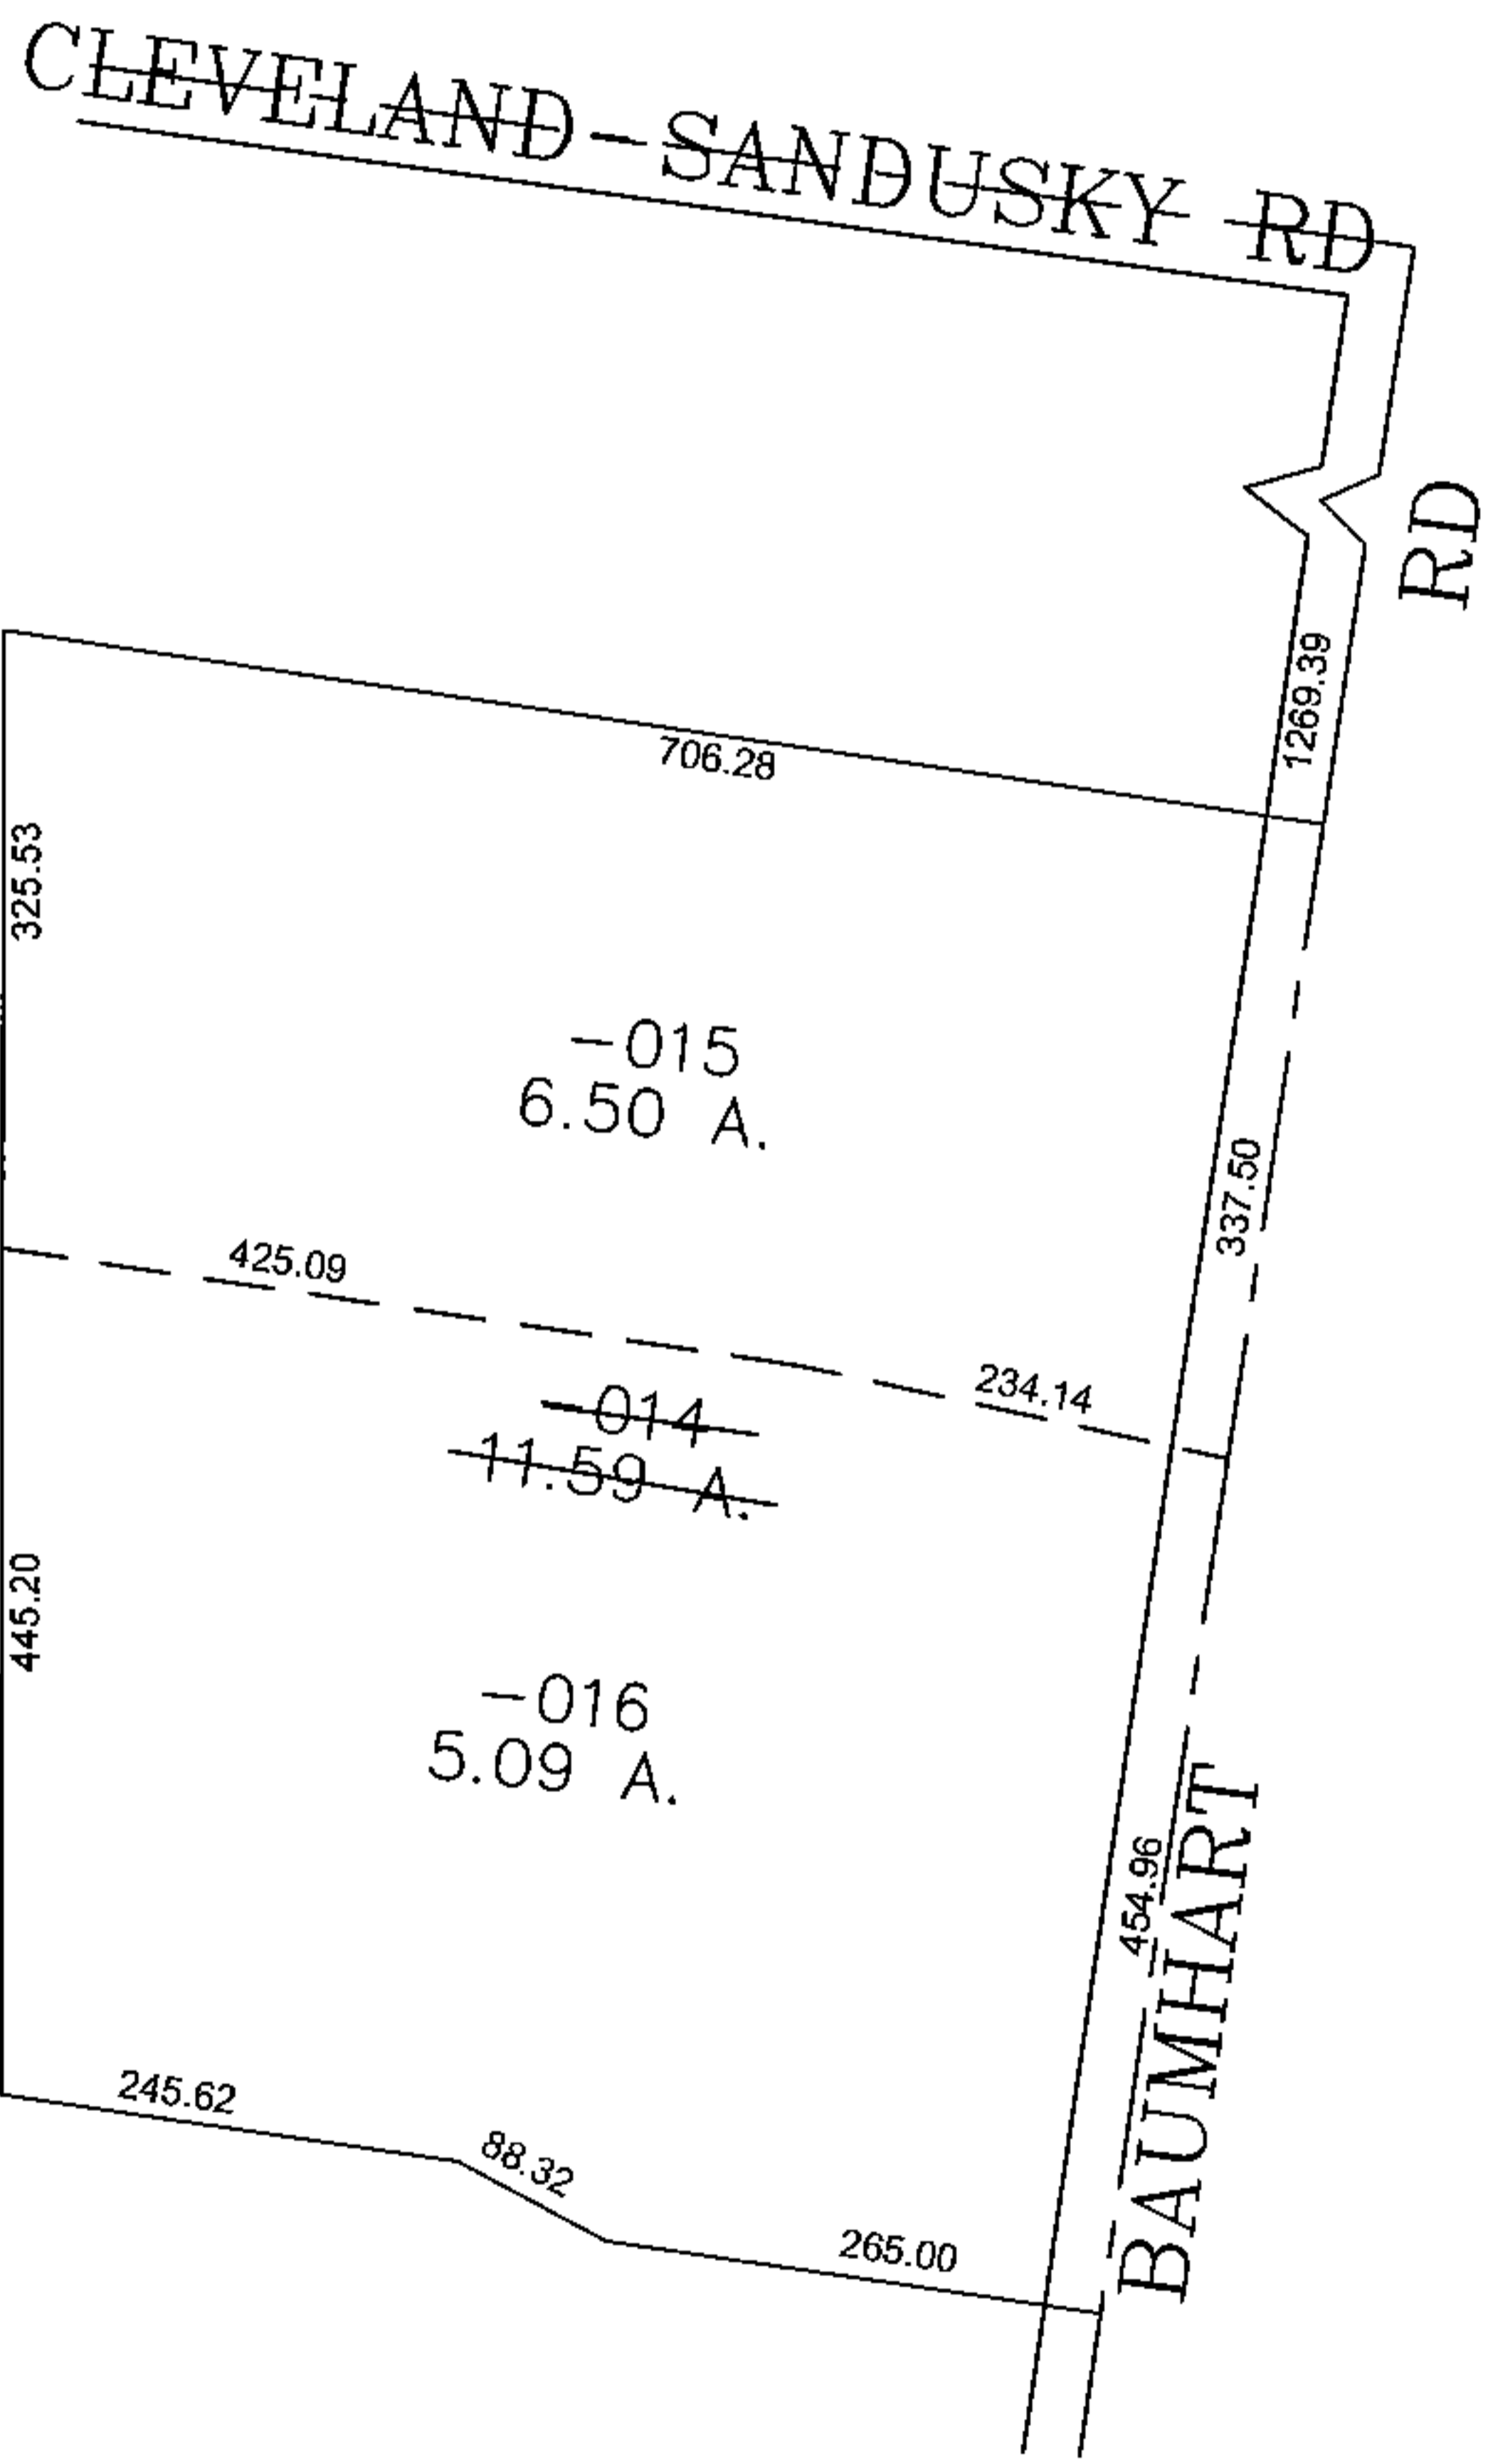


PARENT PARCEL: 01-00-007-102-014

CHILD PARCEL: 01-00-007-102-015, -016

STARTING POINT: CENTERLINE OF CLEVELAND-SANDUSKY RD & BAUMHART RD

15-03355

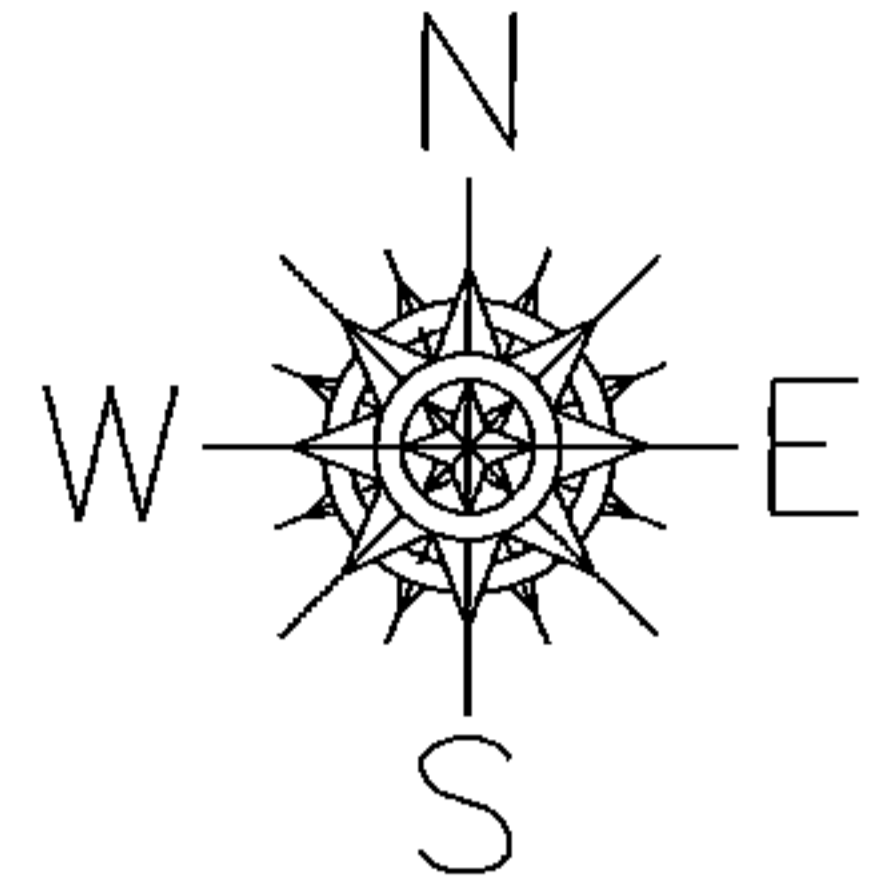

SPLITS/DEEDS PROCESSED
 LORAIN COUNTY TAX MAP DEPARTMENT
 226 MIDDLE AVE. ELYRIA, OHIO

SURVEYED BY: DONALD SHEEHY
 CLOSURE: 0.00 : 10.000
 MAP PAGE(S): 01-00-007-A
 APPROVED BY: JAH DATE: 3/13/2015
 SCALE: 1" = 200 PRIOR INSTRUMENT: 20130472619