

PARENT PARCEL: 06-24-061-101-005

CHILD PARCEL: ADD TO DUP.

STARTING POINT: XXXXXX


16-03357-C

ADD TO DUPLICATE

06-24-062-900-001

0.70 A. CALC.

PER DV. 97 PG. 500

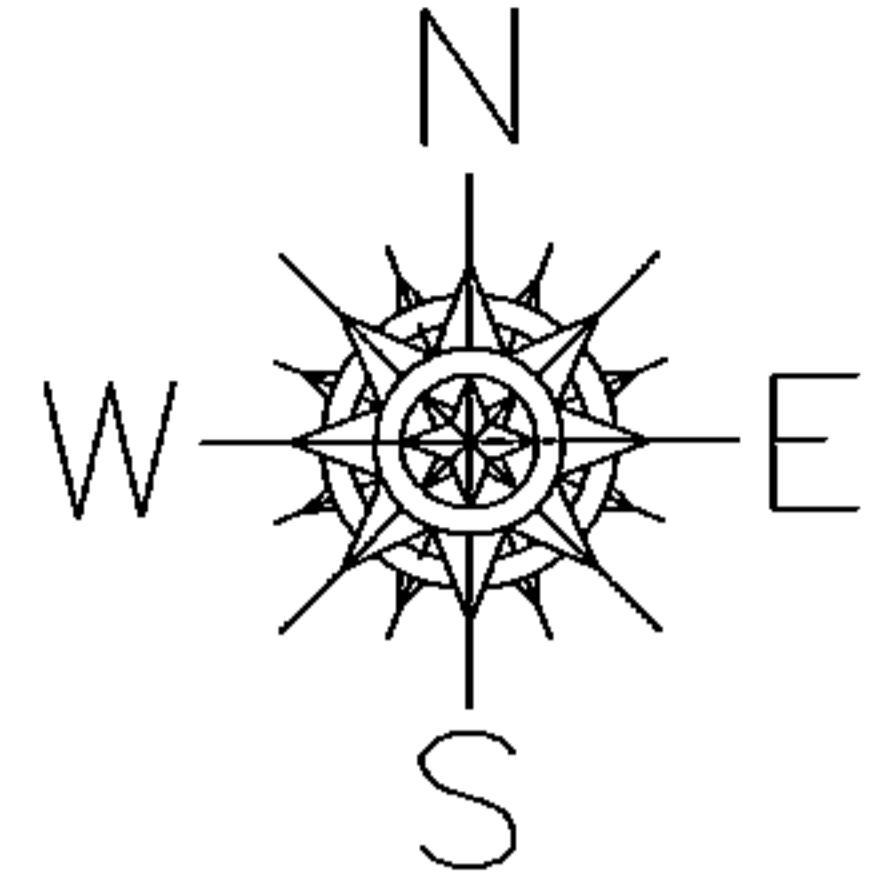

FRONTAGE & DEPTH CORR.



06-24-061-101-005

~~44 X ?~~

44 X 120.71

CORR. PER SURV.

T. SIMON

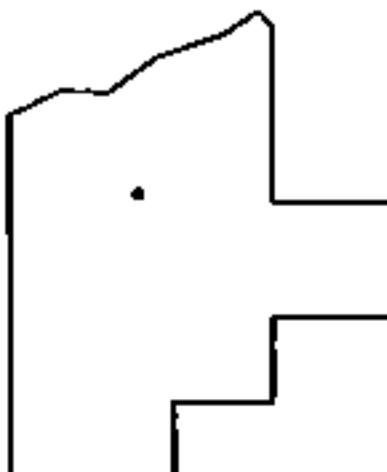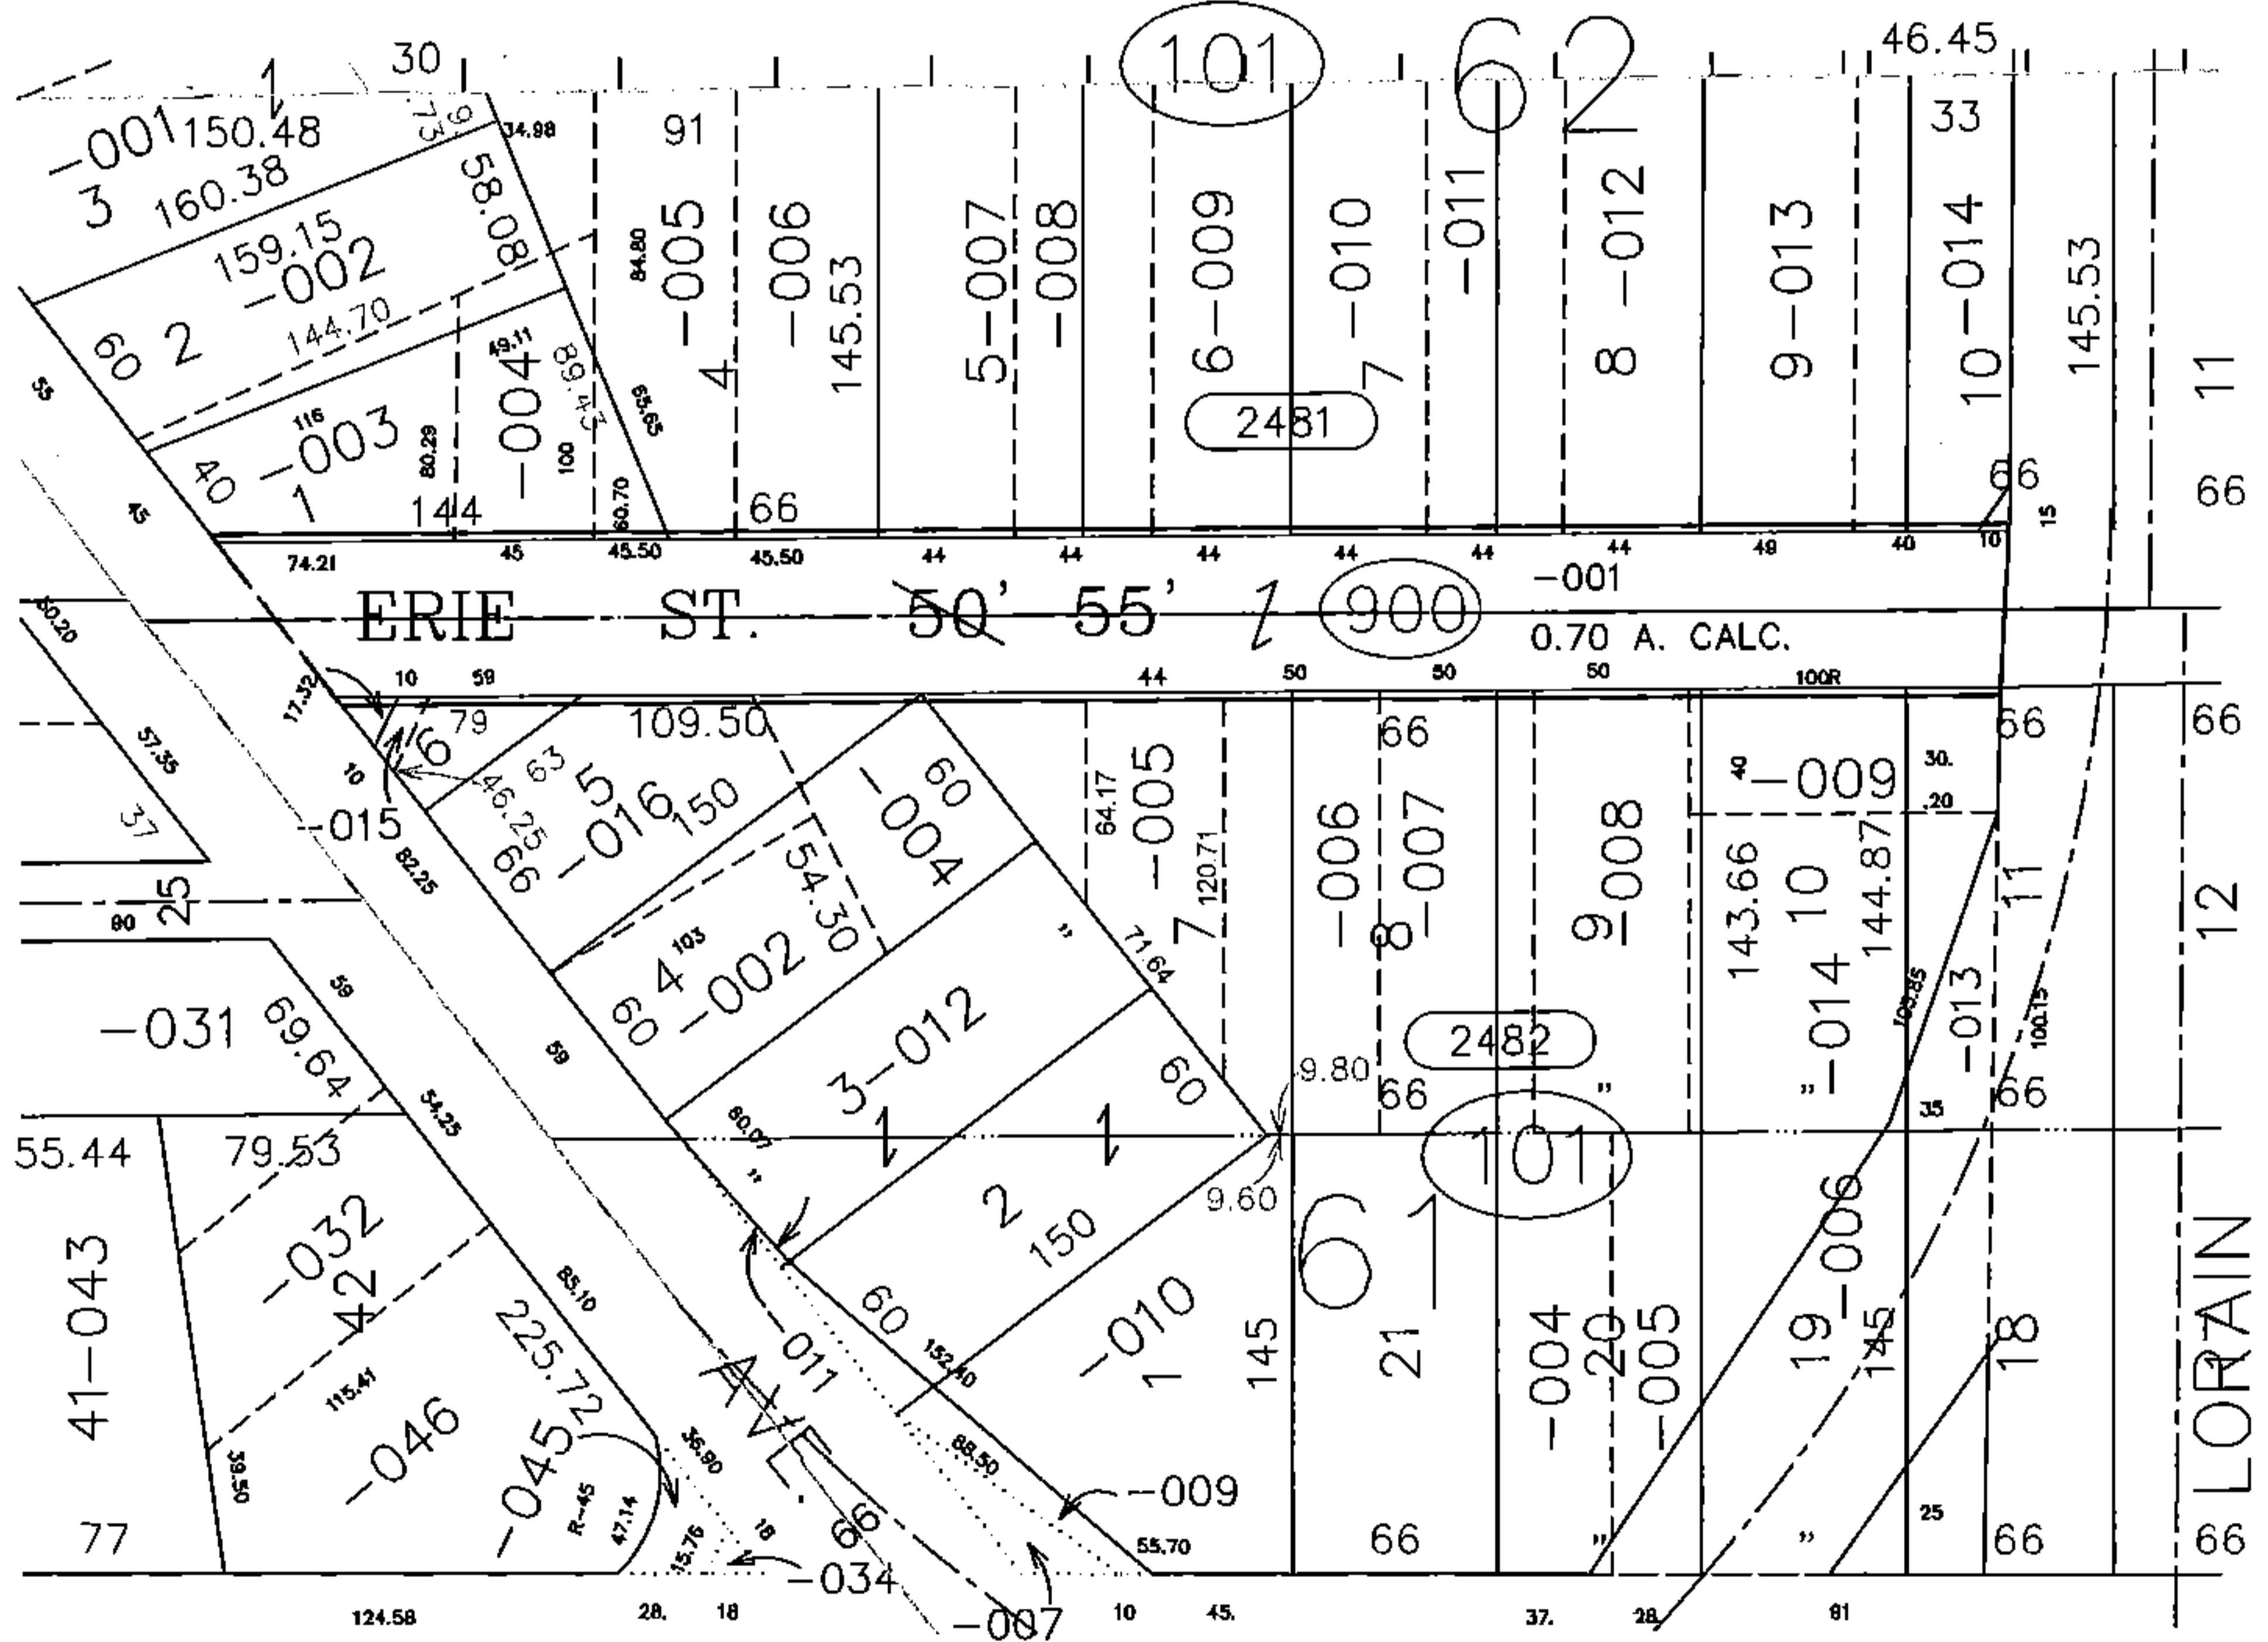

SPLITS/DEEDS PROCESSED

LORAIN COUNTY TAX MAP DEPARTMENT  
226 MIDDLE AVE. ELYRIA, OHIO

SURVEYED BY: T. SIMON

CLOSURE: 0.01 : 10,000

MAP PAGE(S): 06-24-061

APPROVED BY: TJS DATE: 1/8/16

SCALE: 1" = 100 PRIOR INSTRUMENT: DV XXXX/XXX