
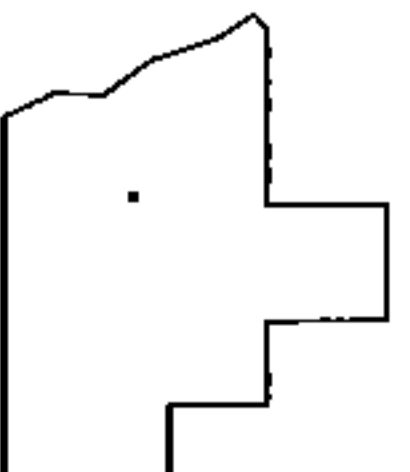
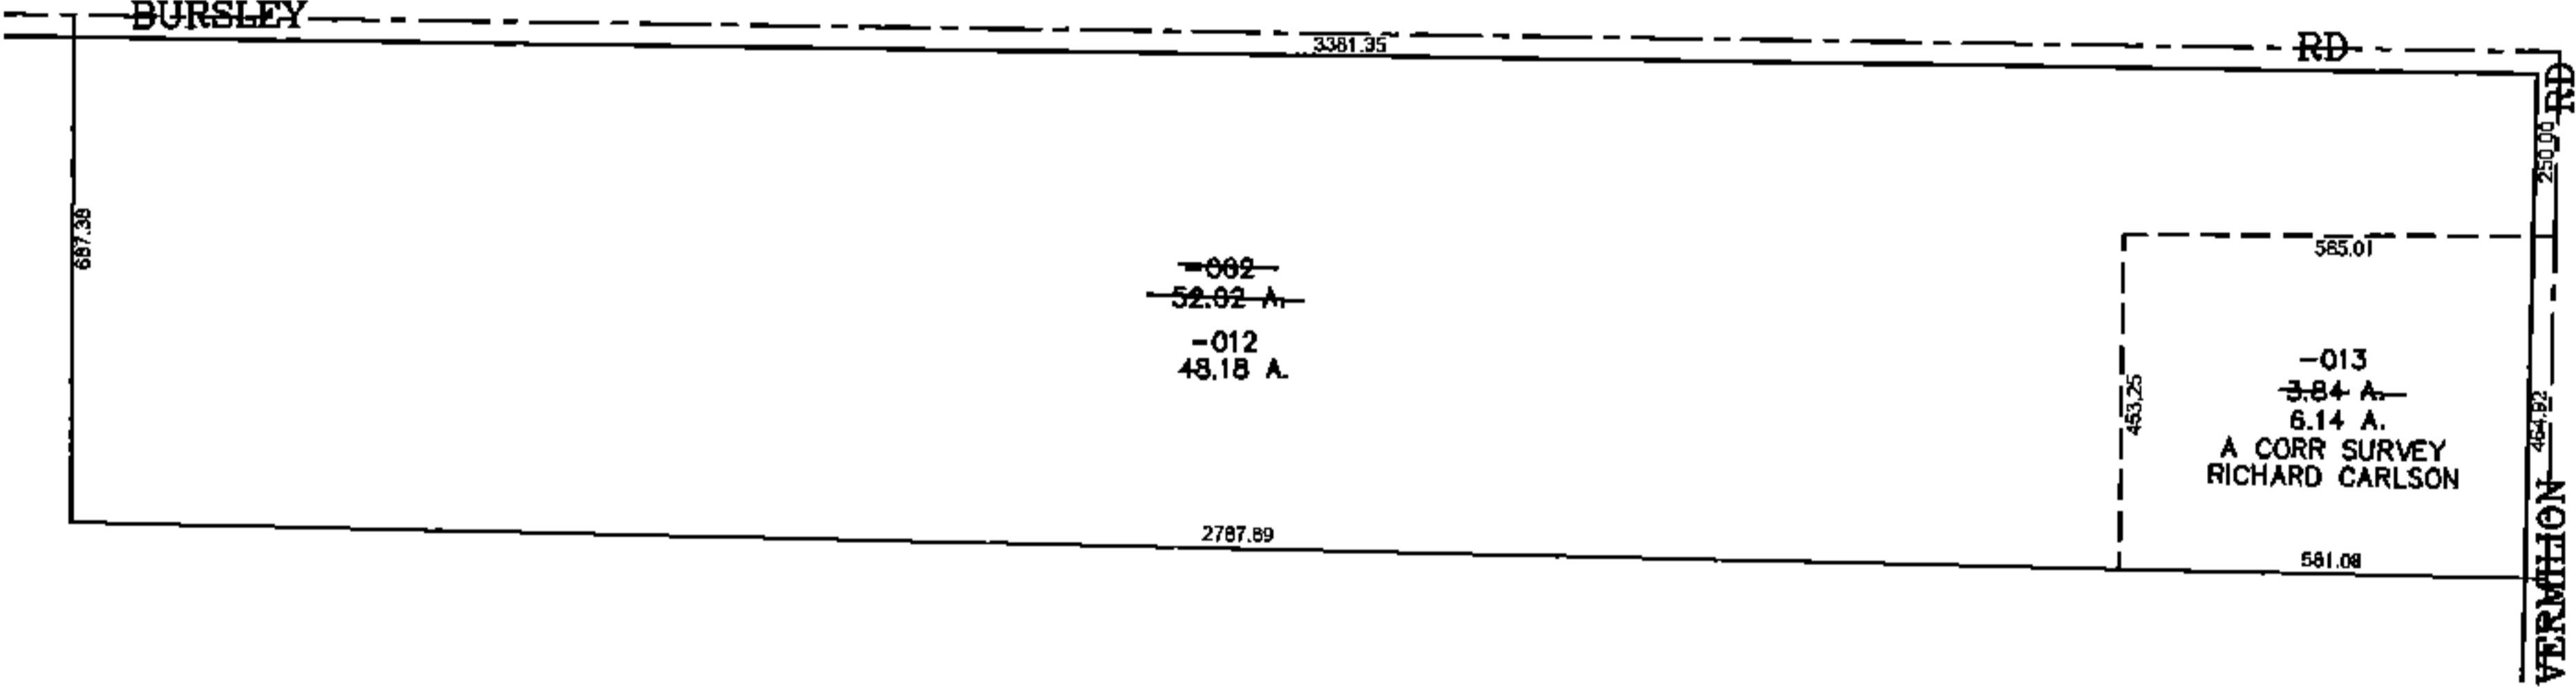


PARENT PARCEL: 20-05-021-000-002  
CHILD PARCEL: 20-05-021-000-012, -013  
STARTING POINT: CENTERLINE OF BURSLEY RD & VERMILION RD

**15-03357**

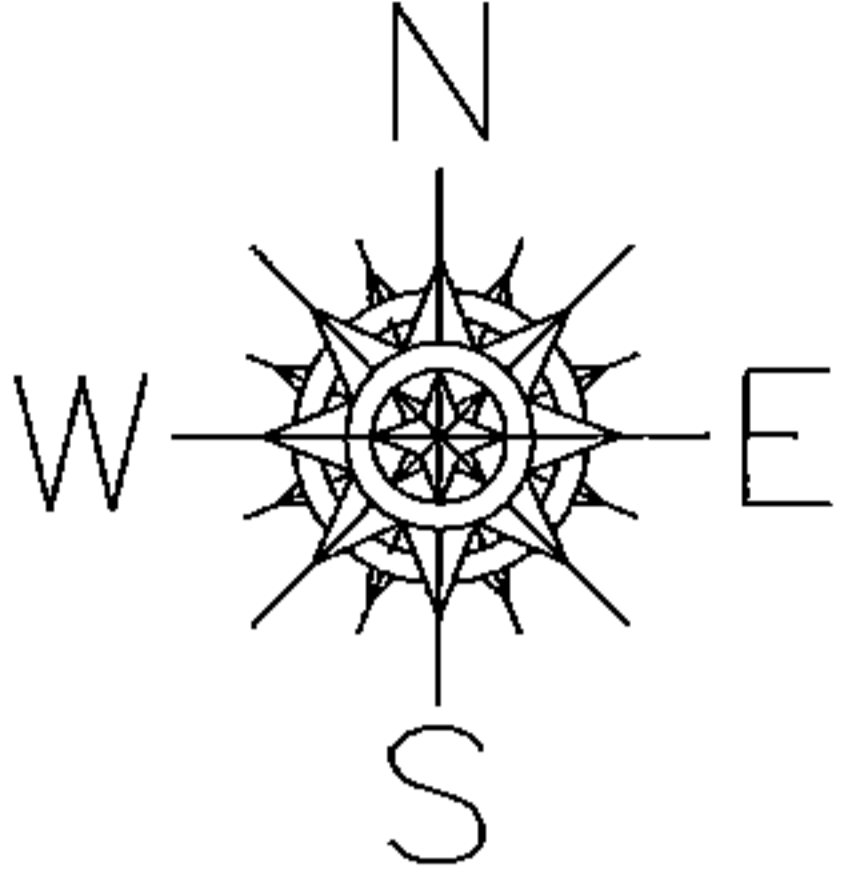

**SPLITS/DEEDS PROCESSED**  
LORAIN COUNTY TAX MAP DEPARTMENT  
226 MIDDLE AVE. ELYRIA, OHIO

SURVEYED BY: RICHARD CARLSON  
CLOSURE: 0.00 : 10,000  
MAP PAGE(S): 20-A  
APPROVED BY: JAH DATE: 3-19-2015  
SCALE: 1"= 500 PRIOR INST.: 20130457725