
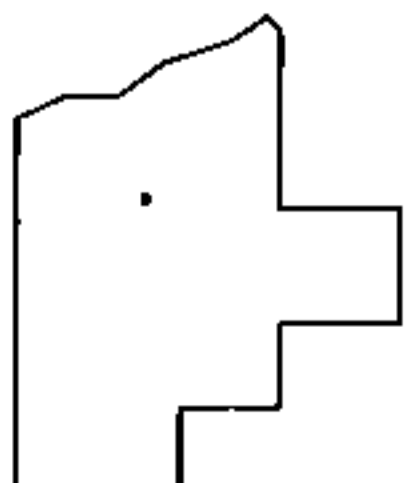
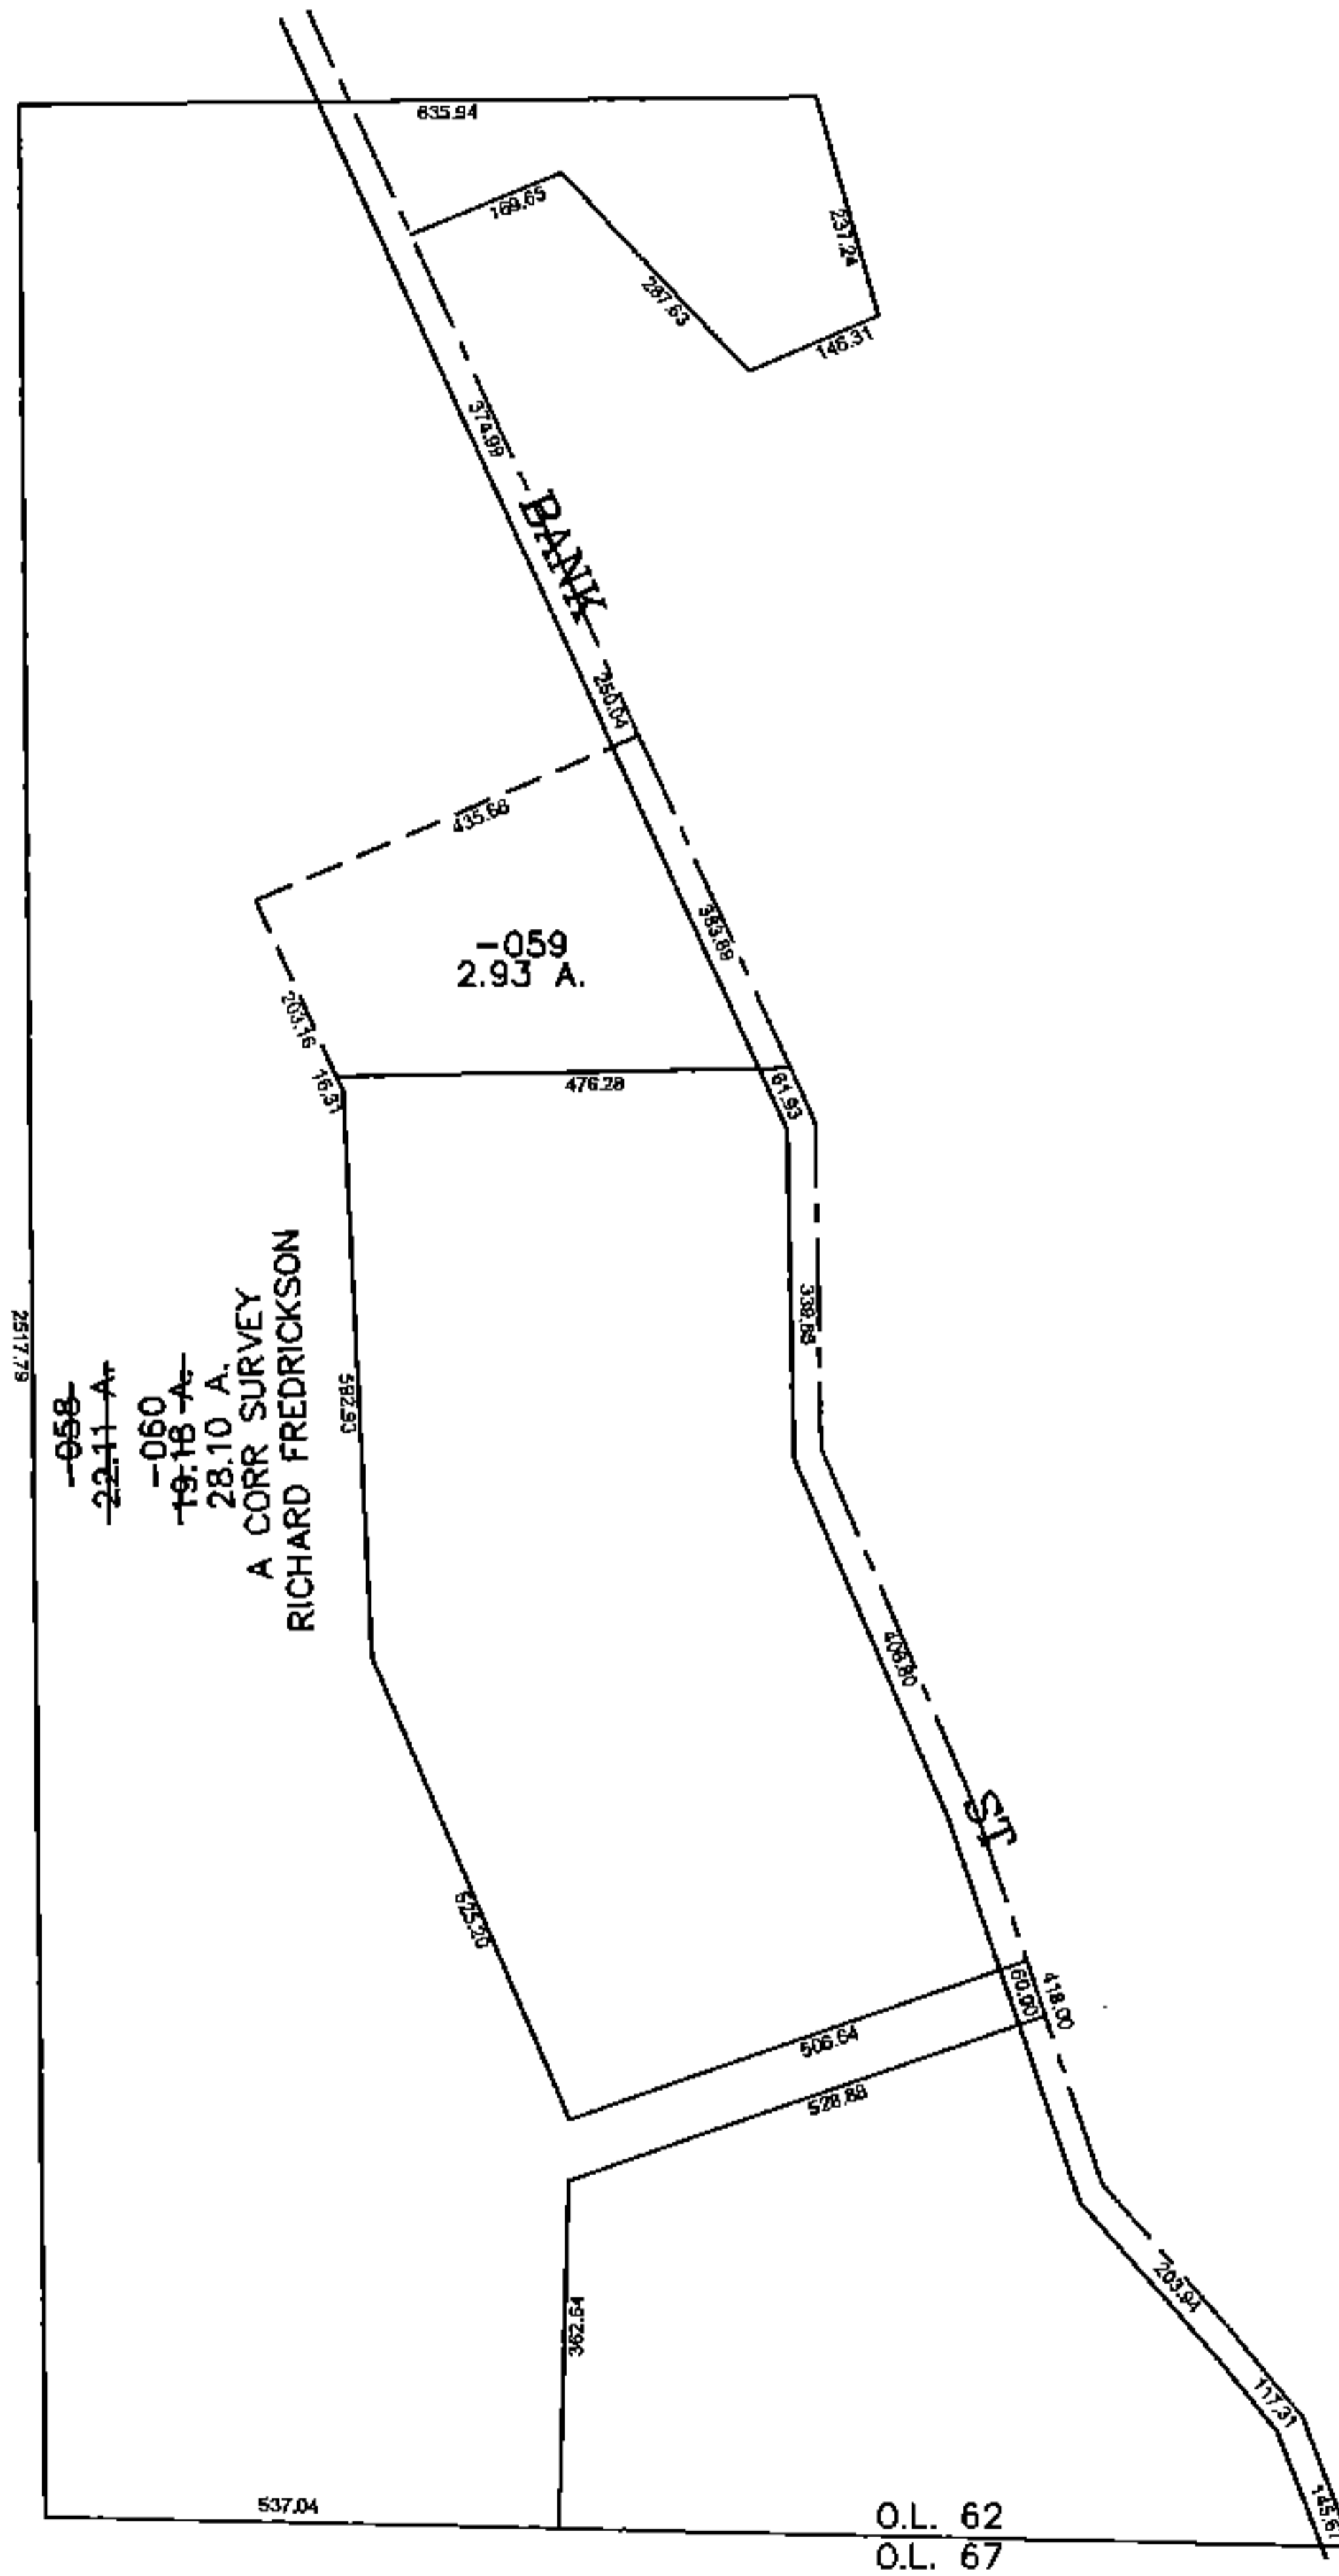


PARENT PARCEL: 01-00-062-000-058

CHILD PARCEL: 01-00-062-000-059, -060

STARTING POINT: CENTERLINE OF BANK ST & O.L. 62

15-03358

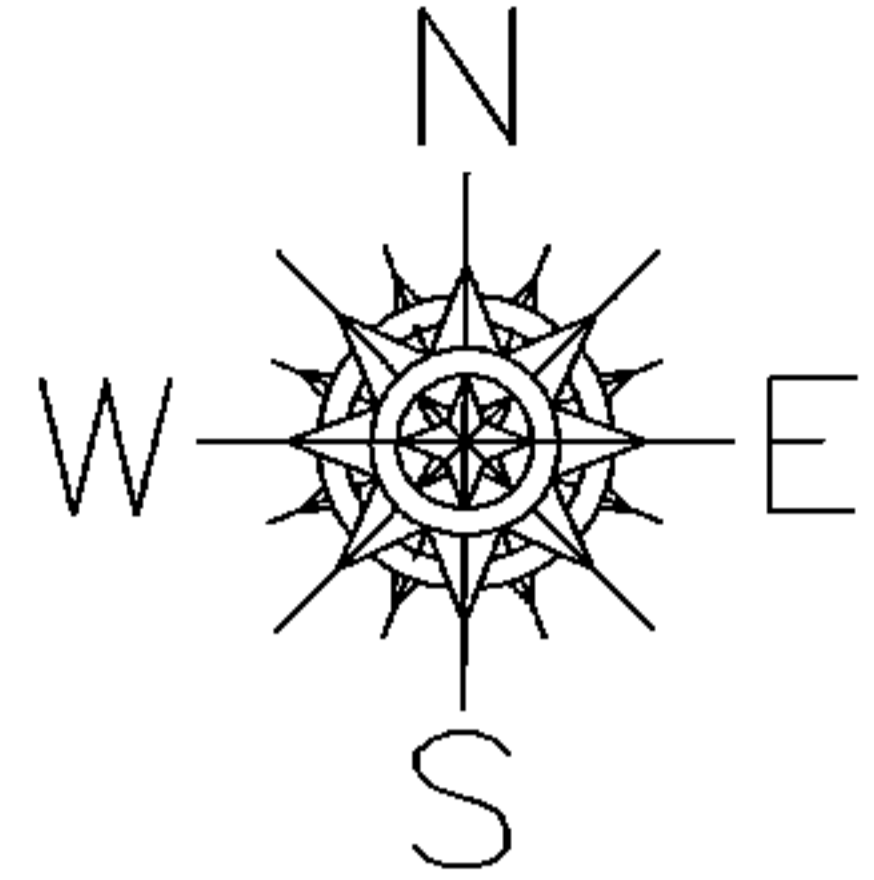

**SPLITS/DEEDS PROCESSED**

LORAIN COUNTY TAX MAP DEPARTMENT  
226 MIDDLE AVE. ELYRIA, OHIO

SURVEYED BY: RICHARD FREDRICKSON

CLOSURE: 0.00 : 10,000

MAP PAGE(S): 01-00-062-A

APPROVED BY: JAH DATE: 3/27/2015

SCALE: 1" = 400 PRIOR INST.: 20060171394