
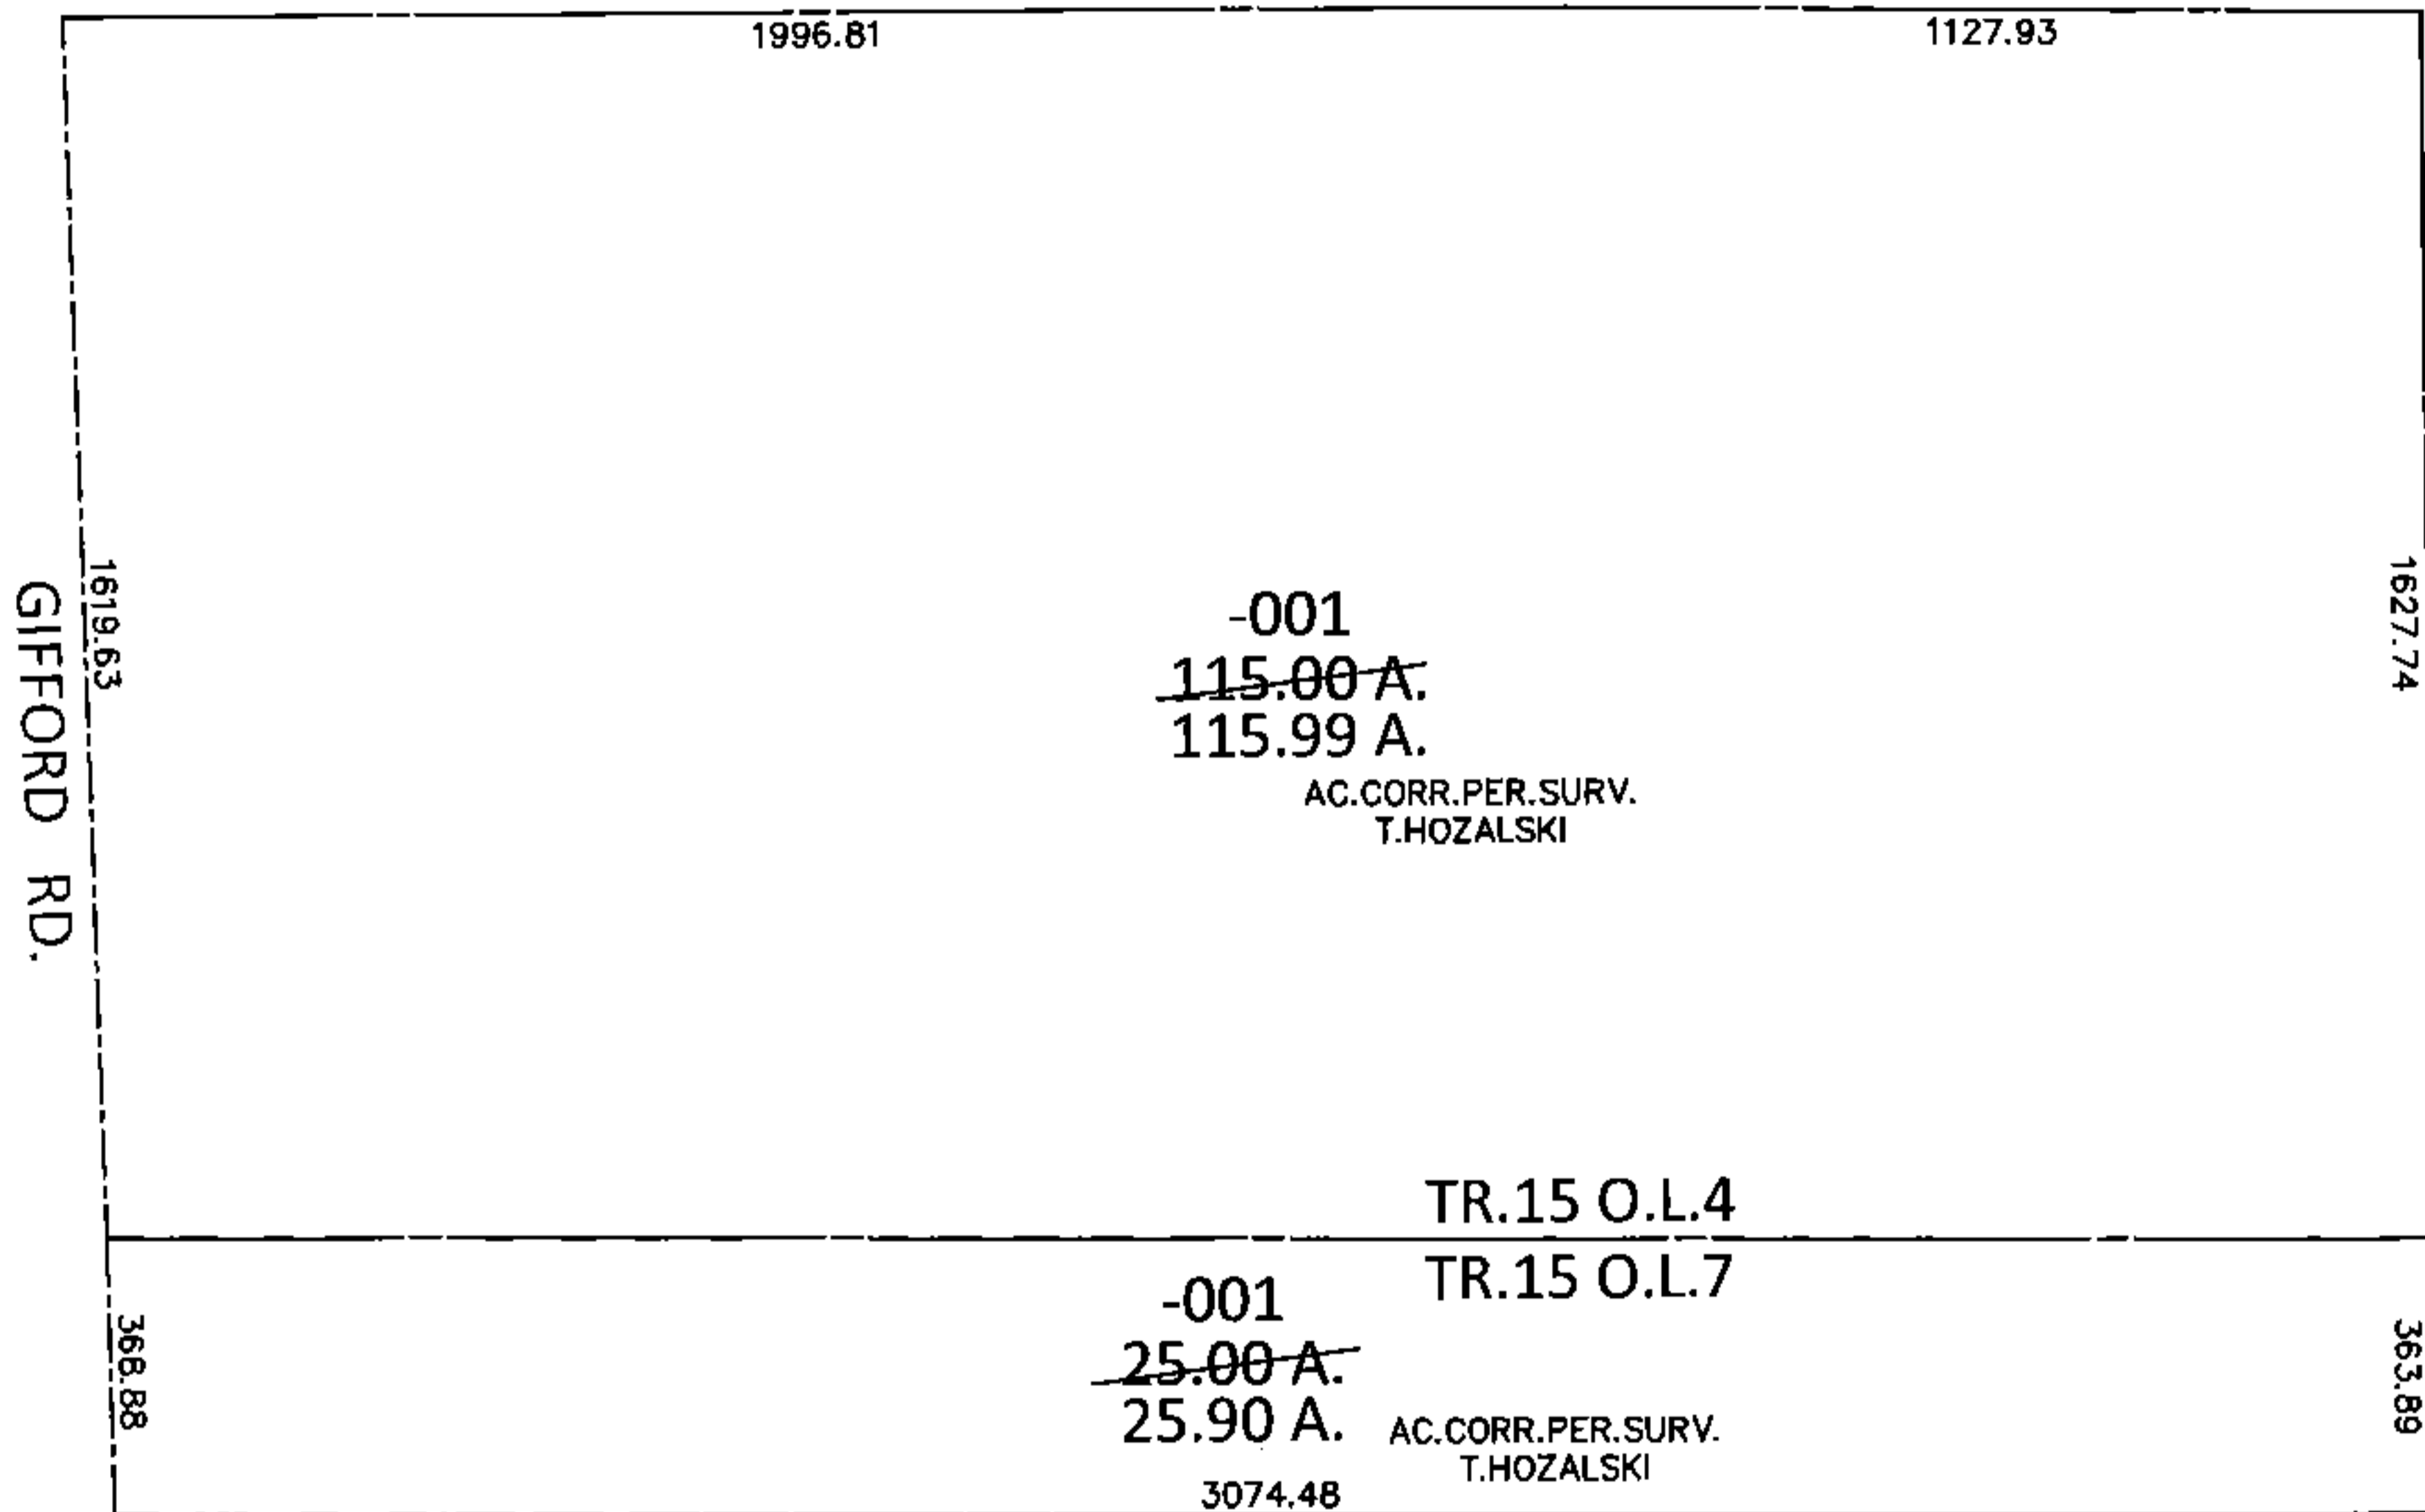


PARENT PARCEL: 08-15-004-000-001, 08-15-007-000-001


CHILD PARCEL: \_\_\_\_\_

STARTING POINT: NORTHWEST CORNER OF TR.15 O.L.4

**16-03360-A**

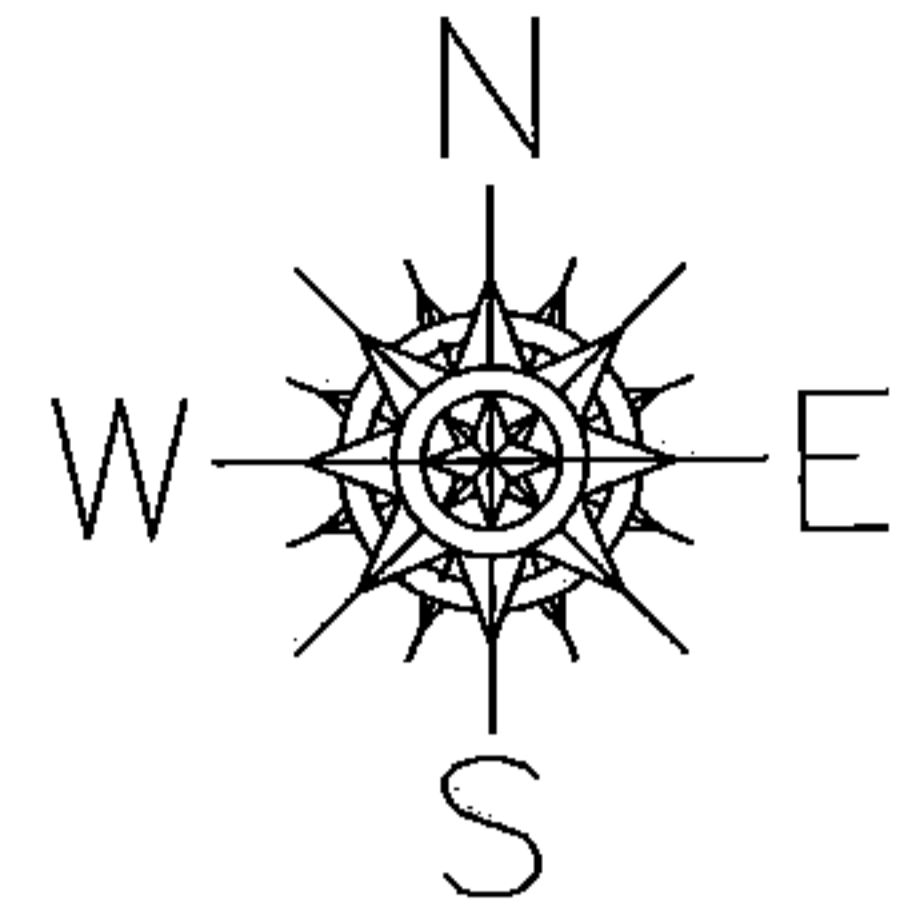

MAP 1 OF 3

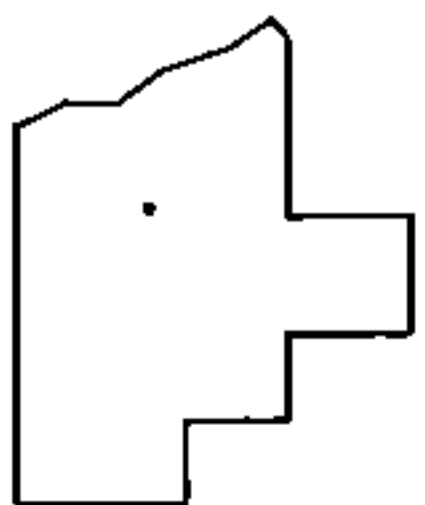

**SPLITS/DEEDS PROCESSED**

LORAIN COUNTY TAX MAP DEPARTMENT  
226 MIDDLE AVE. ELYRIA, OHIO

SURVEYED BY: TIMOTHY D. HOZALSKI

CLOSURE: .01:10,000

MAP PAGE(S): 8-D

APPROVED BY: RRM DATE: 1-13-16

SCALE: 1"= 500 PRIOR INST.: 19980542909