
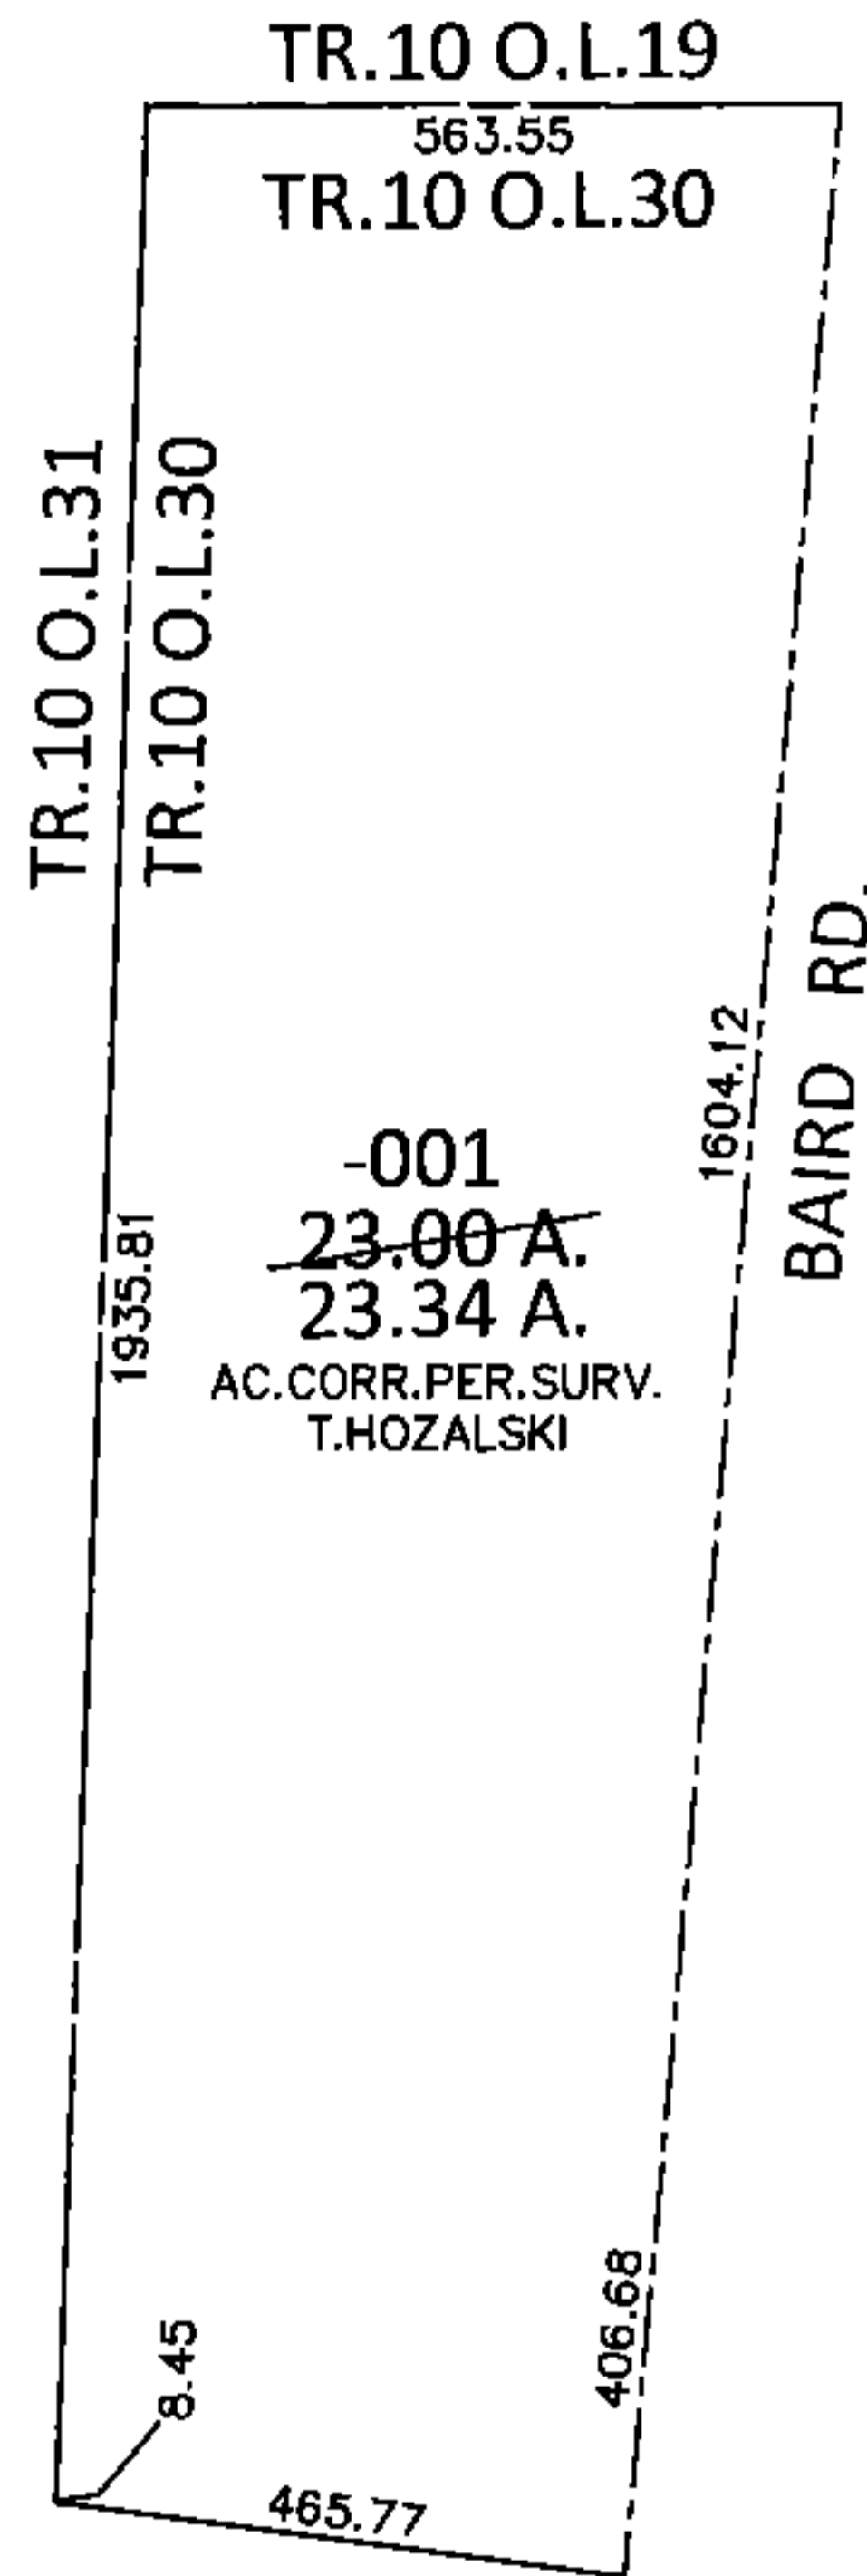


PARENT PARCEL: 13-10-030-000-001


CHILD PARCEL: _____

STARTING POINT: INTERSECTION OF C/L OF BAIRD RD. AND NORTH LINE OF TR.10 O.L.30

16-03360-A

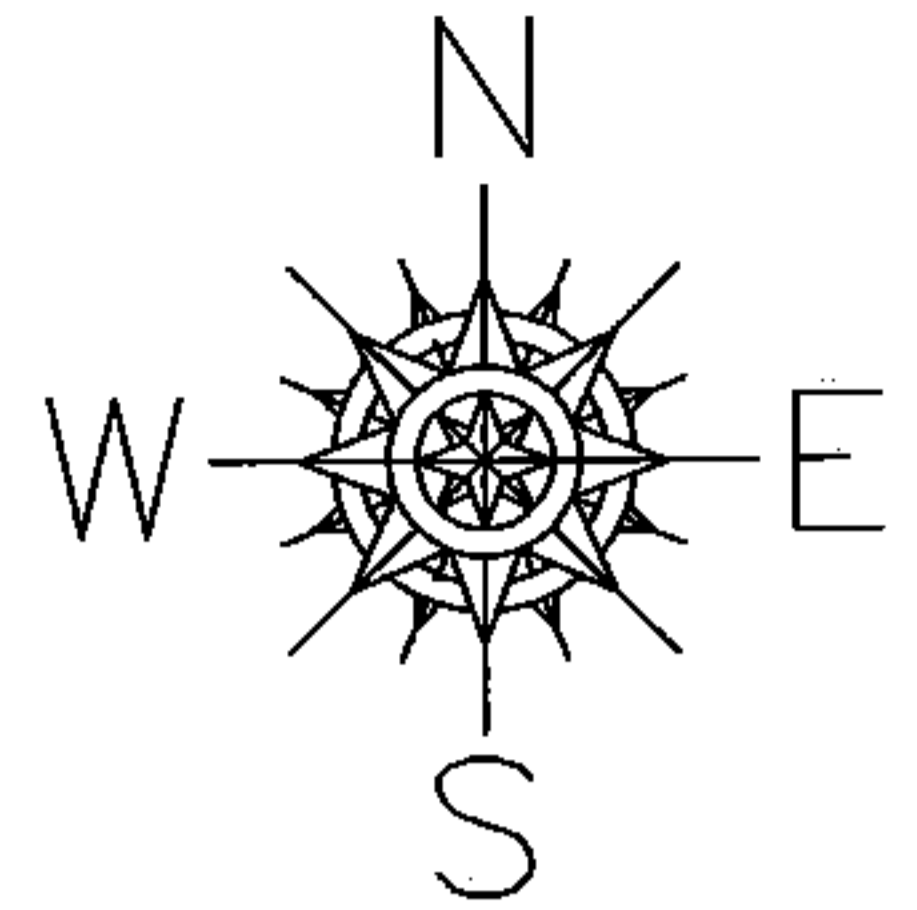

MAP 3 OF 3

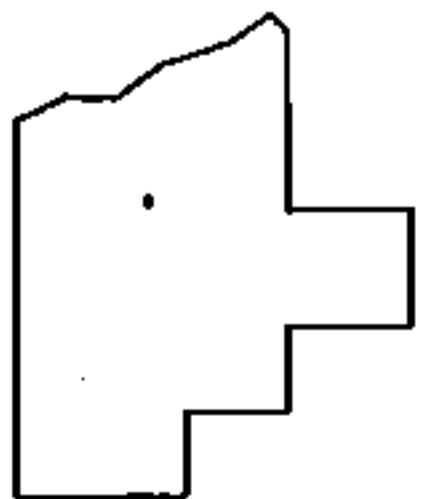

SPLITS/DEEDS PROCESSED

LORAIN COUNTY TAX MAP DEPARTMENT
226 MIDDLE AVE. ELYRIA, OHIO

SURVEYED BY: TIMOTHY D. HOZALSKI

CLOSURE: .01:10,000

MAP PAGE(S): 13-B

APPROVED BY: RRM DATE: 1-13-16

SCALE: 1"=400 PRIOR INST.: 20090281827