


PARENT PARCEL: 12-00-033-000-054
CHILD PARCEL: XX-XX-XXX-XXX-XXX
STARTING POINT: CL OF EAST RIVER RD. & S.W. CORNER OF GRICAR IN DV 998/281

16-03361-C

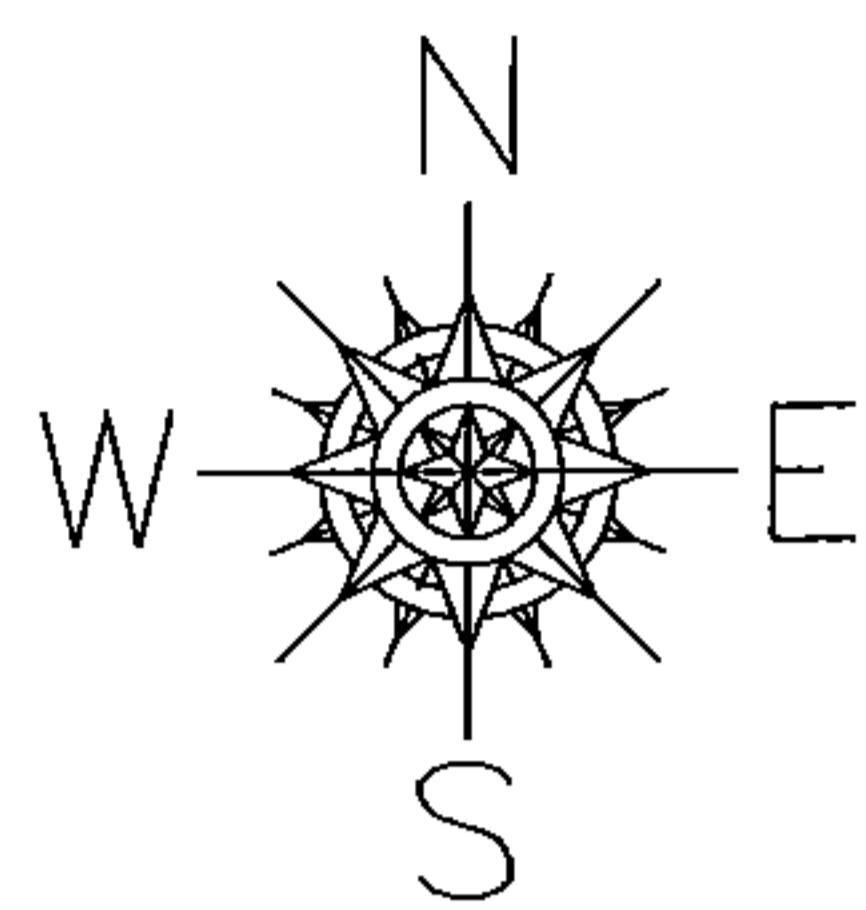



ACREAGE CORRECTION

12-00-033-000-054

~~5.36 A.~~

5.19 A.

CORR. PER SURV
NEFF & ASSOC.

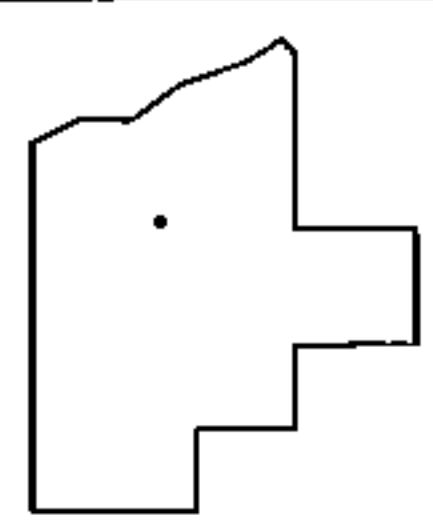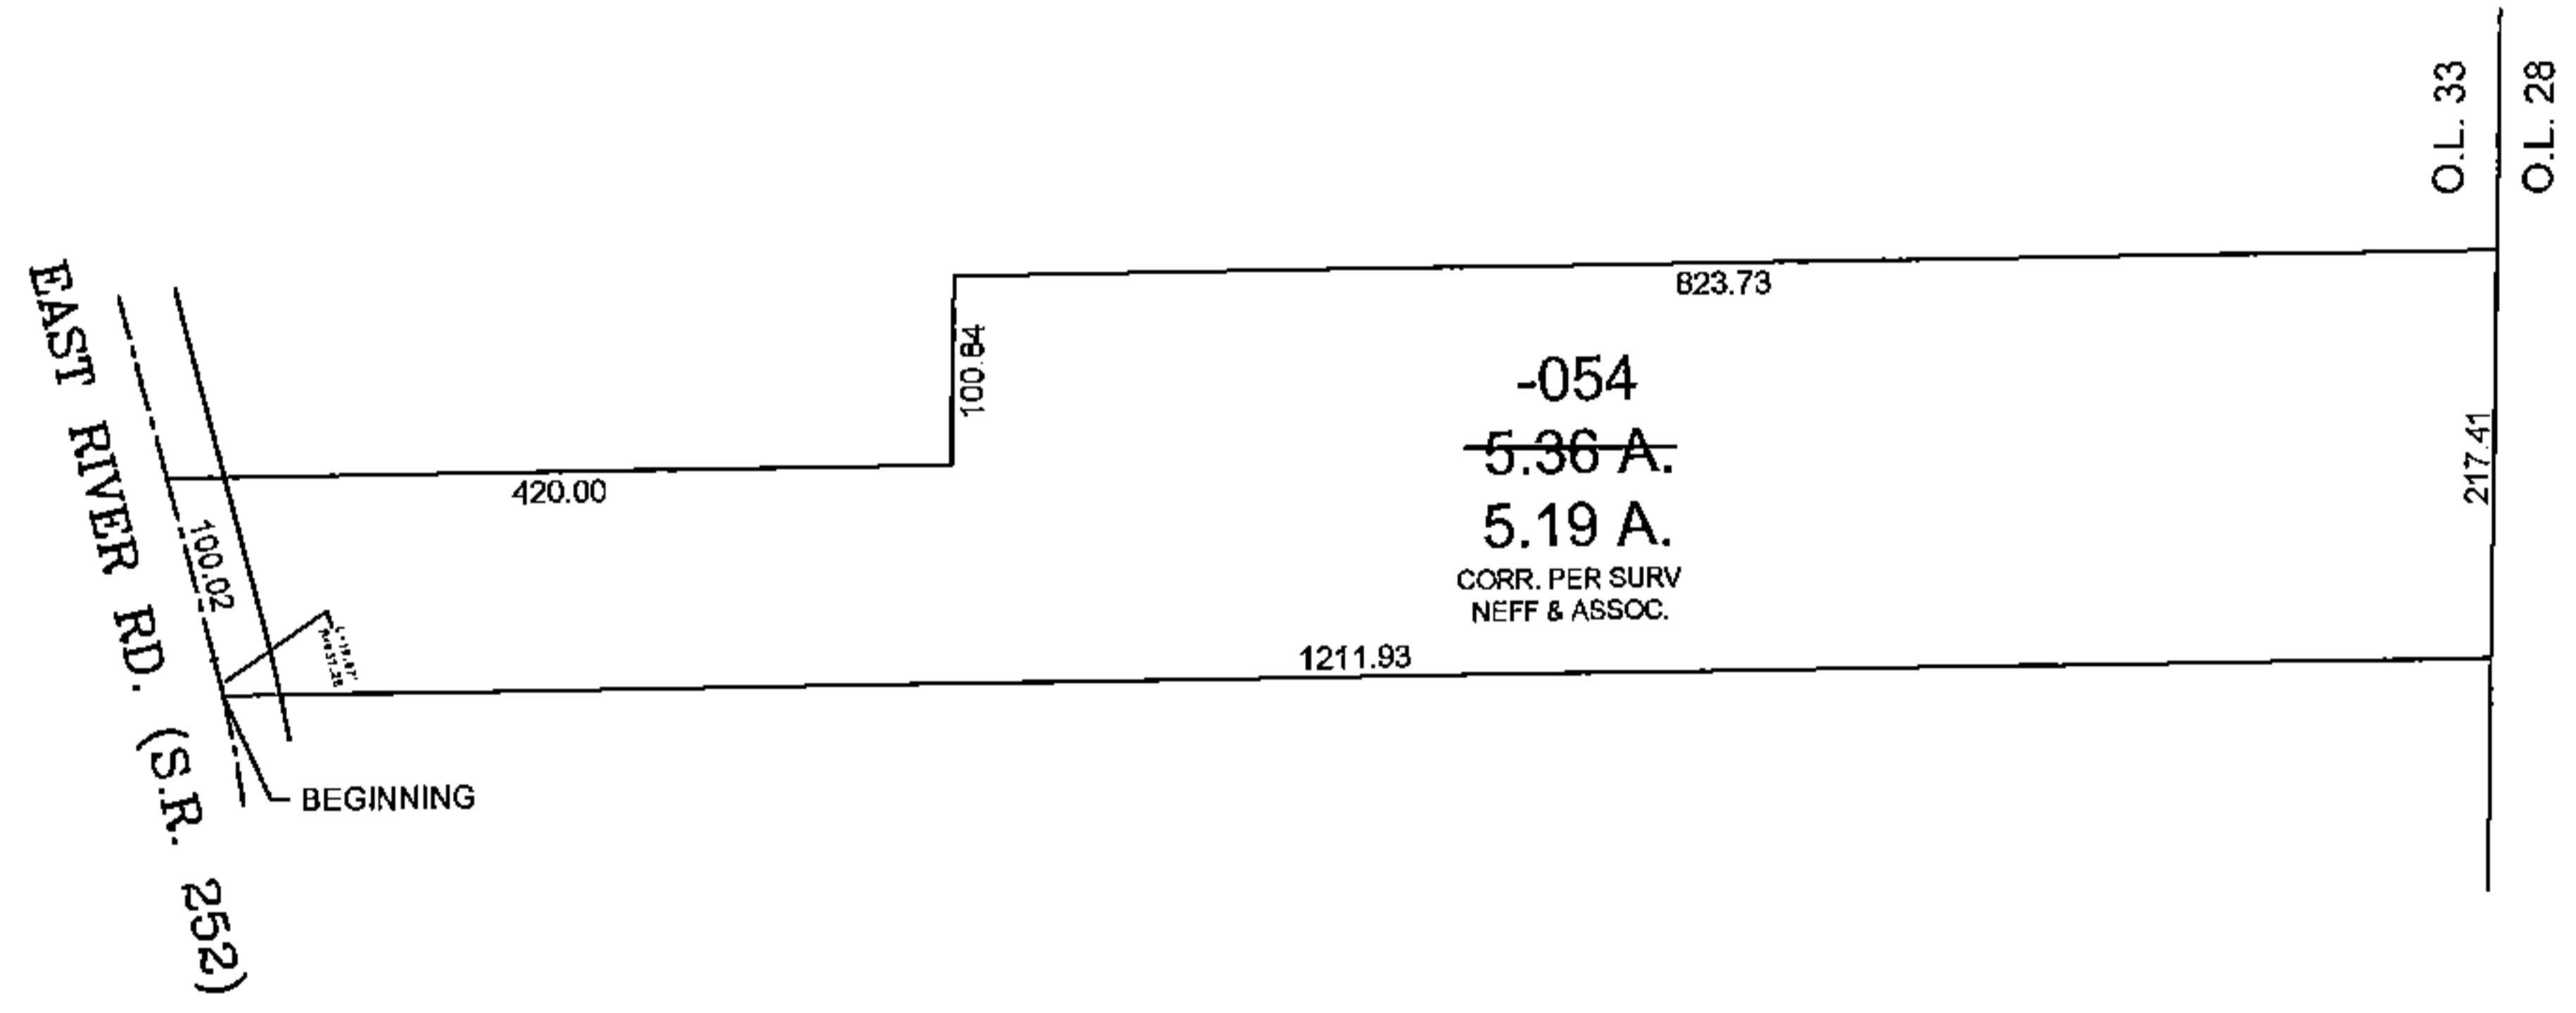

SPLITS/DEEDS PROCESSED
LORAIN COUNTY TAX MAP DEPARTMENT
226 MIDDLE AVE. ELYRIA, OHIO

SURVEYED BY: NEFF & ASSOC.
CLOSURE: 1 : 33,000
MAP PAGE(S): 12-00-033
APPROVED BY: TJS DATE: 1/20/16
SCALE: 1" = 200 PRIOR INSTRUMENT: DV XXXX/XXX