
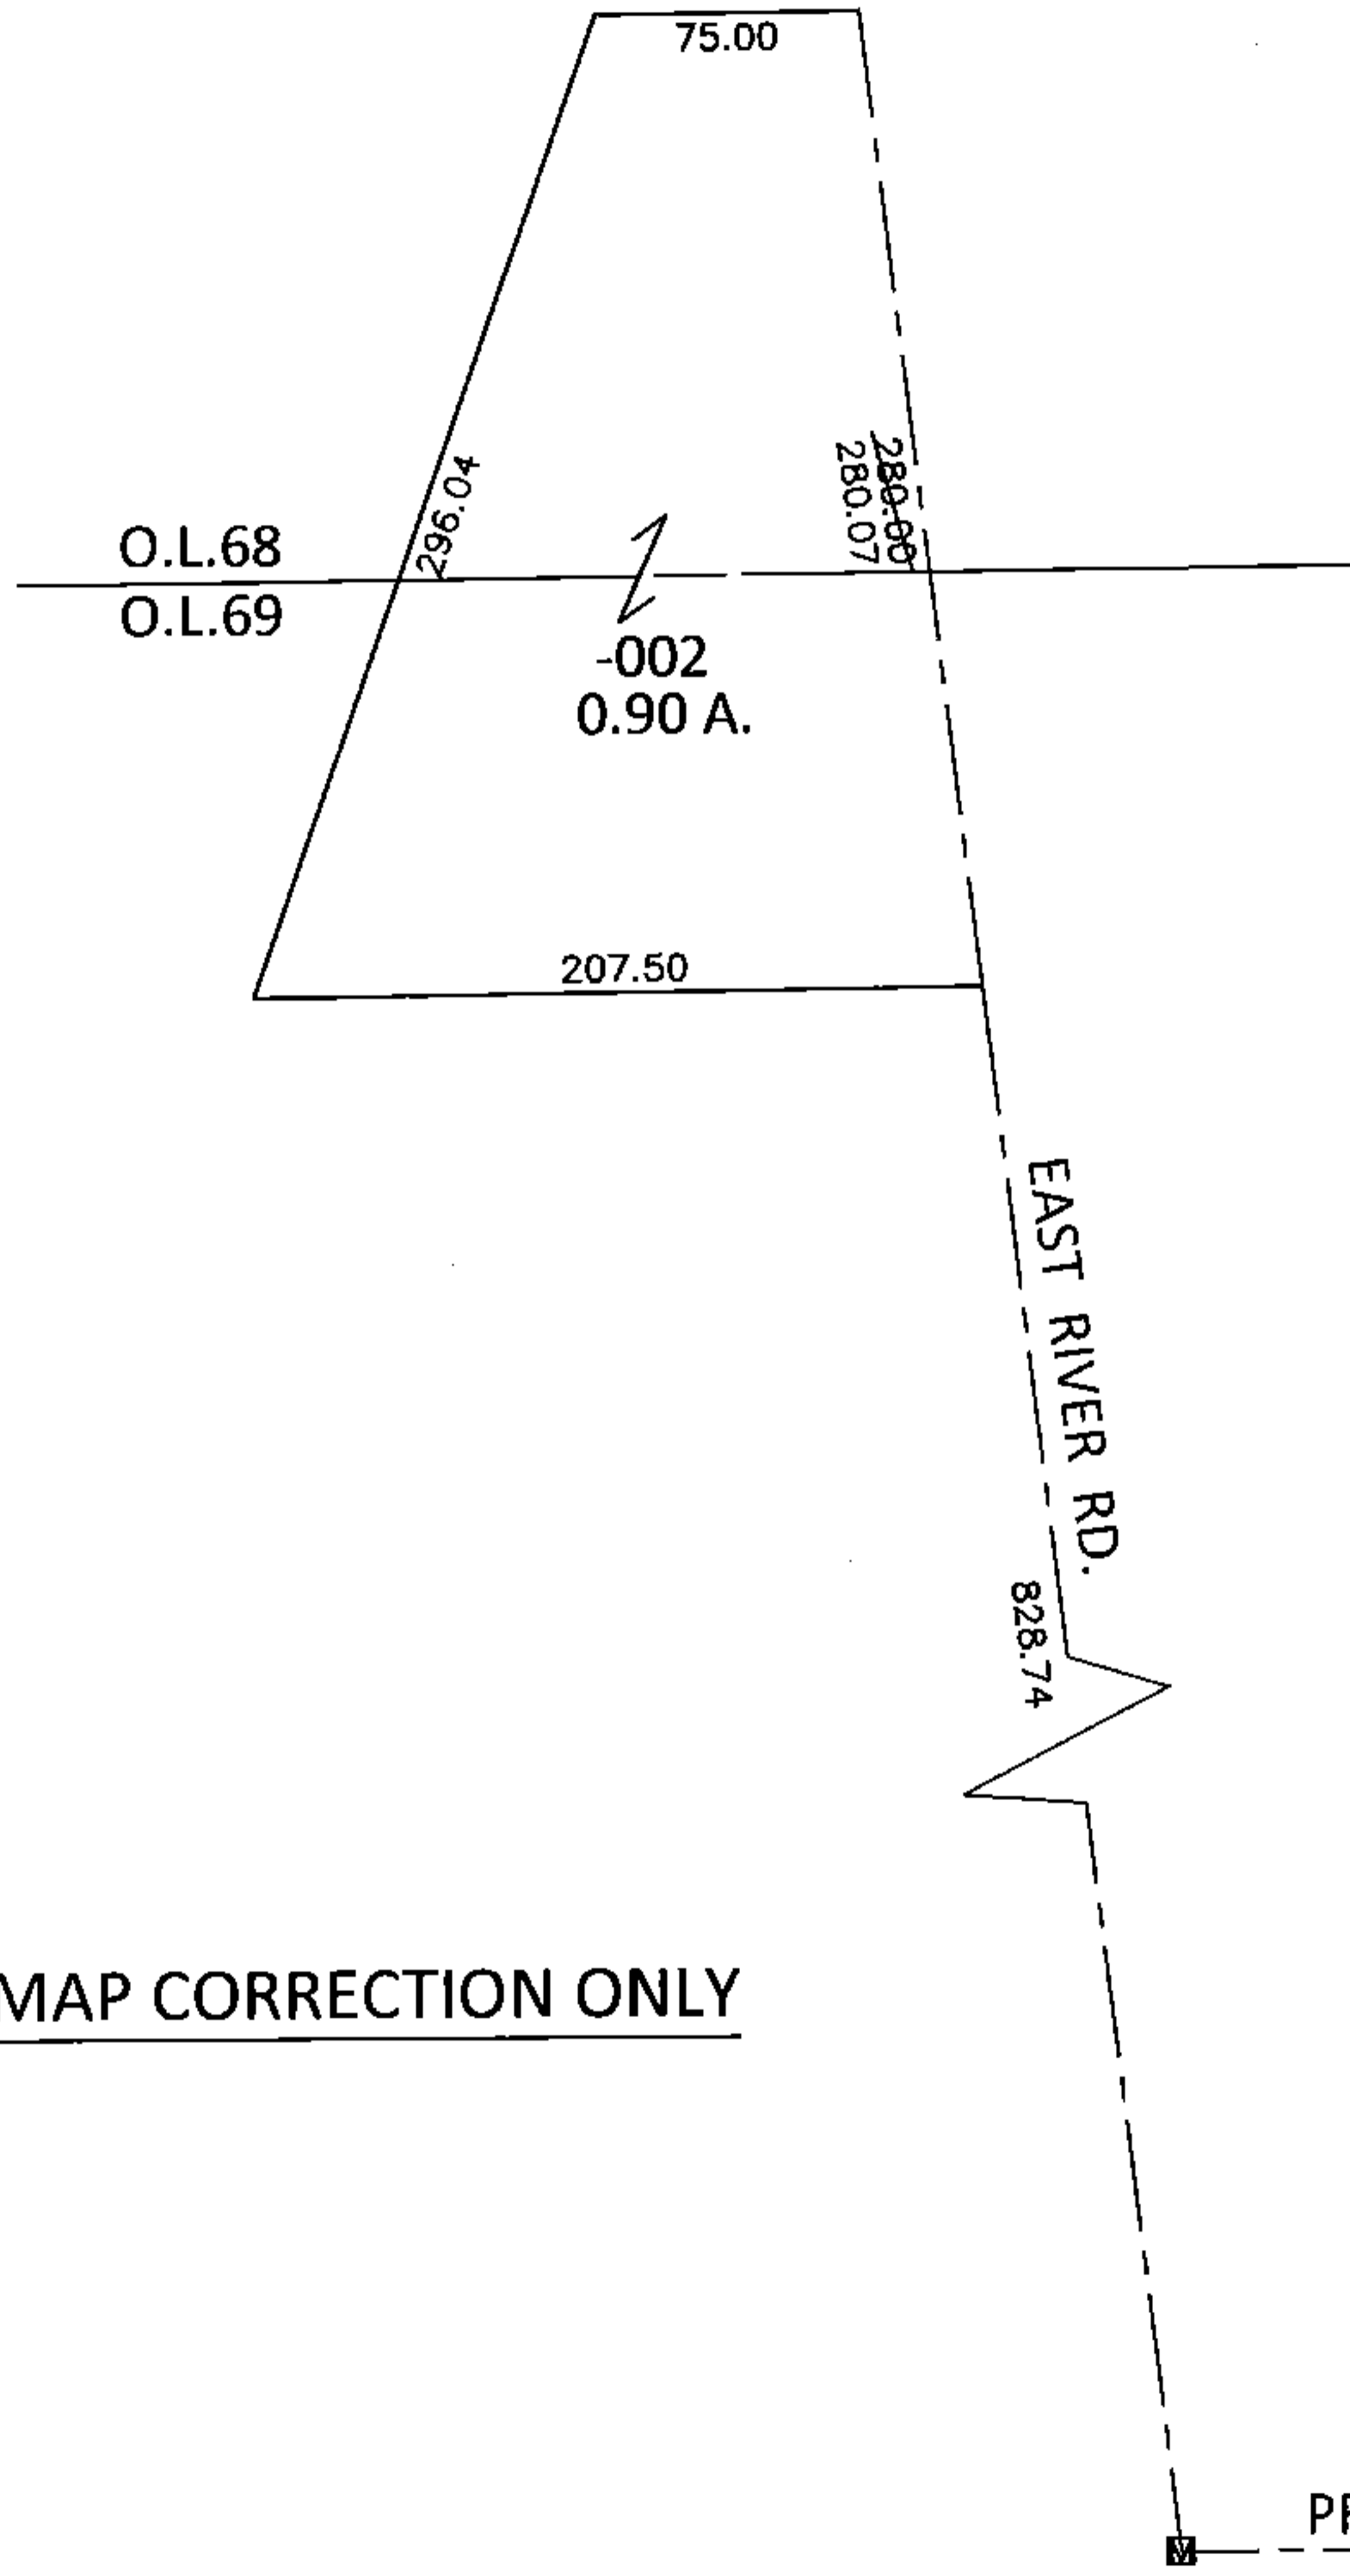


PARENT PARCEL: 03-00-069-000-002


CHILD PARCEL: _____

STARTING POINT: AT A MON BOX AT THE INTERSECTION OF C/L OF EAST RIVER RD. AND C/L OF PRESERVATION BLVD.

16-03364-D

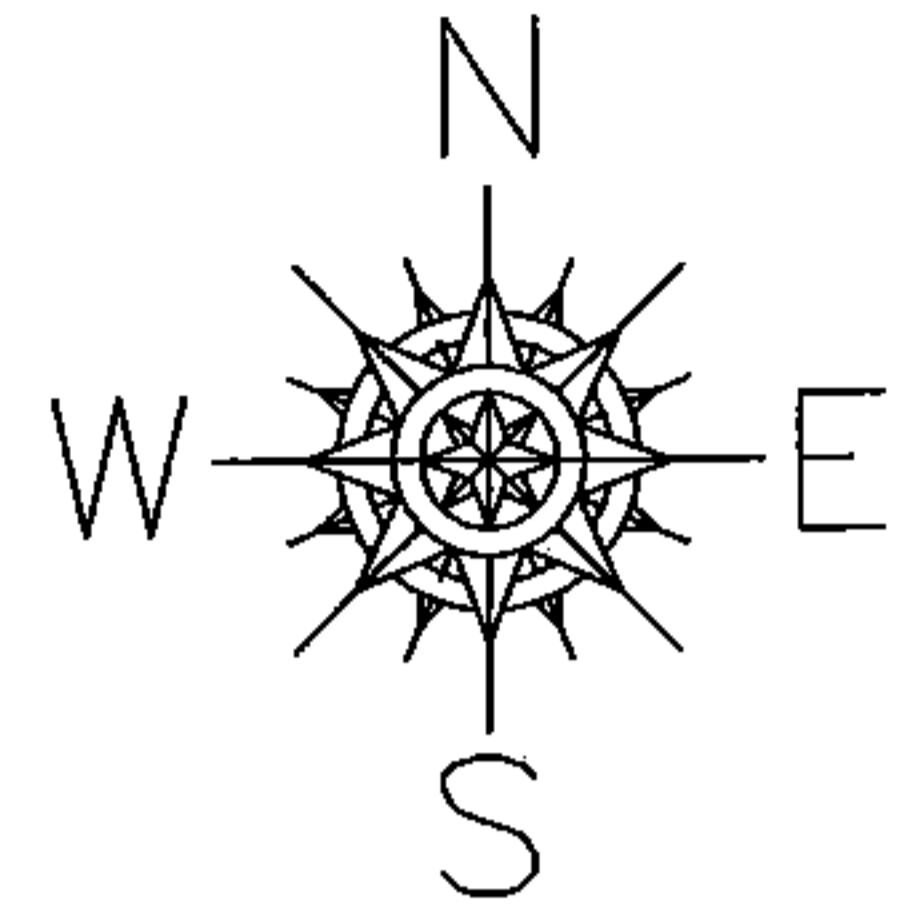

MAP CORRECTION ONLY

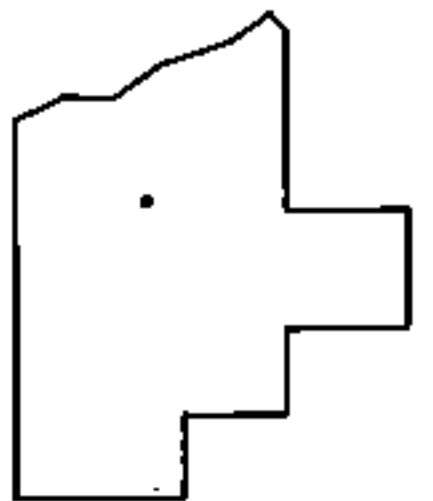

SPLITS/DEEDS PROCESSED

LORAIN COUNTY TAX MAP DEPARTMENT
226 MIDDLE AVE. ELYRIA, OHIO

SURVEYED BY: BRENT D. ANDERSON

CLOSURE: .01:10,000

MAP PAGE(S): 3-00-068-A

APPROVED BY: RRM DATE: 1-22-16

SCALE: 1"= 100 PRIOR INST.: 20140526010