

PARENT PARCEL: 07-00-025-102-012
 CHILD PARCEL: 07-00-025-102-059 & -060
 STARTING POINT: S/L 302 & S/L 303 HOME CREST PARK ALLOTMENT PV. 12 PG. 6

16-03365-U


UNCOMBINATION

~~07-00-025-102-012~~
~~50 X 130~~



07-00-025-102-059
 25.00 X 130.00

&

07-00-025-102-060
 25.00 X 130.00

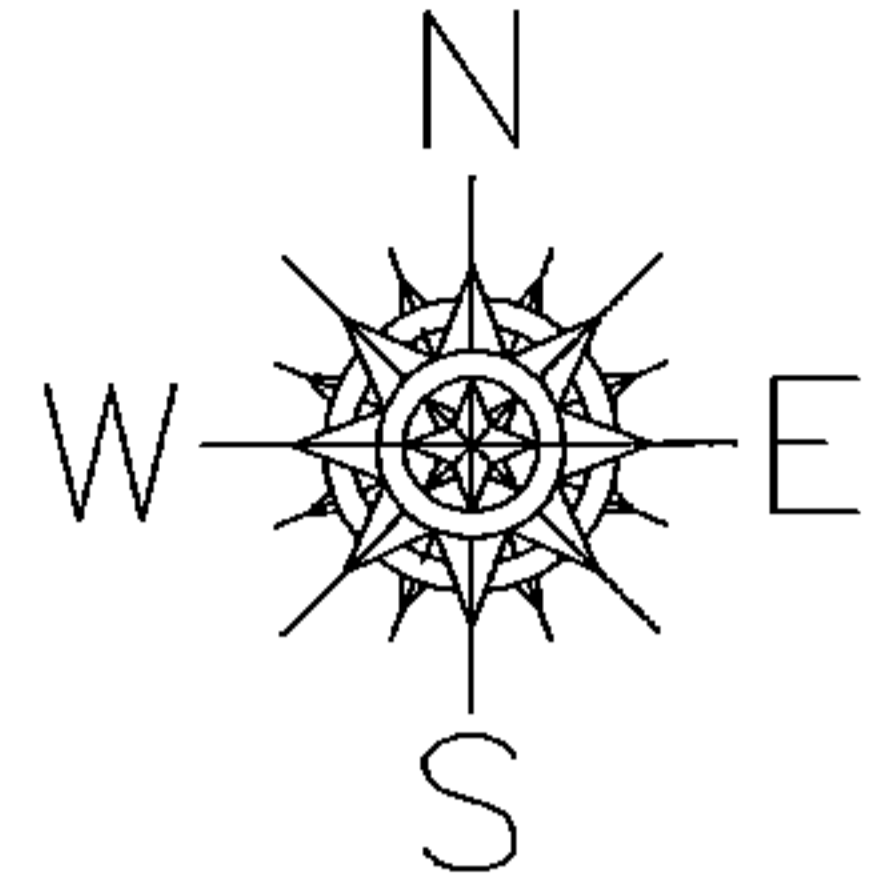

BROADWAY DR. 50'

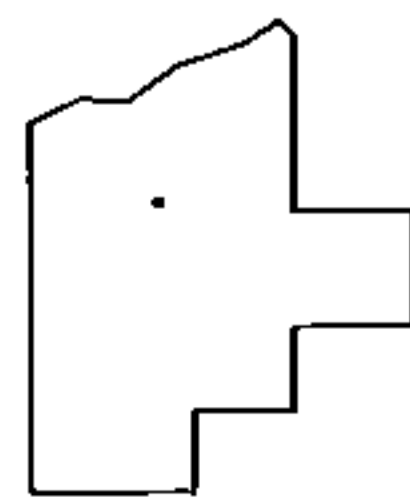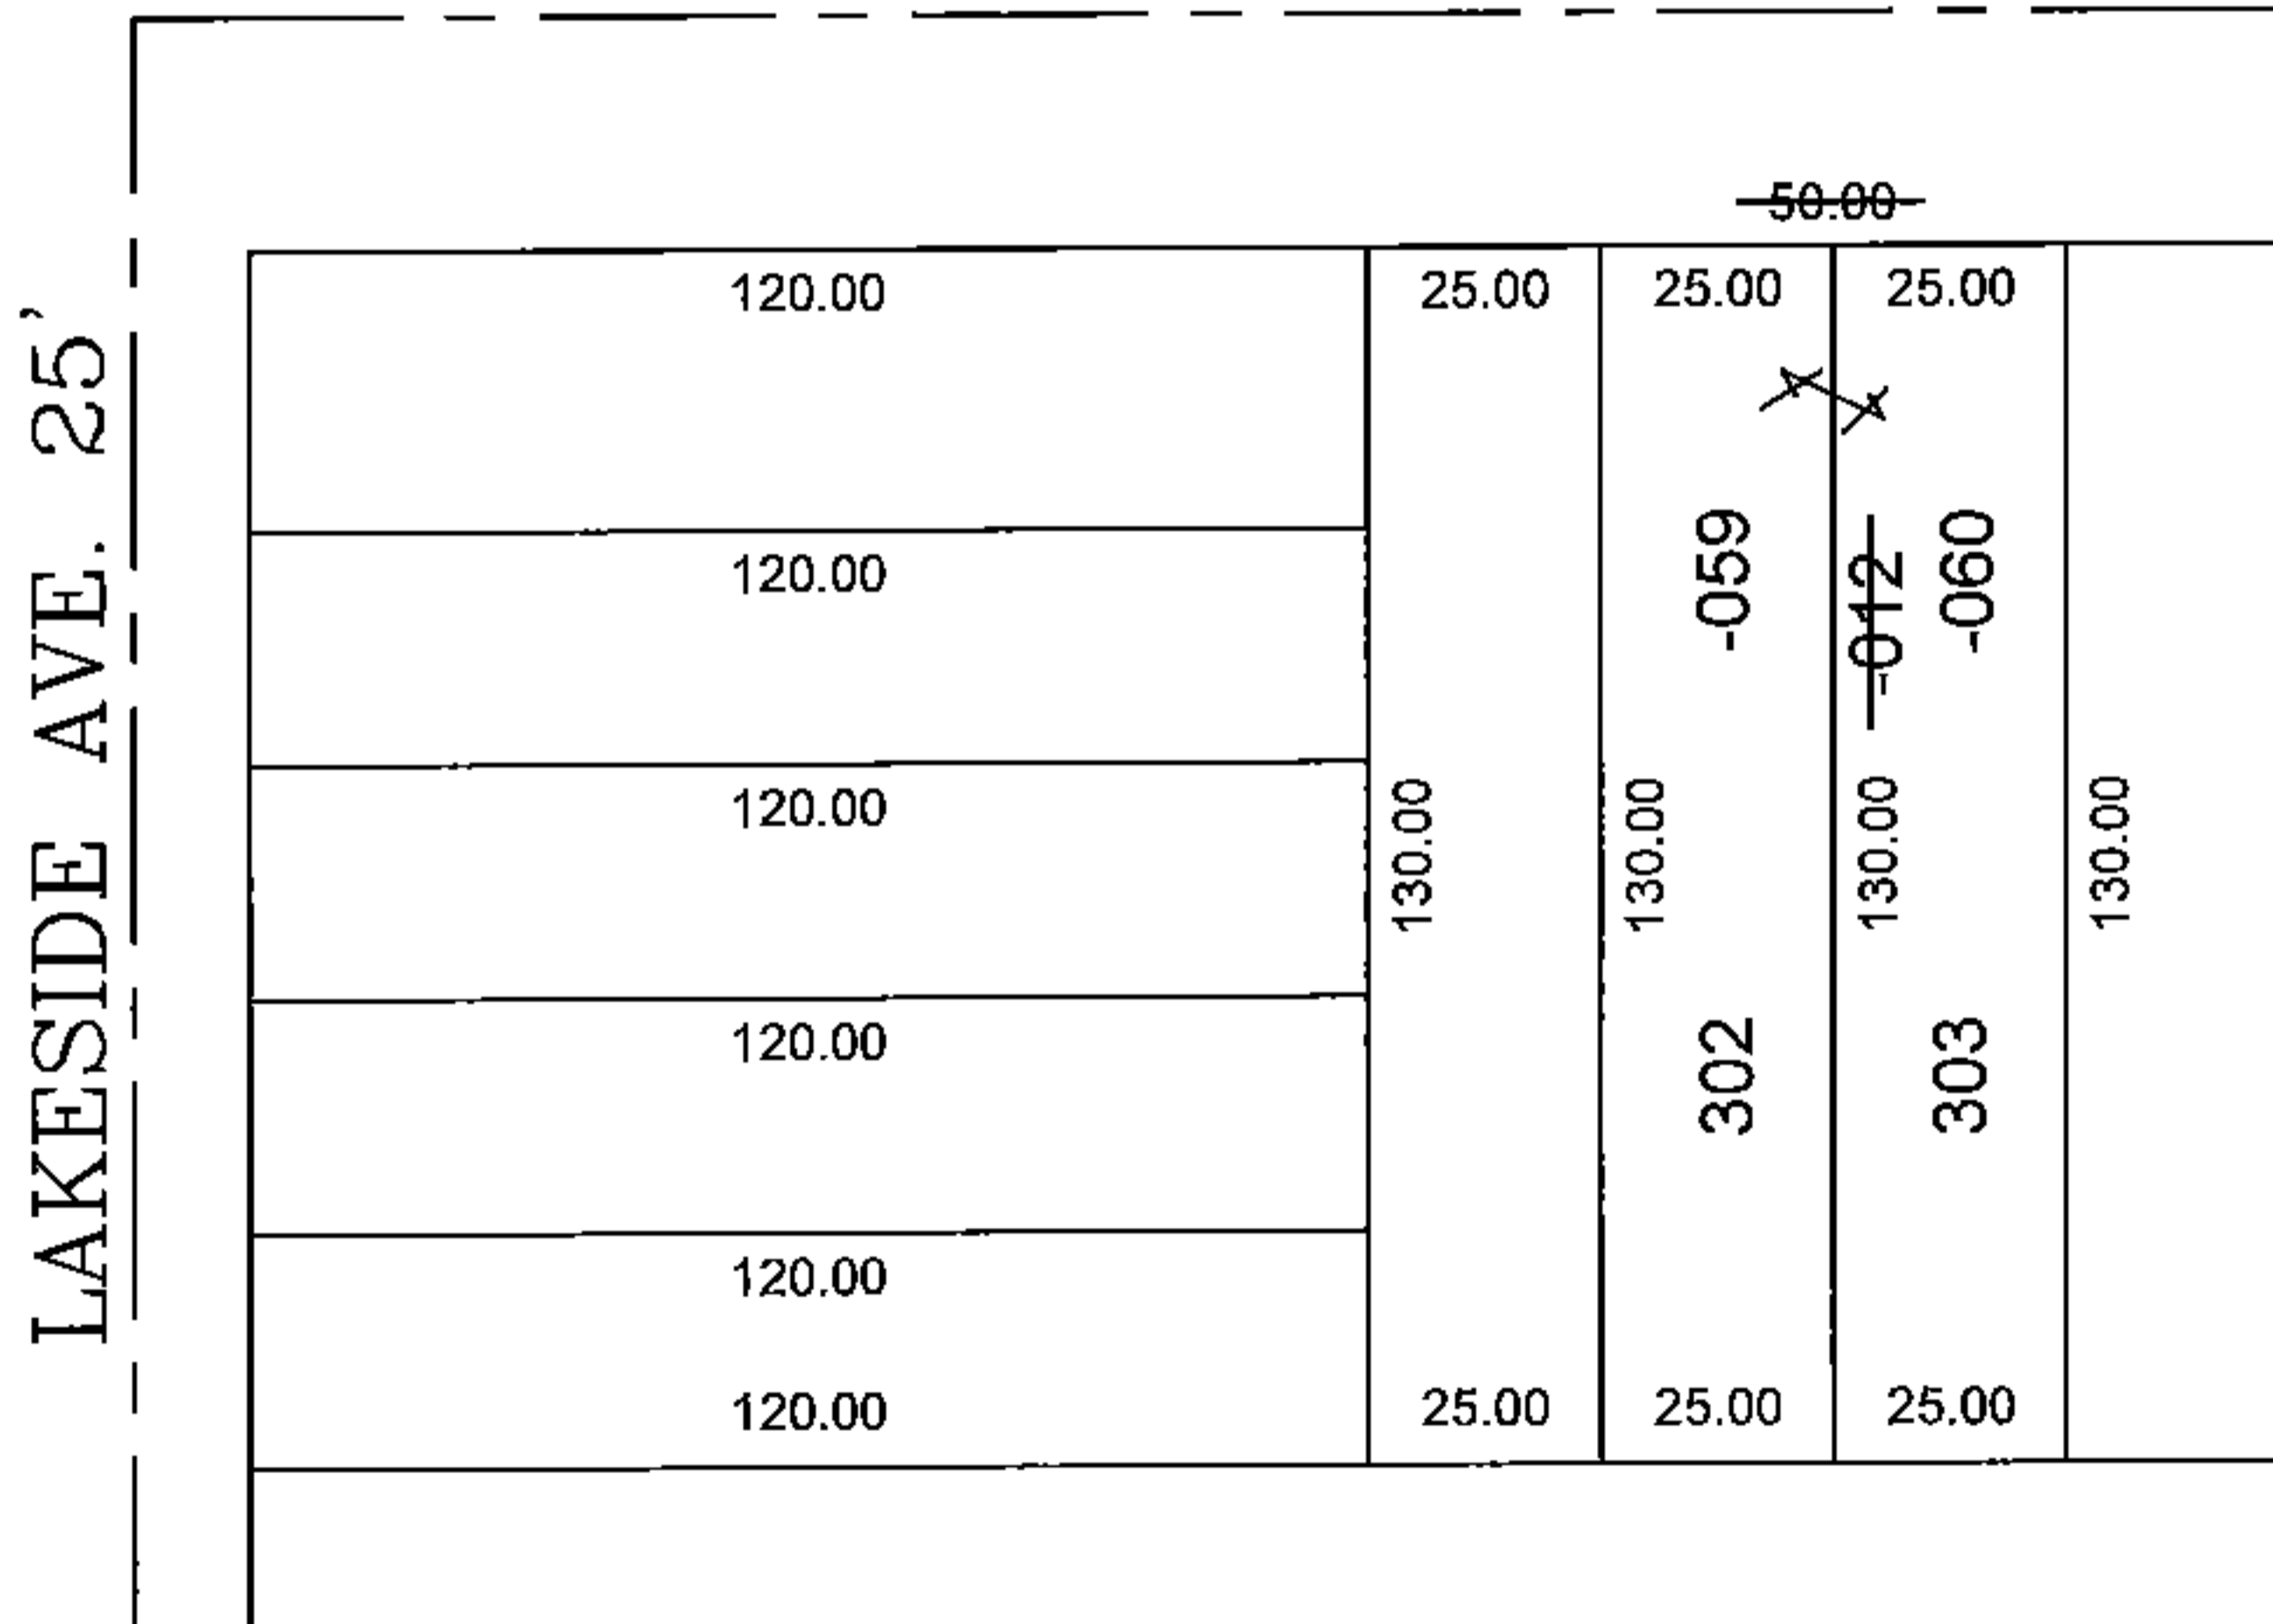

SPLITS/DEEDS PROCESSED

LORAIN COUNTY TAX MAP DEPARTMENT
 226 MIDDLE AVE. ELYRIA, OHIO

SURVEYED BY: J. W. WARDEN
 CLOSURE: 0.00 : 10.000
 MAP PAGE(S): 07-00-025
 APPROVED BY: TJS DATE: 1/20/16
 SCALE: 1"= 50' PRIOR INST.: DV 988/189