
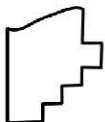


PARENT PARCEL: 11-00-025-000-032

CHILD PARCEL: N/A

STARTING POINT: OF ELYRIA-TWINSBURG RD & ST RT 82

16-03370-A

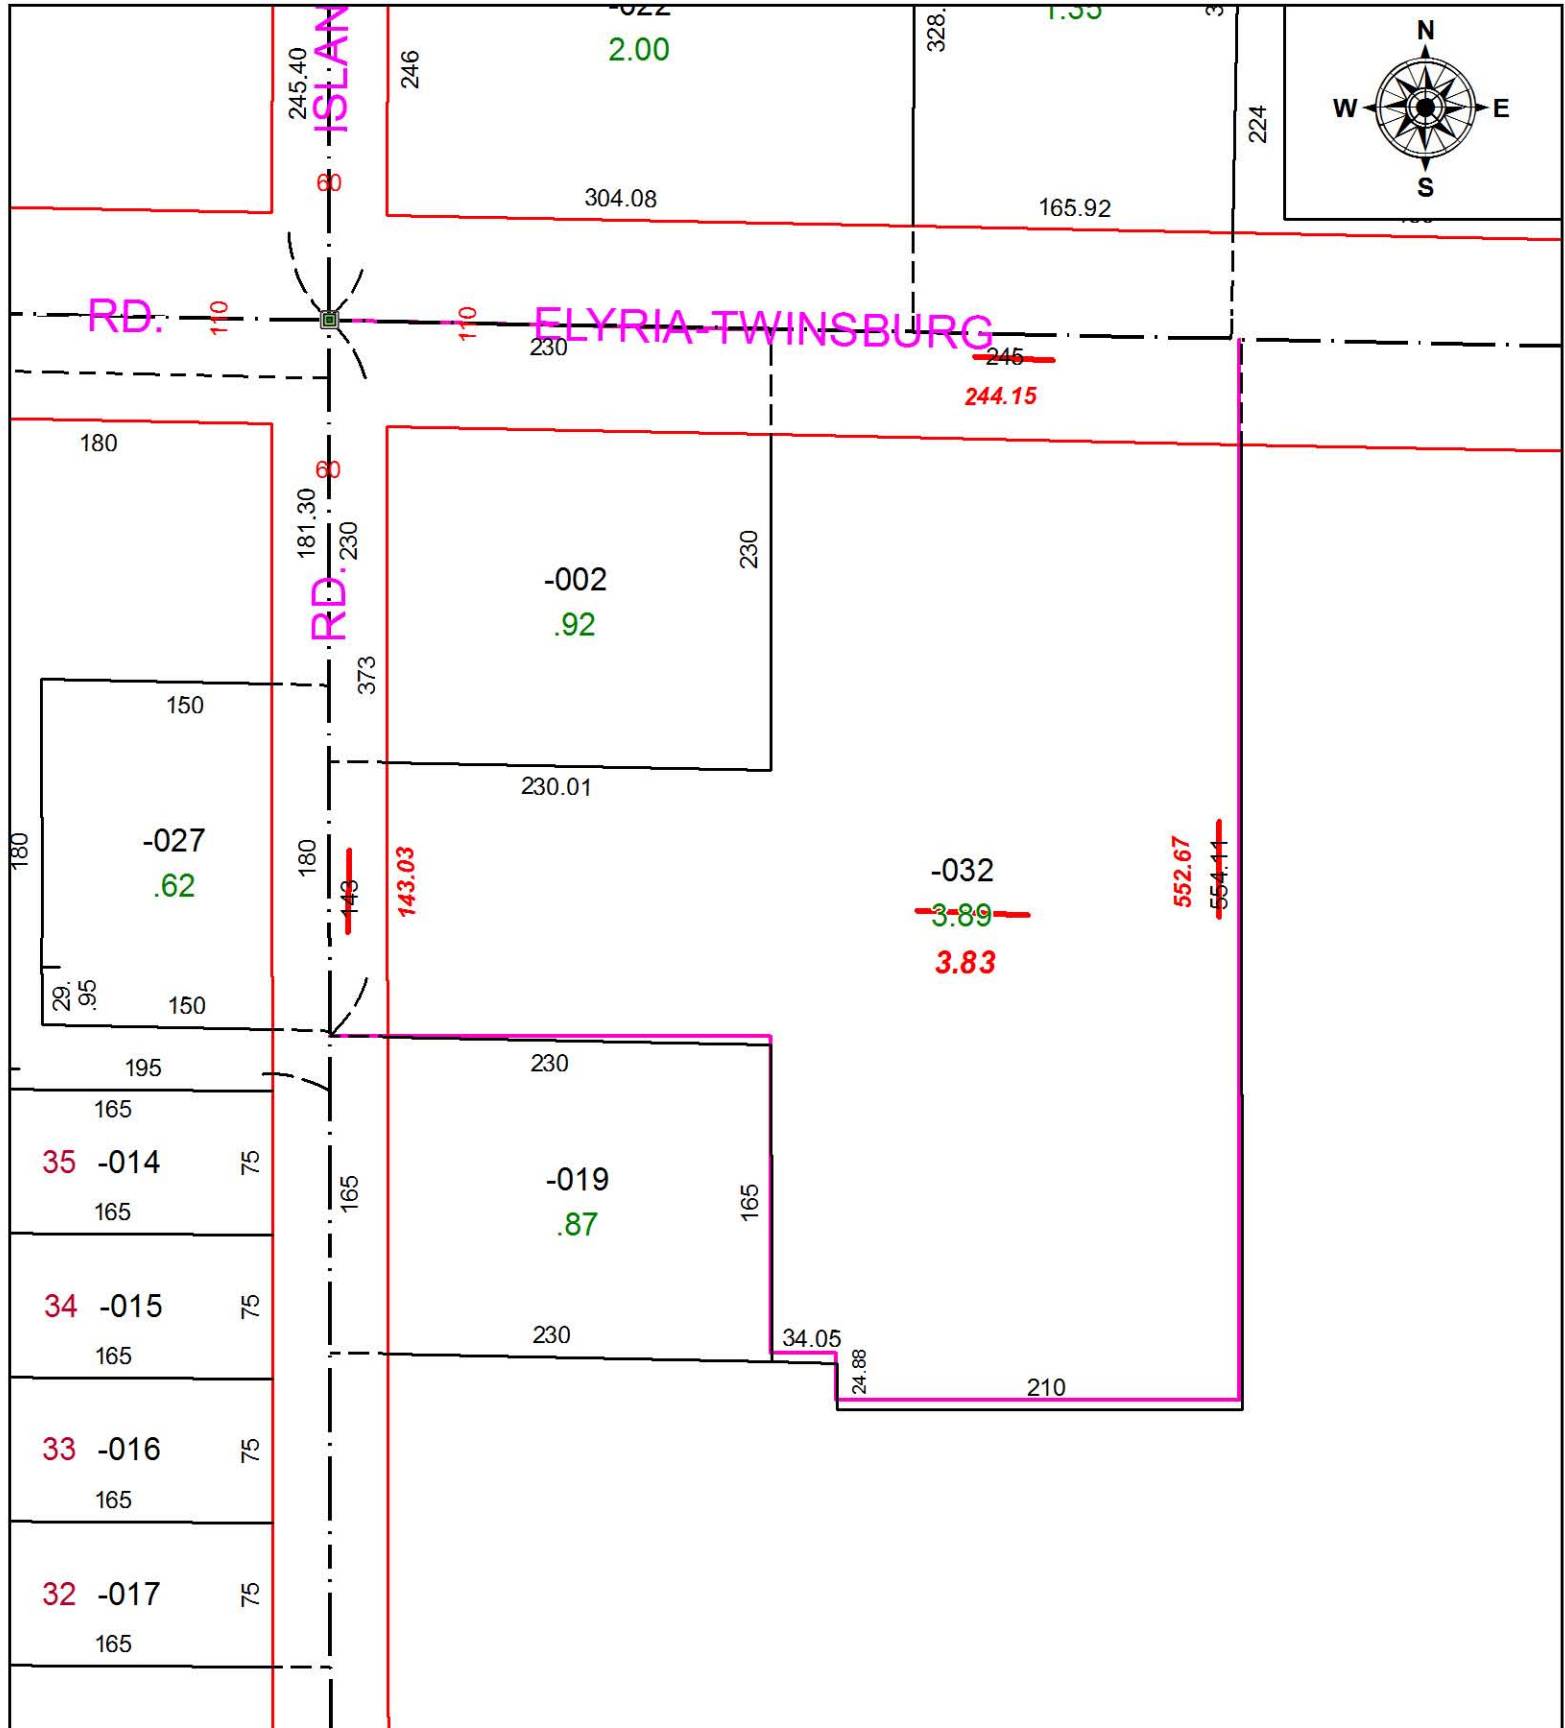

SPLITS/DEEDS PROCESSED
 LORAIN COUNTY TAX MAP DEPARTMENT
 226 MIDDLE AVE. ELYRIA, OH

SURVEYED BY: AMY KELLY
 CLOSURE: 1: 24,000
 MAP PAGE(S): 11-00-025-A
 APPROVED BY: JAH DATE: 1/29/2016
 SCALE: 1" = 100' PRIOR INSTRUMENT: 20150565926