
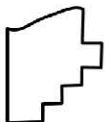
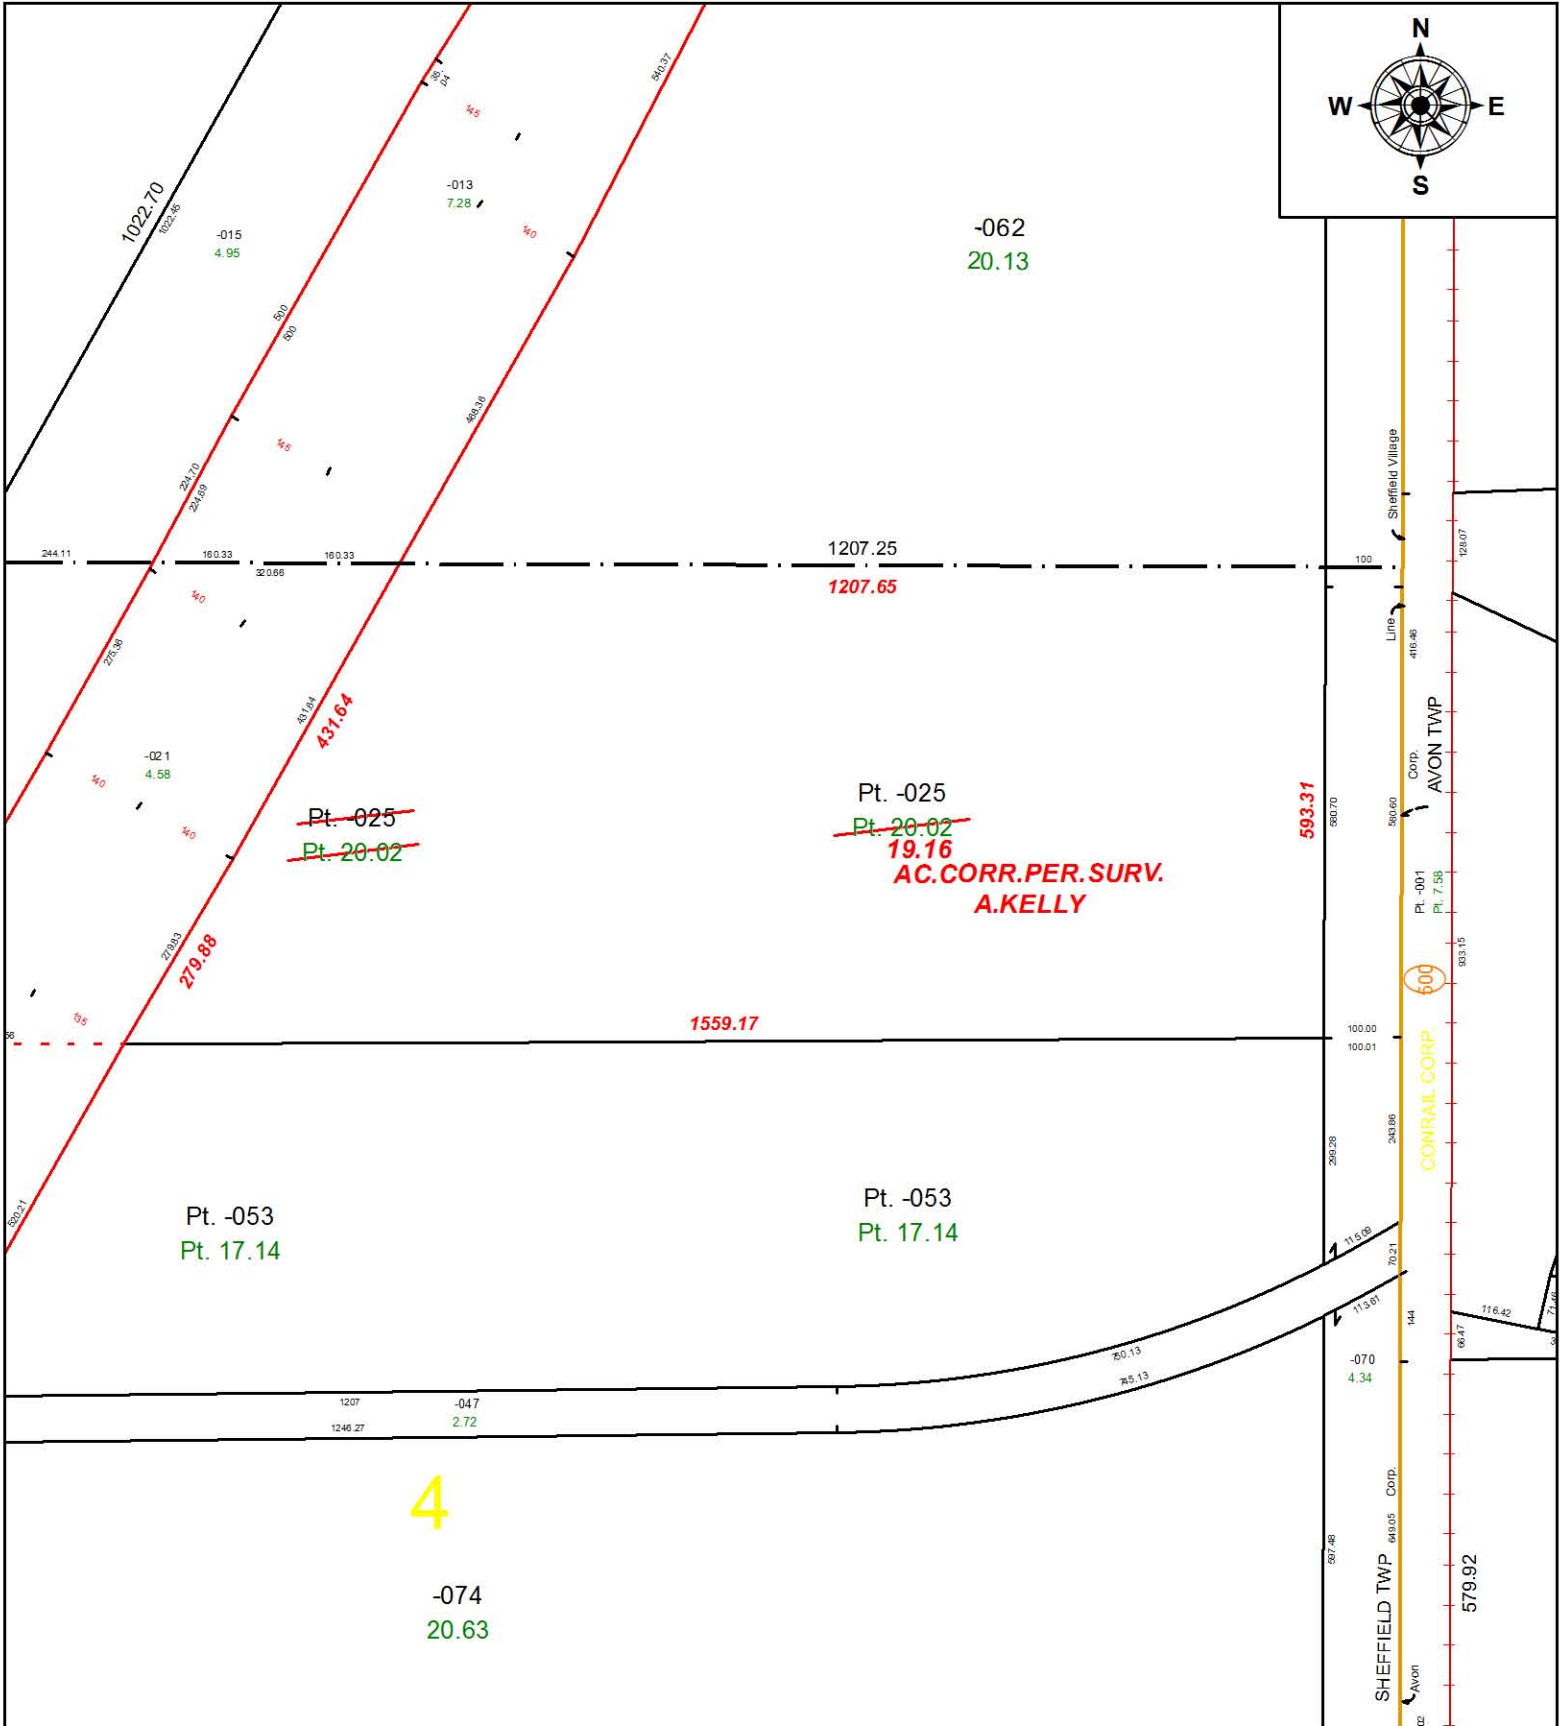


PARENT PARCEL: 03-00-004-000-025

CHILD PARCEL: XX-XX-XXX-XXX-XXX

STARTING POINT: INTERSECTION OF C/L OF FRENCH CREEK RD. AND EAST LINE OF O.L.4

16-03372-A

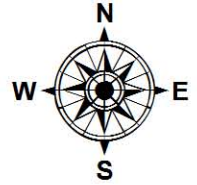

SPLITS/DEEDS PROCESSED
LORAIN COUNTY TAX MAP DEPARTMENT
226 MIDDLE AVE. ELYRIA, OH

SURVEYED BY: AMY M. KELLY
CLOSURE: 1: 576491
MAP PAGE(S): 3-L
APPROVED BY: RRM DATE: 2-1-16
SCALE: 1 in = 250 ft PRIOR INSTRUMENT: 1998056896